

RAIL FOR
ROODER
46.32

4.4.13
3.7.13
21.7.13

NUMERAL FOR RUDDER 46-62
SPEED 10 KNOTS

RUDDER

SCALE $\frac{3}{4}" = 1 \text{ FOOT}$ ✓

$\frac{13}{16}$ HOLES FOR $\frac{3}{4}$ RIVETS SPACED 5 DIAS¹ APART. ✓

PLATES · 26 ✓

✓ STERN FRAME

✓ SCALE $\frac{3}{4}" = 1 \text{ FOOT}$

✓ ¹⁷/₁₆ HOLES FOR 1" RIVETS 1 3/4" & 2" FROM

✓ INNER EDGE OF POST SPACED 5" APART

ENLARGED VIEW OF
8 STERN FRAME GUDGEON'S

CENTRE OF BOSS

ROUGH BORE

N^{OS} 284-5 233 & 237

RED 202 A
BLUE 237 "


C. B. 13
4. 4. 13
7. 7. 13

© 2020

Cook, Welton & Gemmell
nos. 284-5

Stem Frame & Rudder
for amended vessel.

* s/s 'Felix' Hull Rpt No. 27145
Bampton - - - 27202

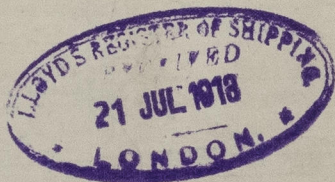

© 2020

D. 50. B.

Lloyd's Register
Foundation

006272-006280-0141