

10/7/17
19/7/17 (24672)

TABLE OF SPACING

NOTE - WHERE IT IS DESIRED TO USE $\frac{1}{8}$ RIVETS INSTEAD OF $\frac{3}{4}$ RIVETS THE SAME SPACING IN DIA^{RS} CAN BE ADOPTED.

[illegible]

TRACING-Nº 51403
23/6/1

SECTION AT BRACKET FLOOR
Solid Floors EVERY THIRD FRAME

DIMENSIONS - $400 \times 52 \text{ mL}^3 \times 31 \text{ mL}^3$ —


TO CLASS-100.A.I. LLOYDS REGISTER.

SCALE - $\frac{1}{2}'' = 1$ FOOT.

EQUIPMENT NUMBER.	
HULL 400 (52 + 31).	33200
COF. BRIDGE & FLE. 200 x 8 x 75.	1200
DECKHOUSE. 31.5 x 8 x 75.	189
	34589

EQUIPMENT

2. BOWER ANCHORS. 60 CMTS STOCKLESS.
1. " " 50¹/₂ " "
1 STREAM- 16¹/₂ " " EX STOCK.
1 KEDGE. " T " "
270 FATHOMS 21¹/₂ 3/16" LINK CHAIN CABLE.
50 " 1 1/2" STREAM CHAIN OR 4 1/2" S.W. ROPE
120 " 14" HEMP HAWSEY OR 4 1/2" " "
2 OFF 30 " 8" HEMP HAWSEYS OR 2 1/2" " "
2 OFF 30 " T " WARPS OR 2 1/2" " "

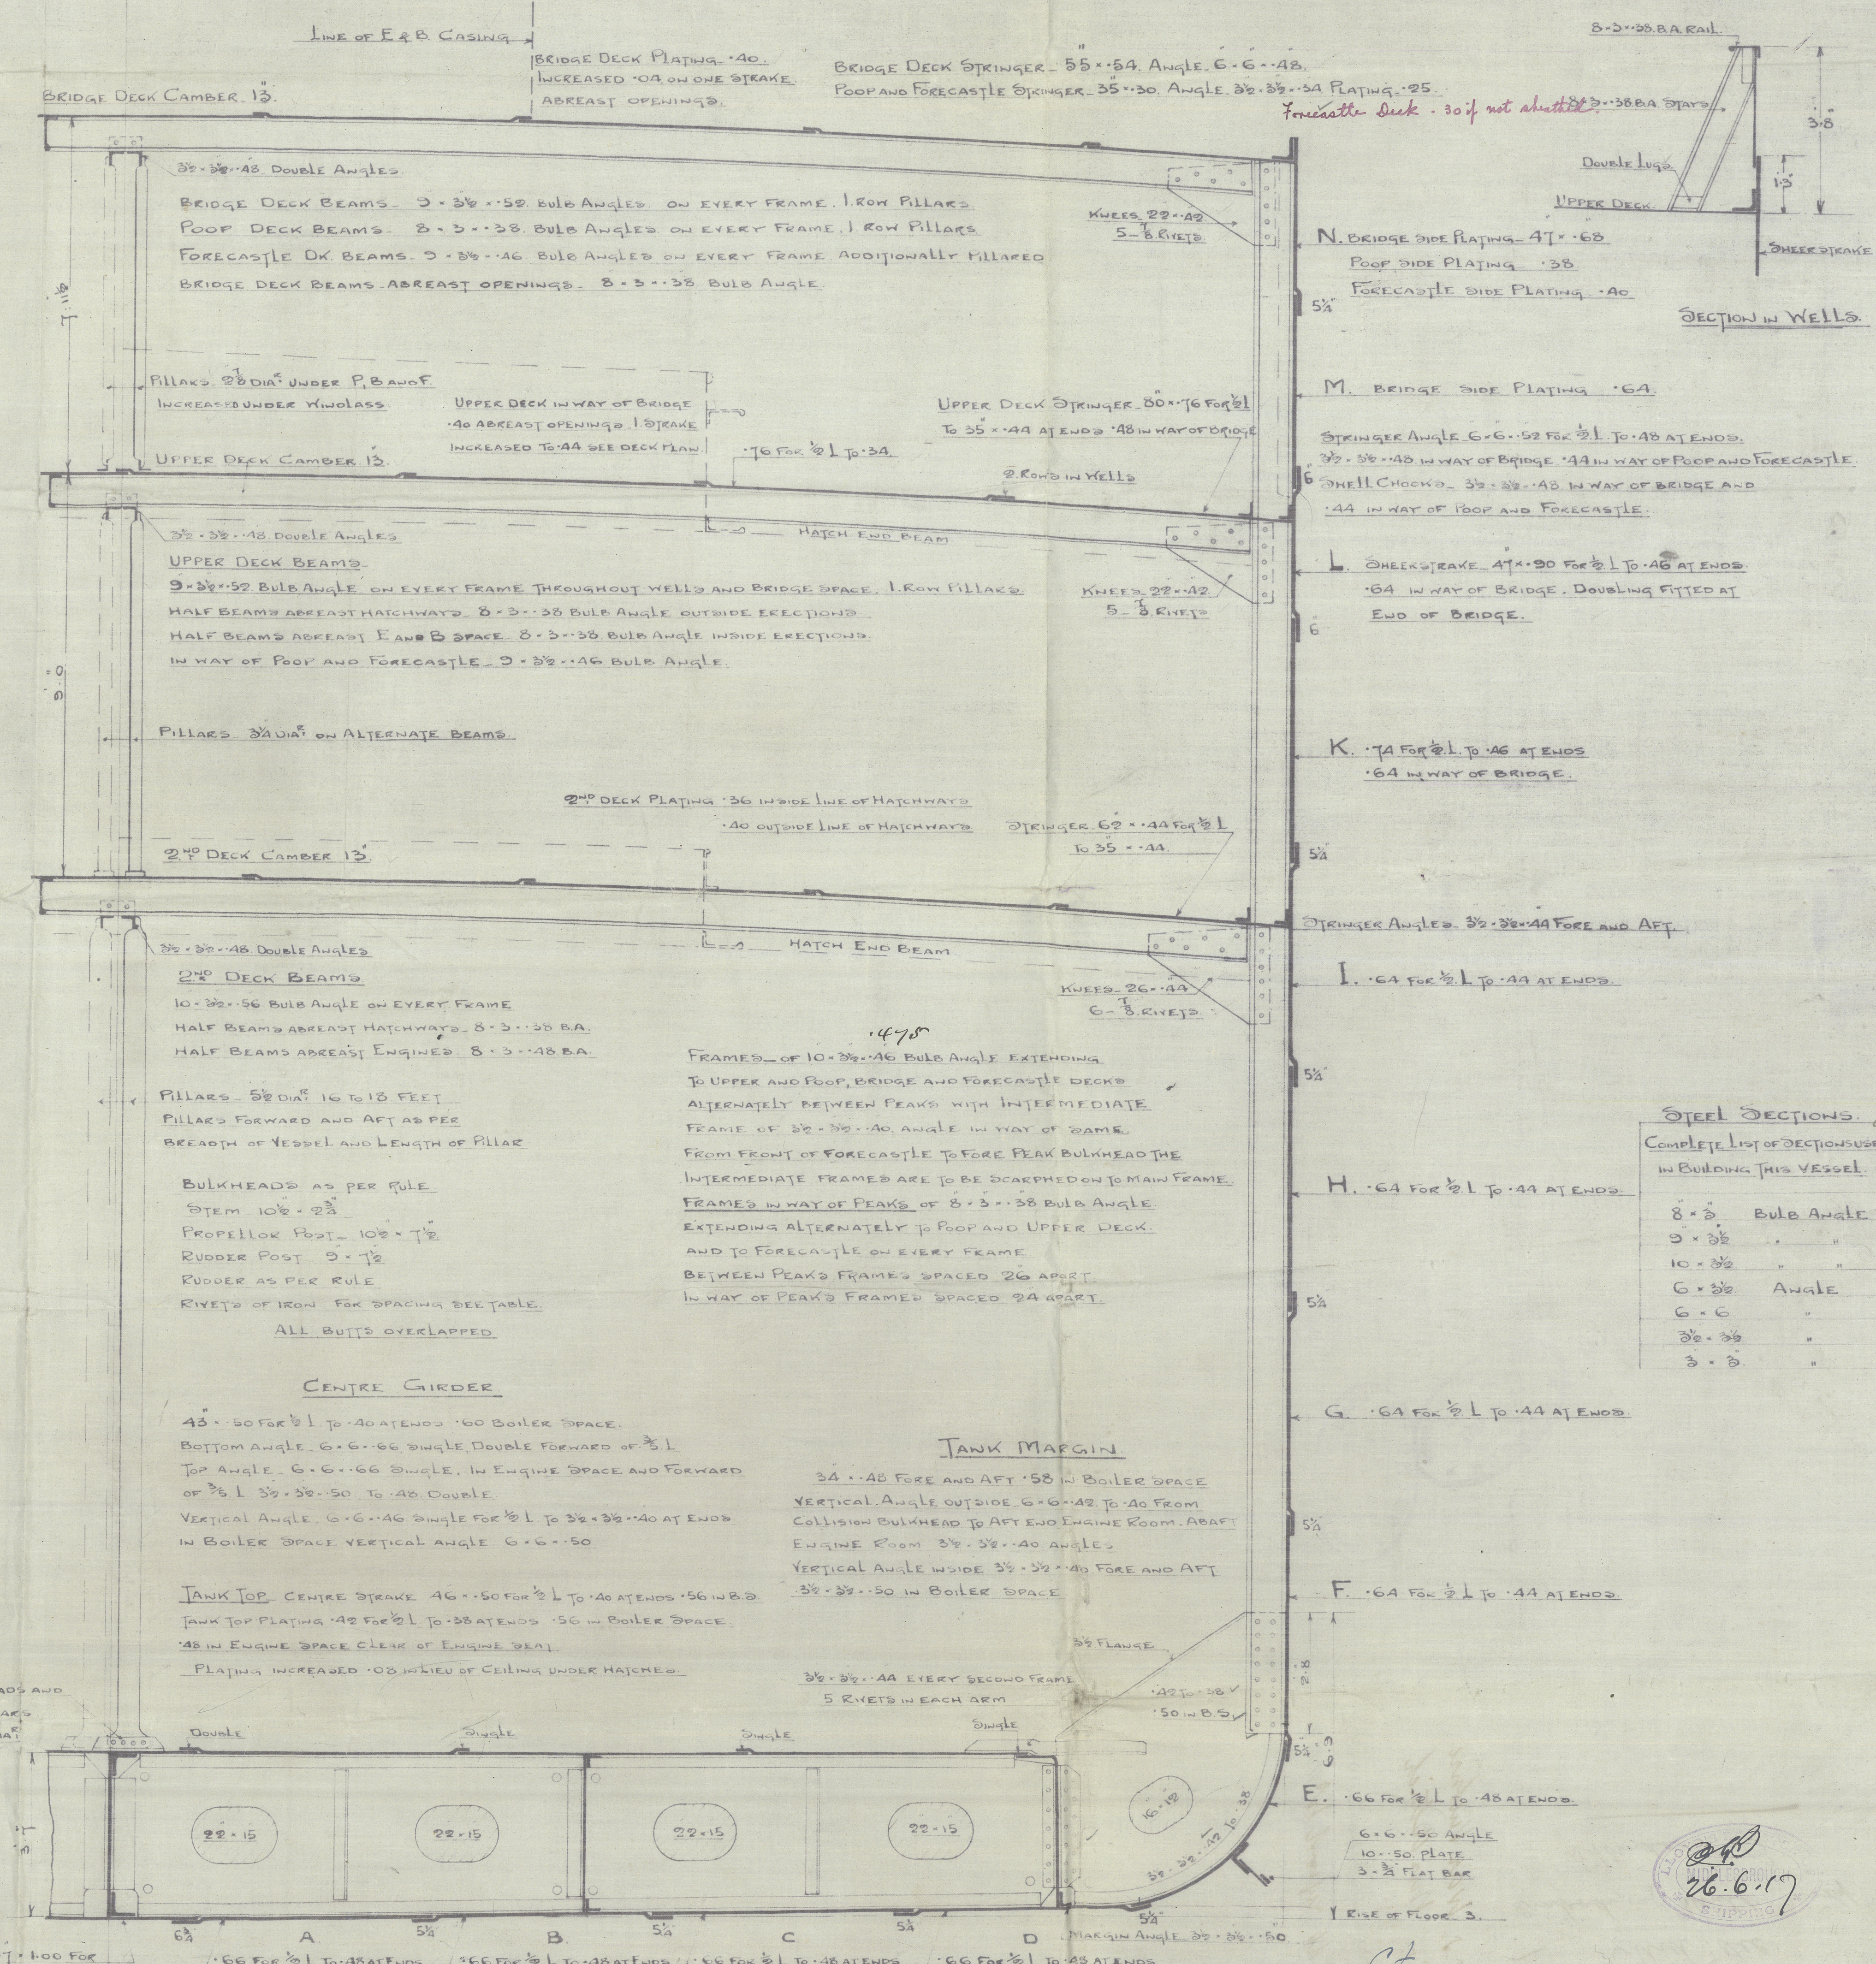

STEEL SECTIONS. ✓
COMPLETE LIST OF SECTIONS USED
IN BUILDING THIS VESSEL.

8×3 BULB ANGLE
 $9 \times 3\frac{1}{2}$ " "
 $10 \times 3\frac{1}{2}$ " "
 $6 \times 3\frac{1}{2}$ ANGLE
 6×6 "
 $3\frac{1}{2} \times 3\frac{1}{2}$ "
 3×3 "

FLAT PLATE KEEL 47×1.00 FOR
 $\frac{3}{5} L$ TO $.70$ AT ENDS

NOTE - 3. STRAKES OF PLATING TO HAVE MIDSHIP THICKNESS
CARRIED FORWARD TO COLLISION BULKHEAD.

Ct.
30.6.17

Nº 671 © 2020
Lloyd's Register Foundation

Messrs Richardson Buck & Co

W 671, 672

Mid: Dec

Embroidering Builders marks.

Standard B






W 671. S.S. War Vulture

W 672. S.S. War Atchik

Middlebrough Report 10132

W 672. M. Report No 10183.

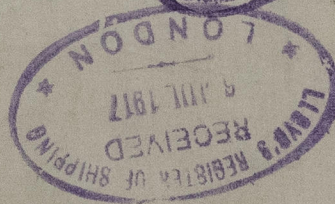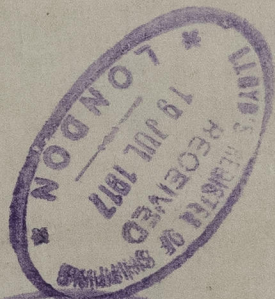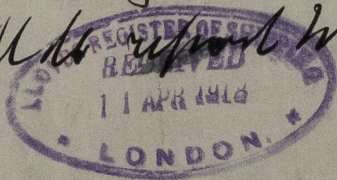

© 2020

Lloyd's Register
Foundation