

8. 11. 04

NUMERALS	
1 ST CIRTH	18.416
2 ND DEPTH	12.5
3 RD BREADTH	10.5
4 TH 1 ST NO	41.416
5 TH LENGTH	108.875
6 TH 2 ND NO	4509.167

S.S. No 75. MIDSHIP SECTION. STEEL SCREW FLEETER.

DIMS. 110'-0" BP. x 21'-0" x 12'-0" ML



SCALE $\frac{1}{2}$ " = 1 FT

TO CLASS 100 A1. LLOYDS



EQUIPMENT No = 4509.

ANCHOR	4 $\frac{3}{4}$ CWTs EX STOCK
1	44
1	2 $\frac{1}{2}$
90 FATHOMS	$\frac{15}{16}$ STUD LINK CHAIN.
60	5 $\frac{1}{2}$ HAWSER.
60	4 WARP.

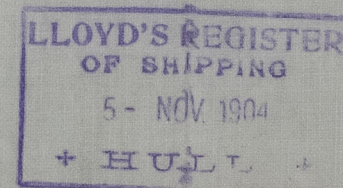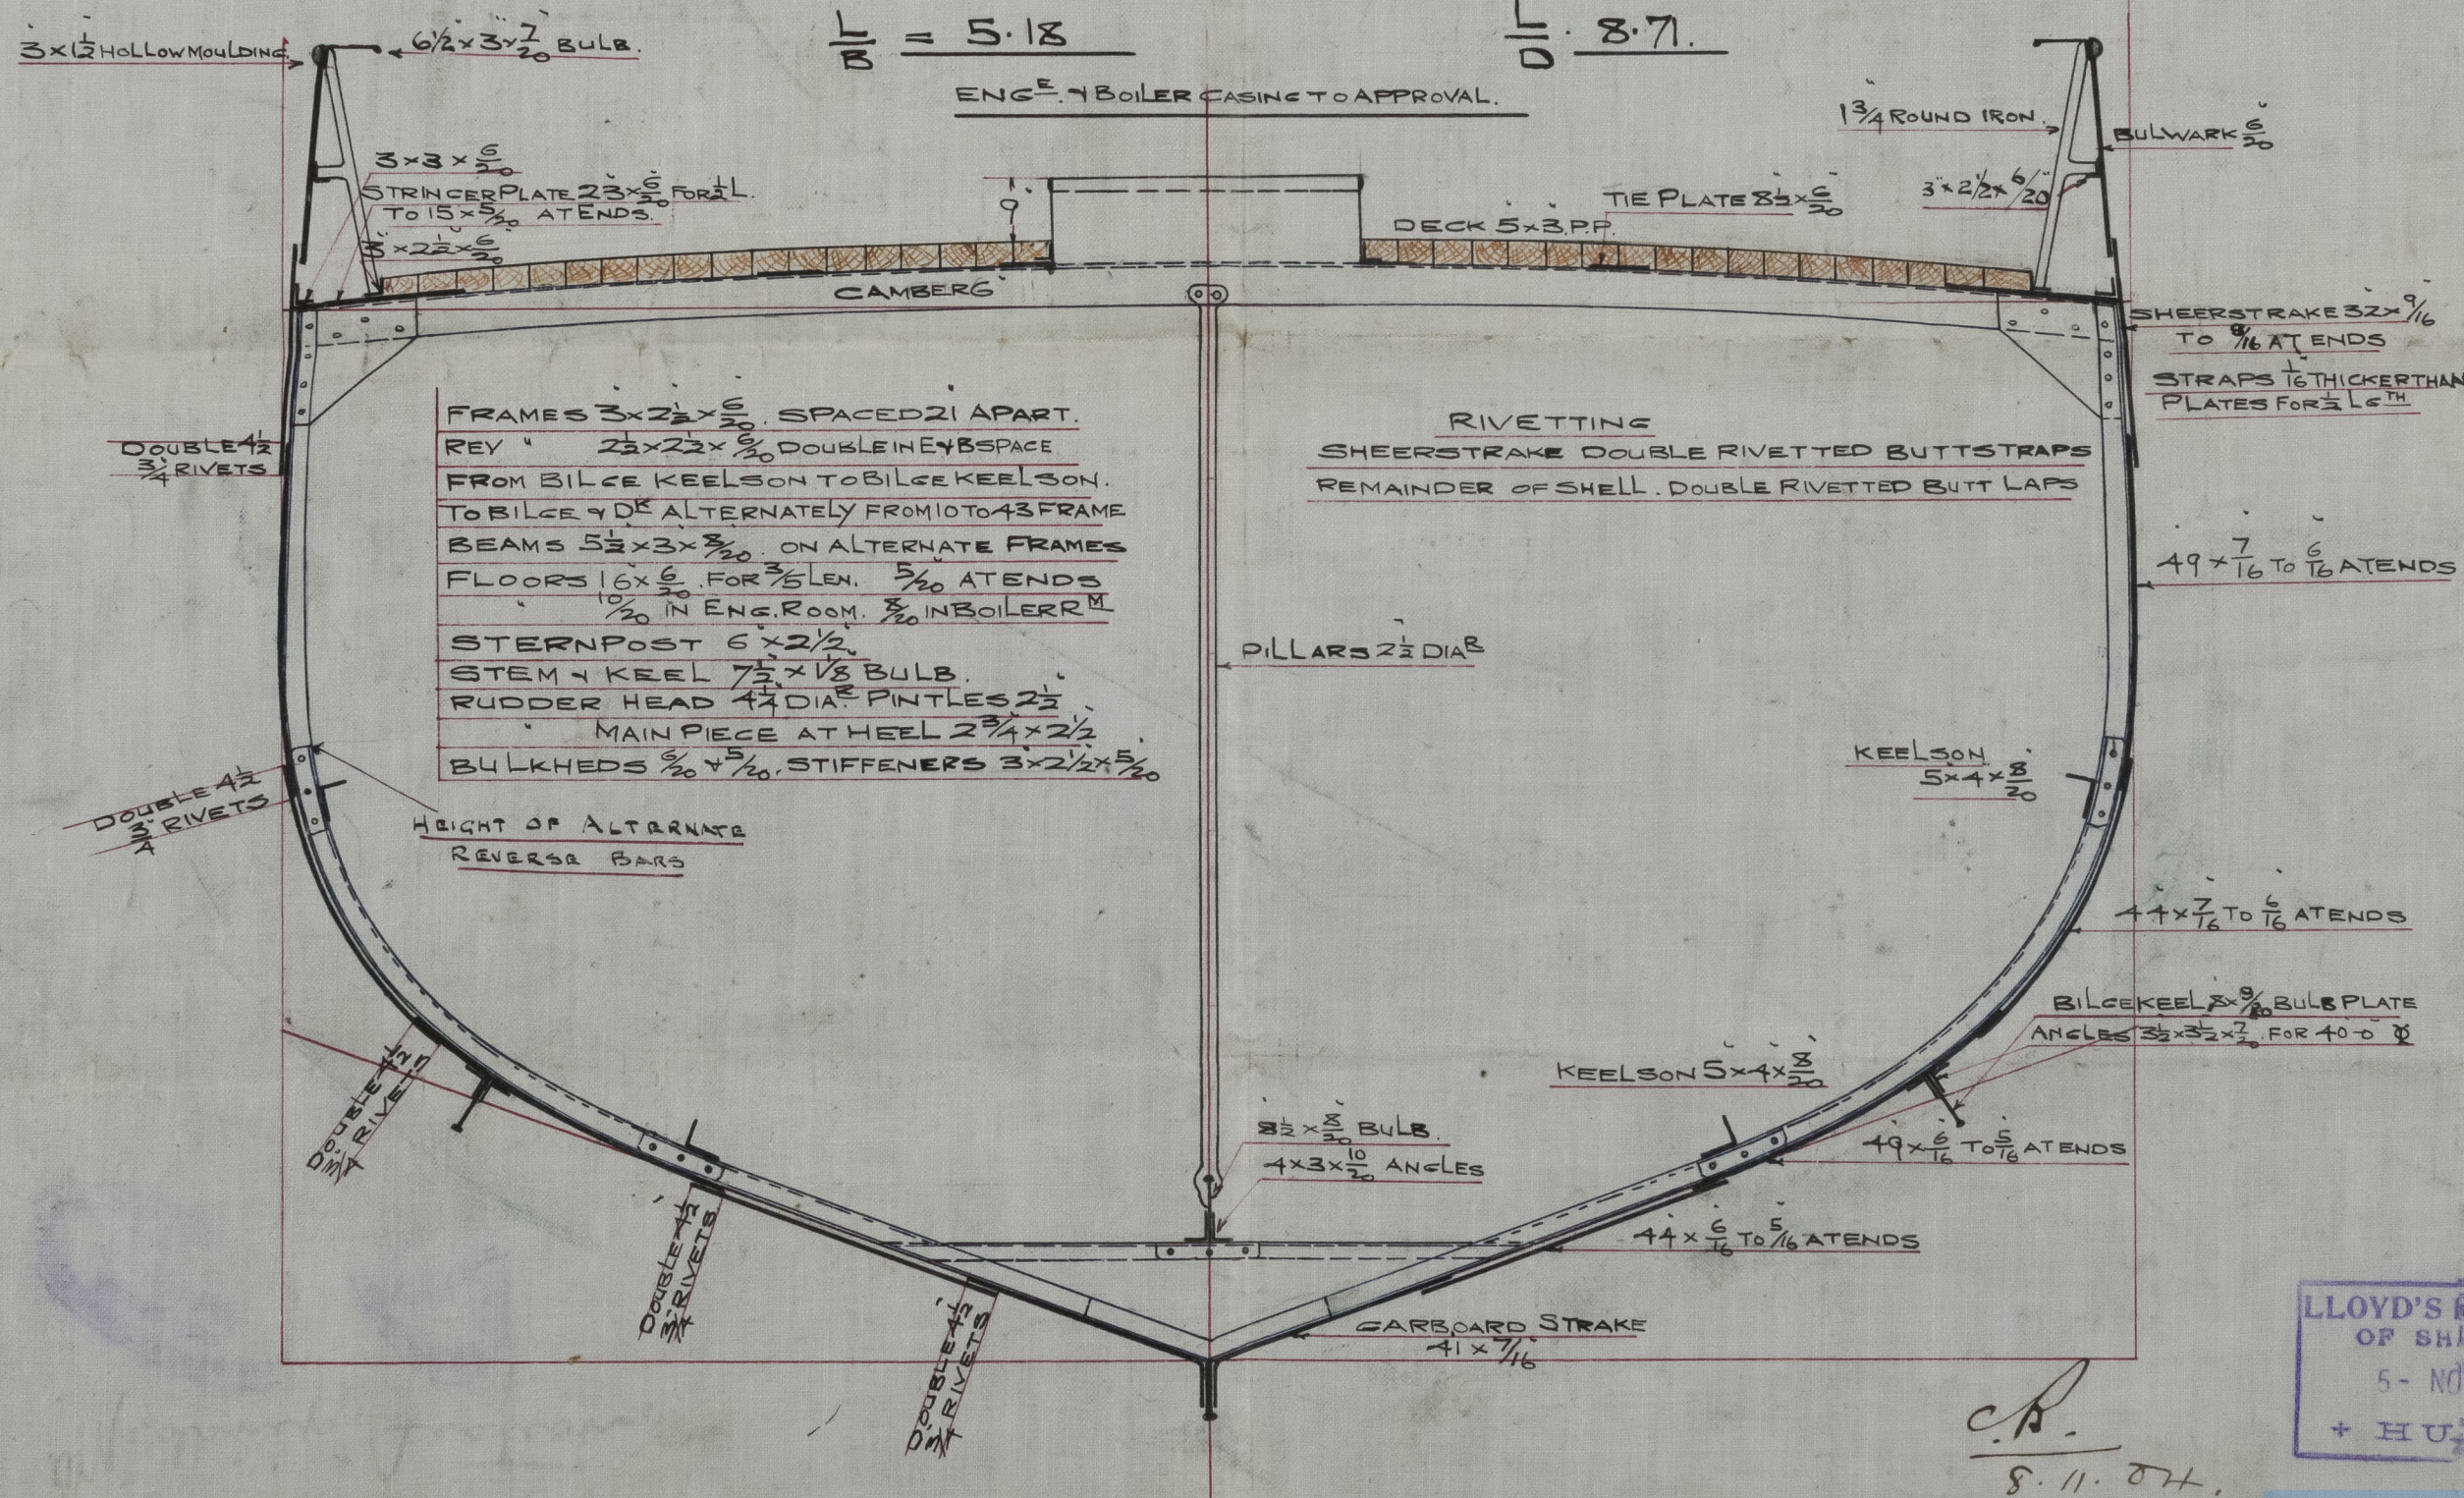

C.P.
8. 11. 04.


Goole S. & R. Co.

No. 5

S. Jamescock

Hull Report No 16782

Midship Section.

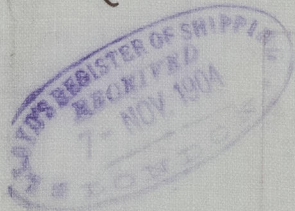

© 2020

Lloyd's Register
Foundation

066317-06931-004