
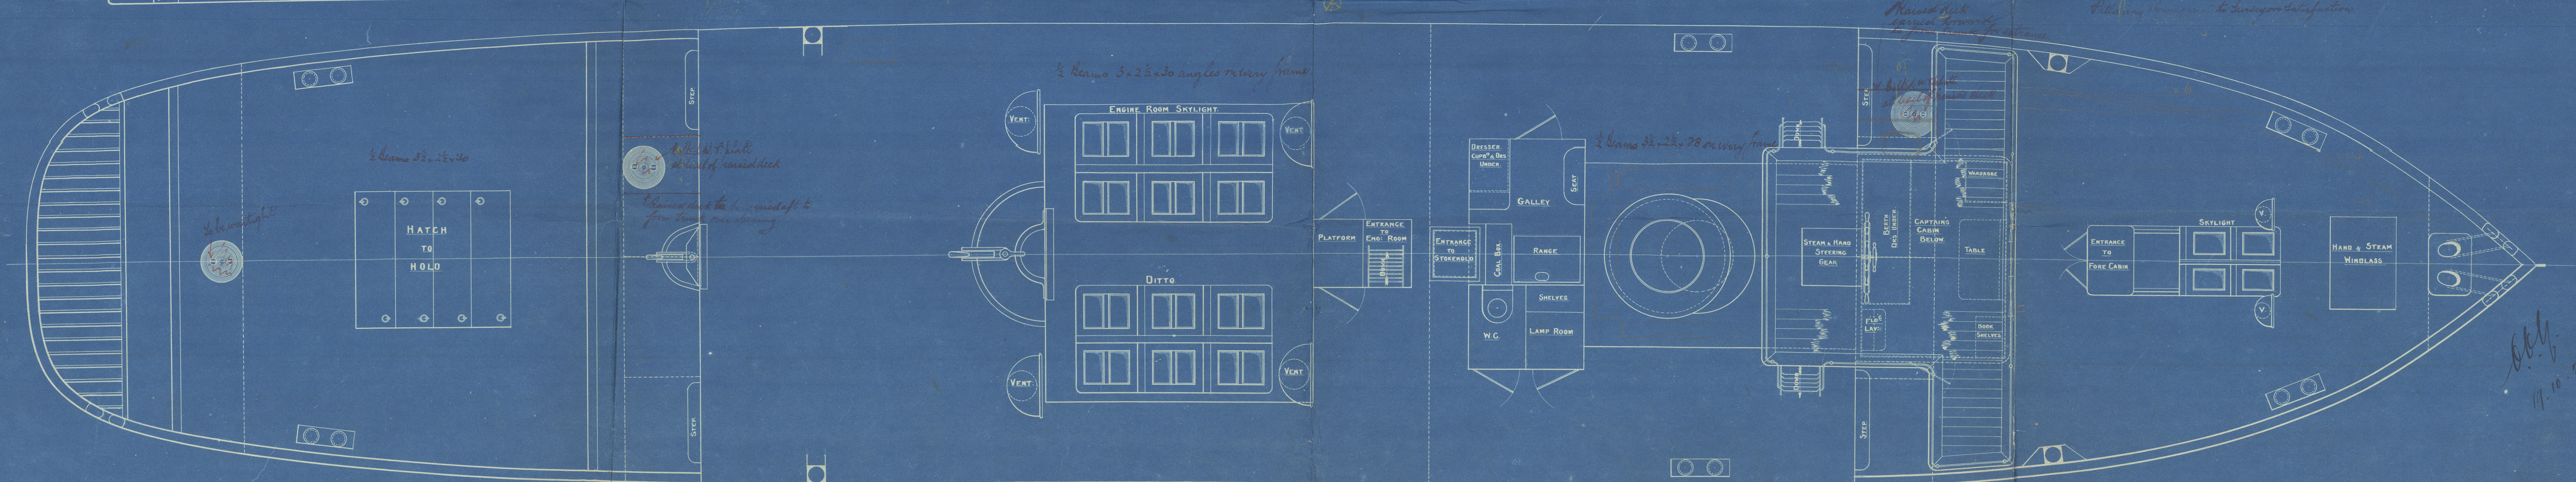


19.10.21

PROPOSED T.S. FIREFLOAT, HARBOUR TUG, & WATER TENDER

PRINCIPAL DIMS: LENGTH OA 109'-0" * B.P. 105'-0" * BREADTH M^{LD} 20'-0" * DEPTH M^{LD} 8'-6" * DRAFT AFT 6'-6"

SCALE $\frac{3}{8}" = 1'-0"$

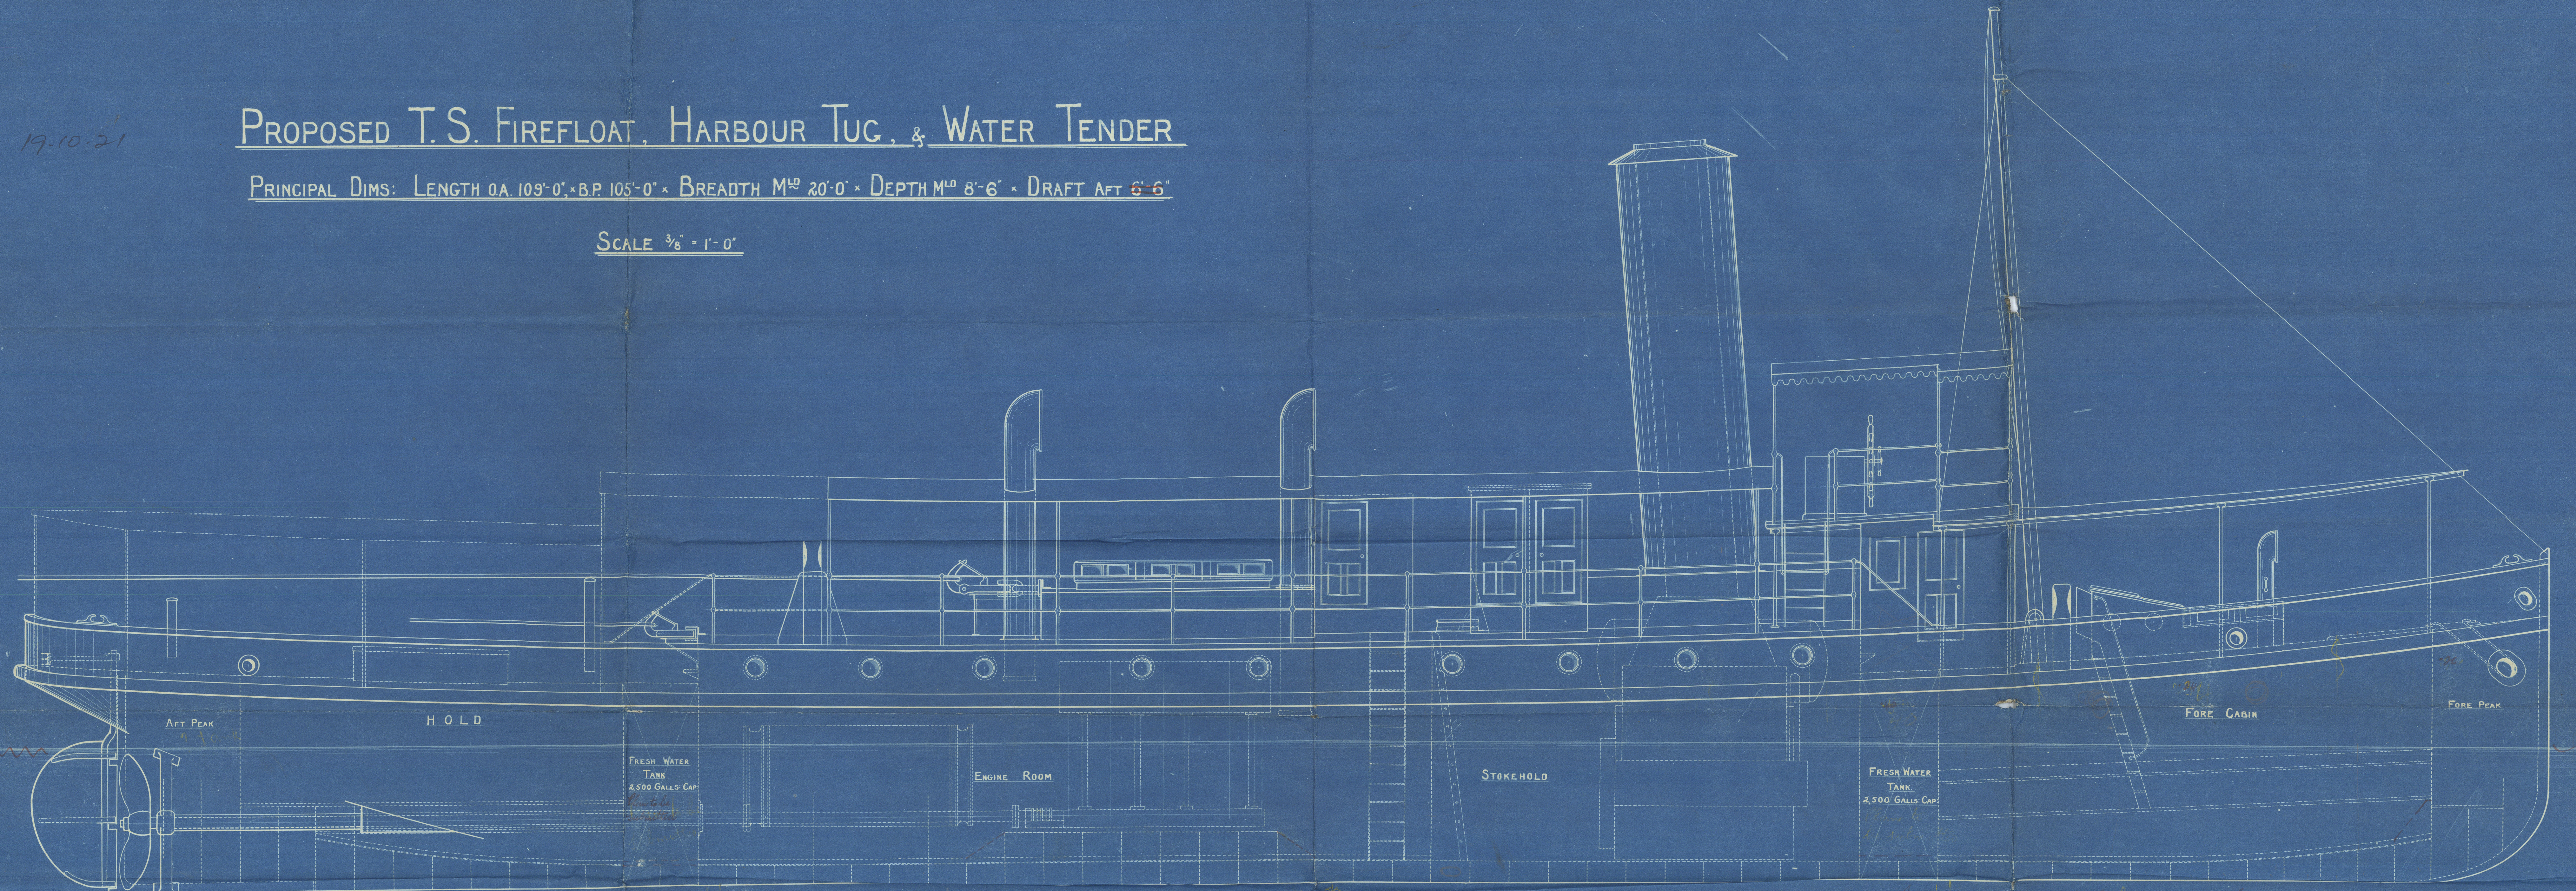

19.10.21

No 787

Lloyd's Segred
Print Reed
20/11/21

GA

S/s Merryweather
London Rpt 86129.



© 2021

006332-006342-0132

Lloyd's Register
Foundation