


26.1.14

# FORGING PLAN

SHIP N<sup>o</sup> 191

SCALE 1" = 1 FOOT.

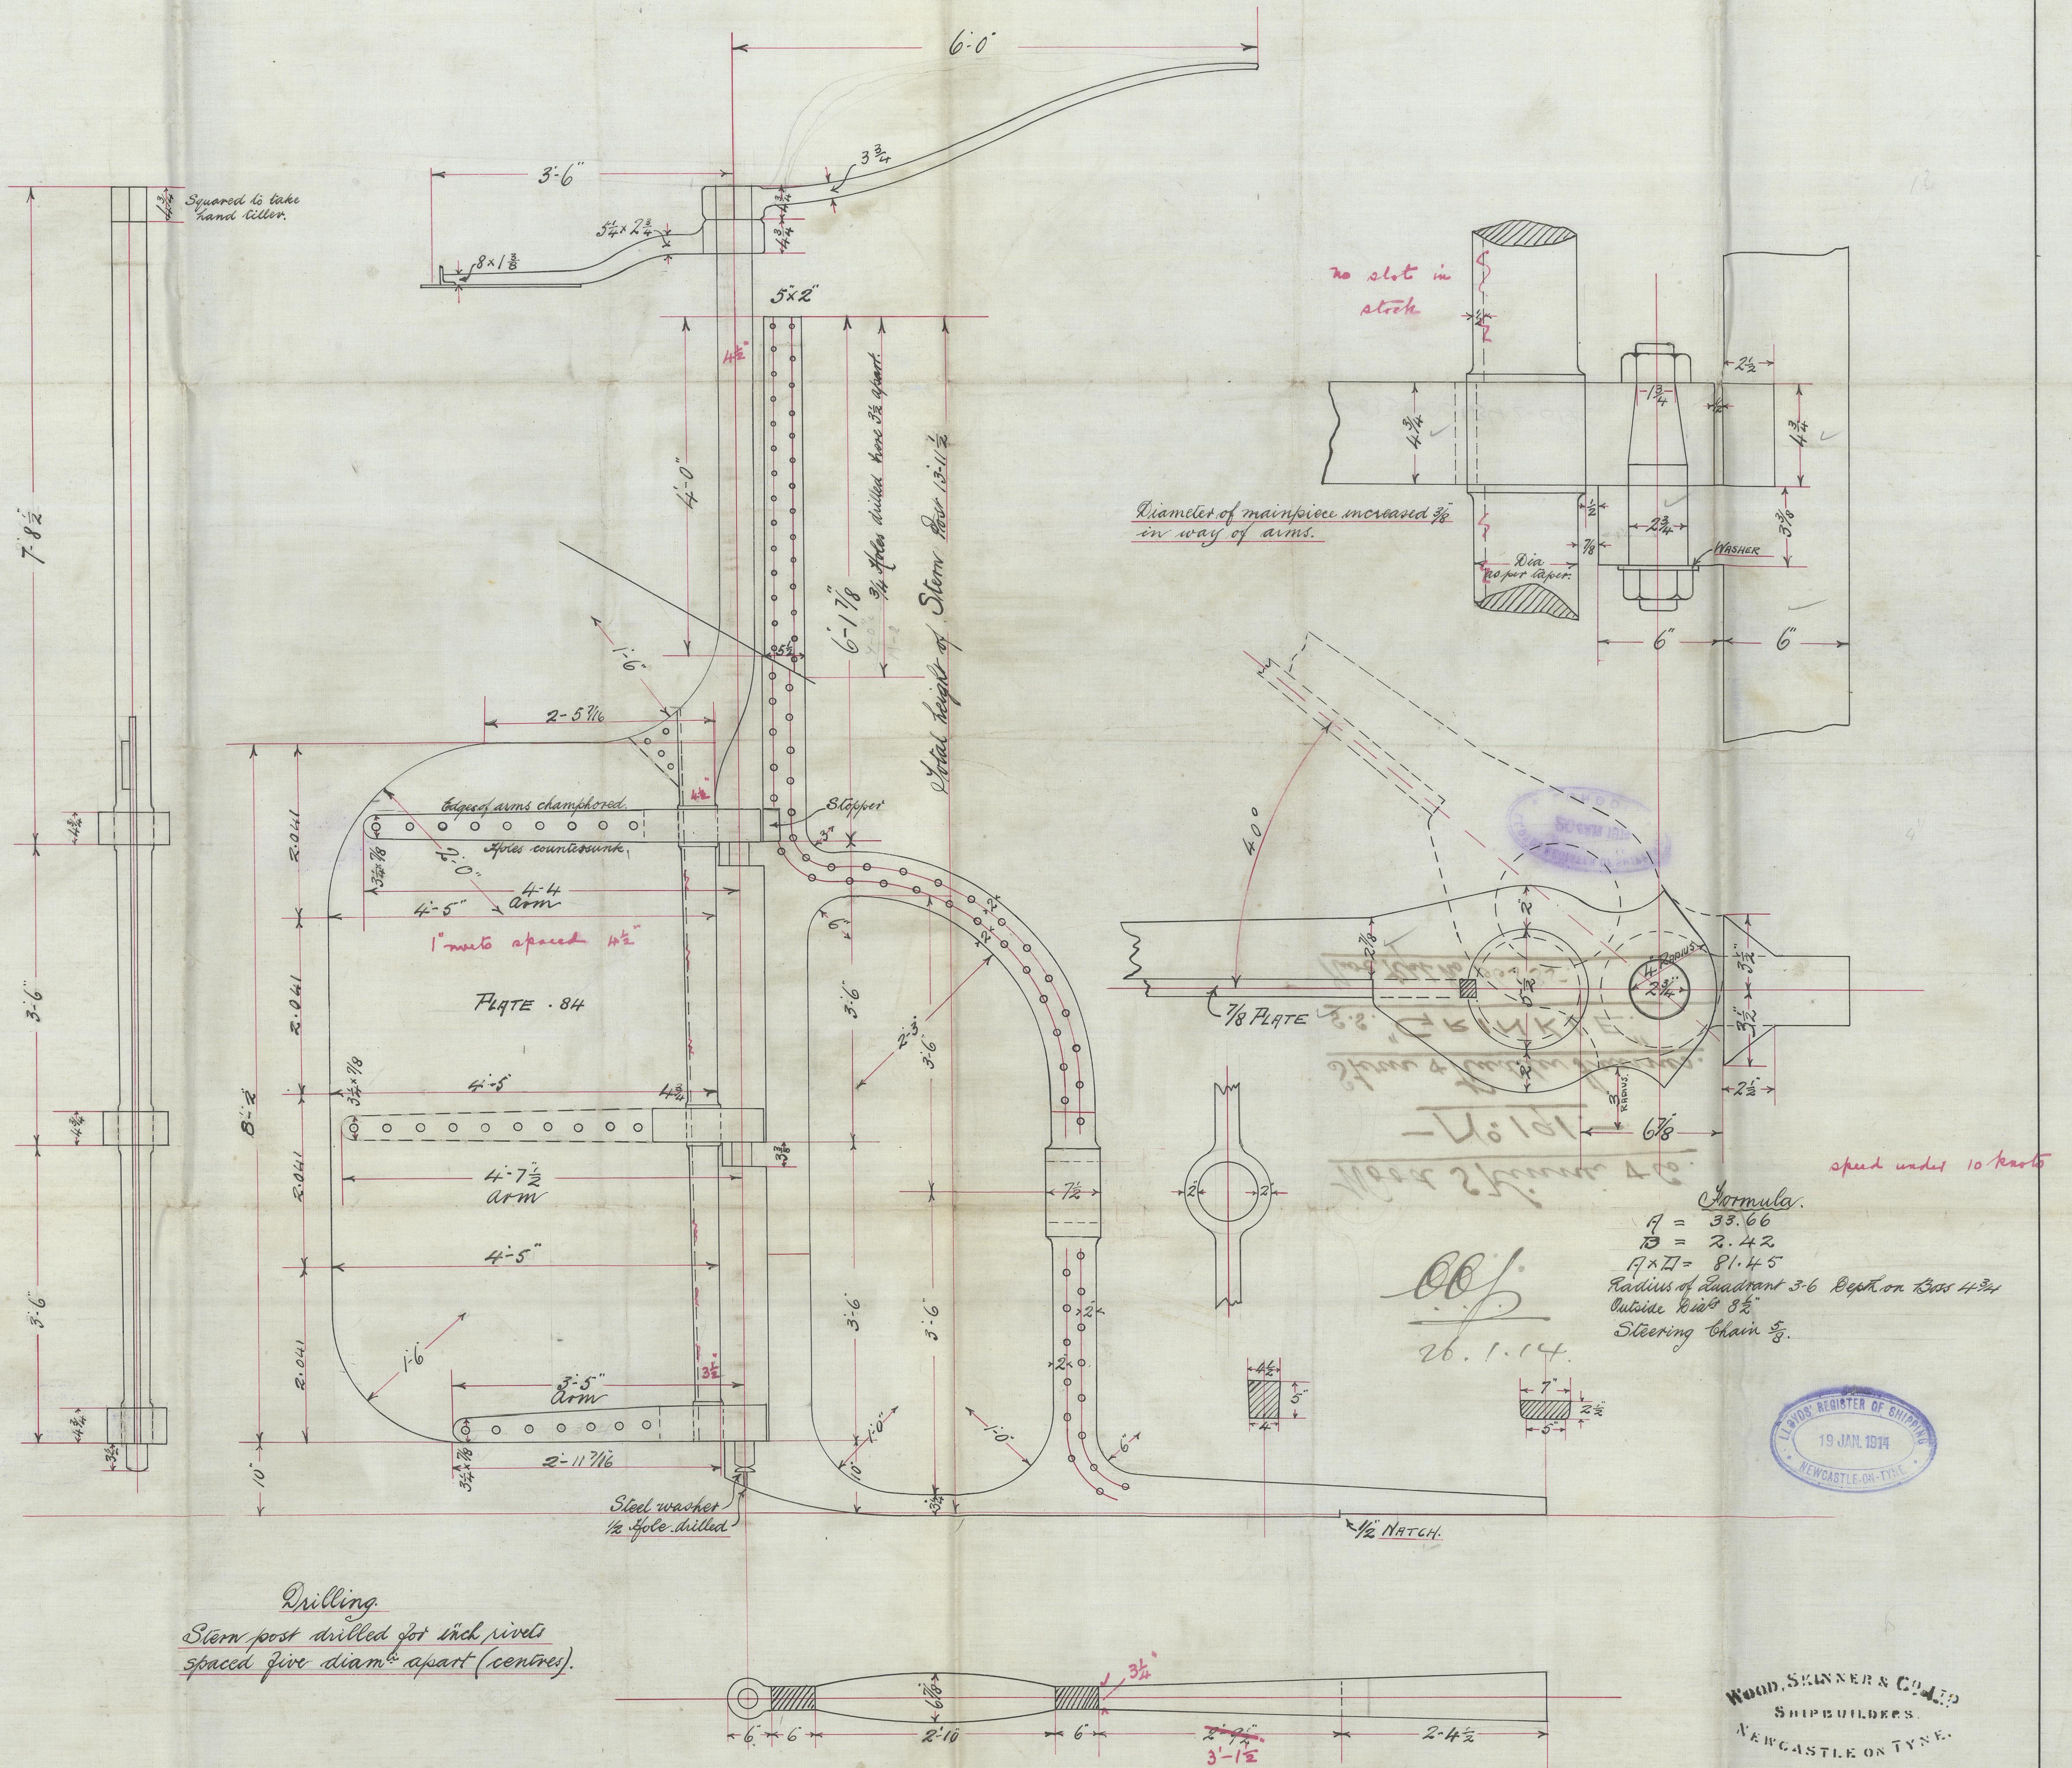




Wood Skinner & Co.

- No 191. -

Stern & Rudder Frames.

S.S. "GRINKLE."

Loc Rpt No 66535.

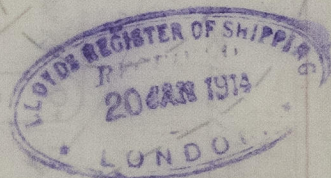

© 2021

Lloyd's Register  
Foundation

006334006342-0172