


7.2.14

- TO CLASS 100 A.I. AT LLOYDS.

~ SCALE $\frac{3}{4}" = 1 \text{ FOOT.}$ ~

DEPTH " ----- 10' - 3" ✓

Nº 191 $\frac{S}{S}$

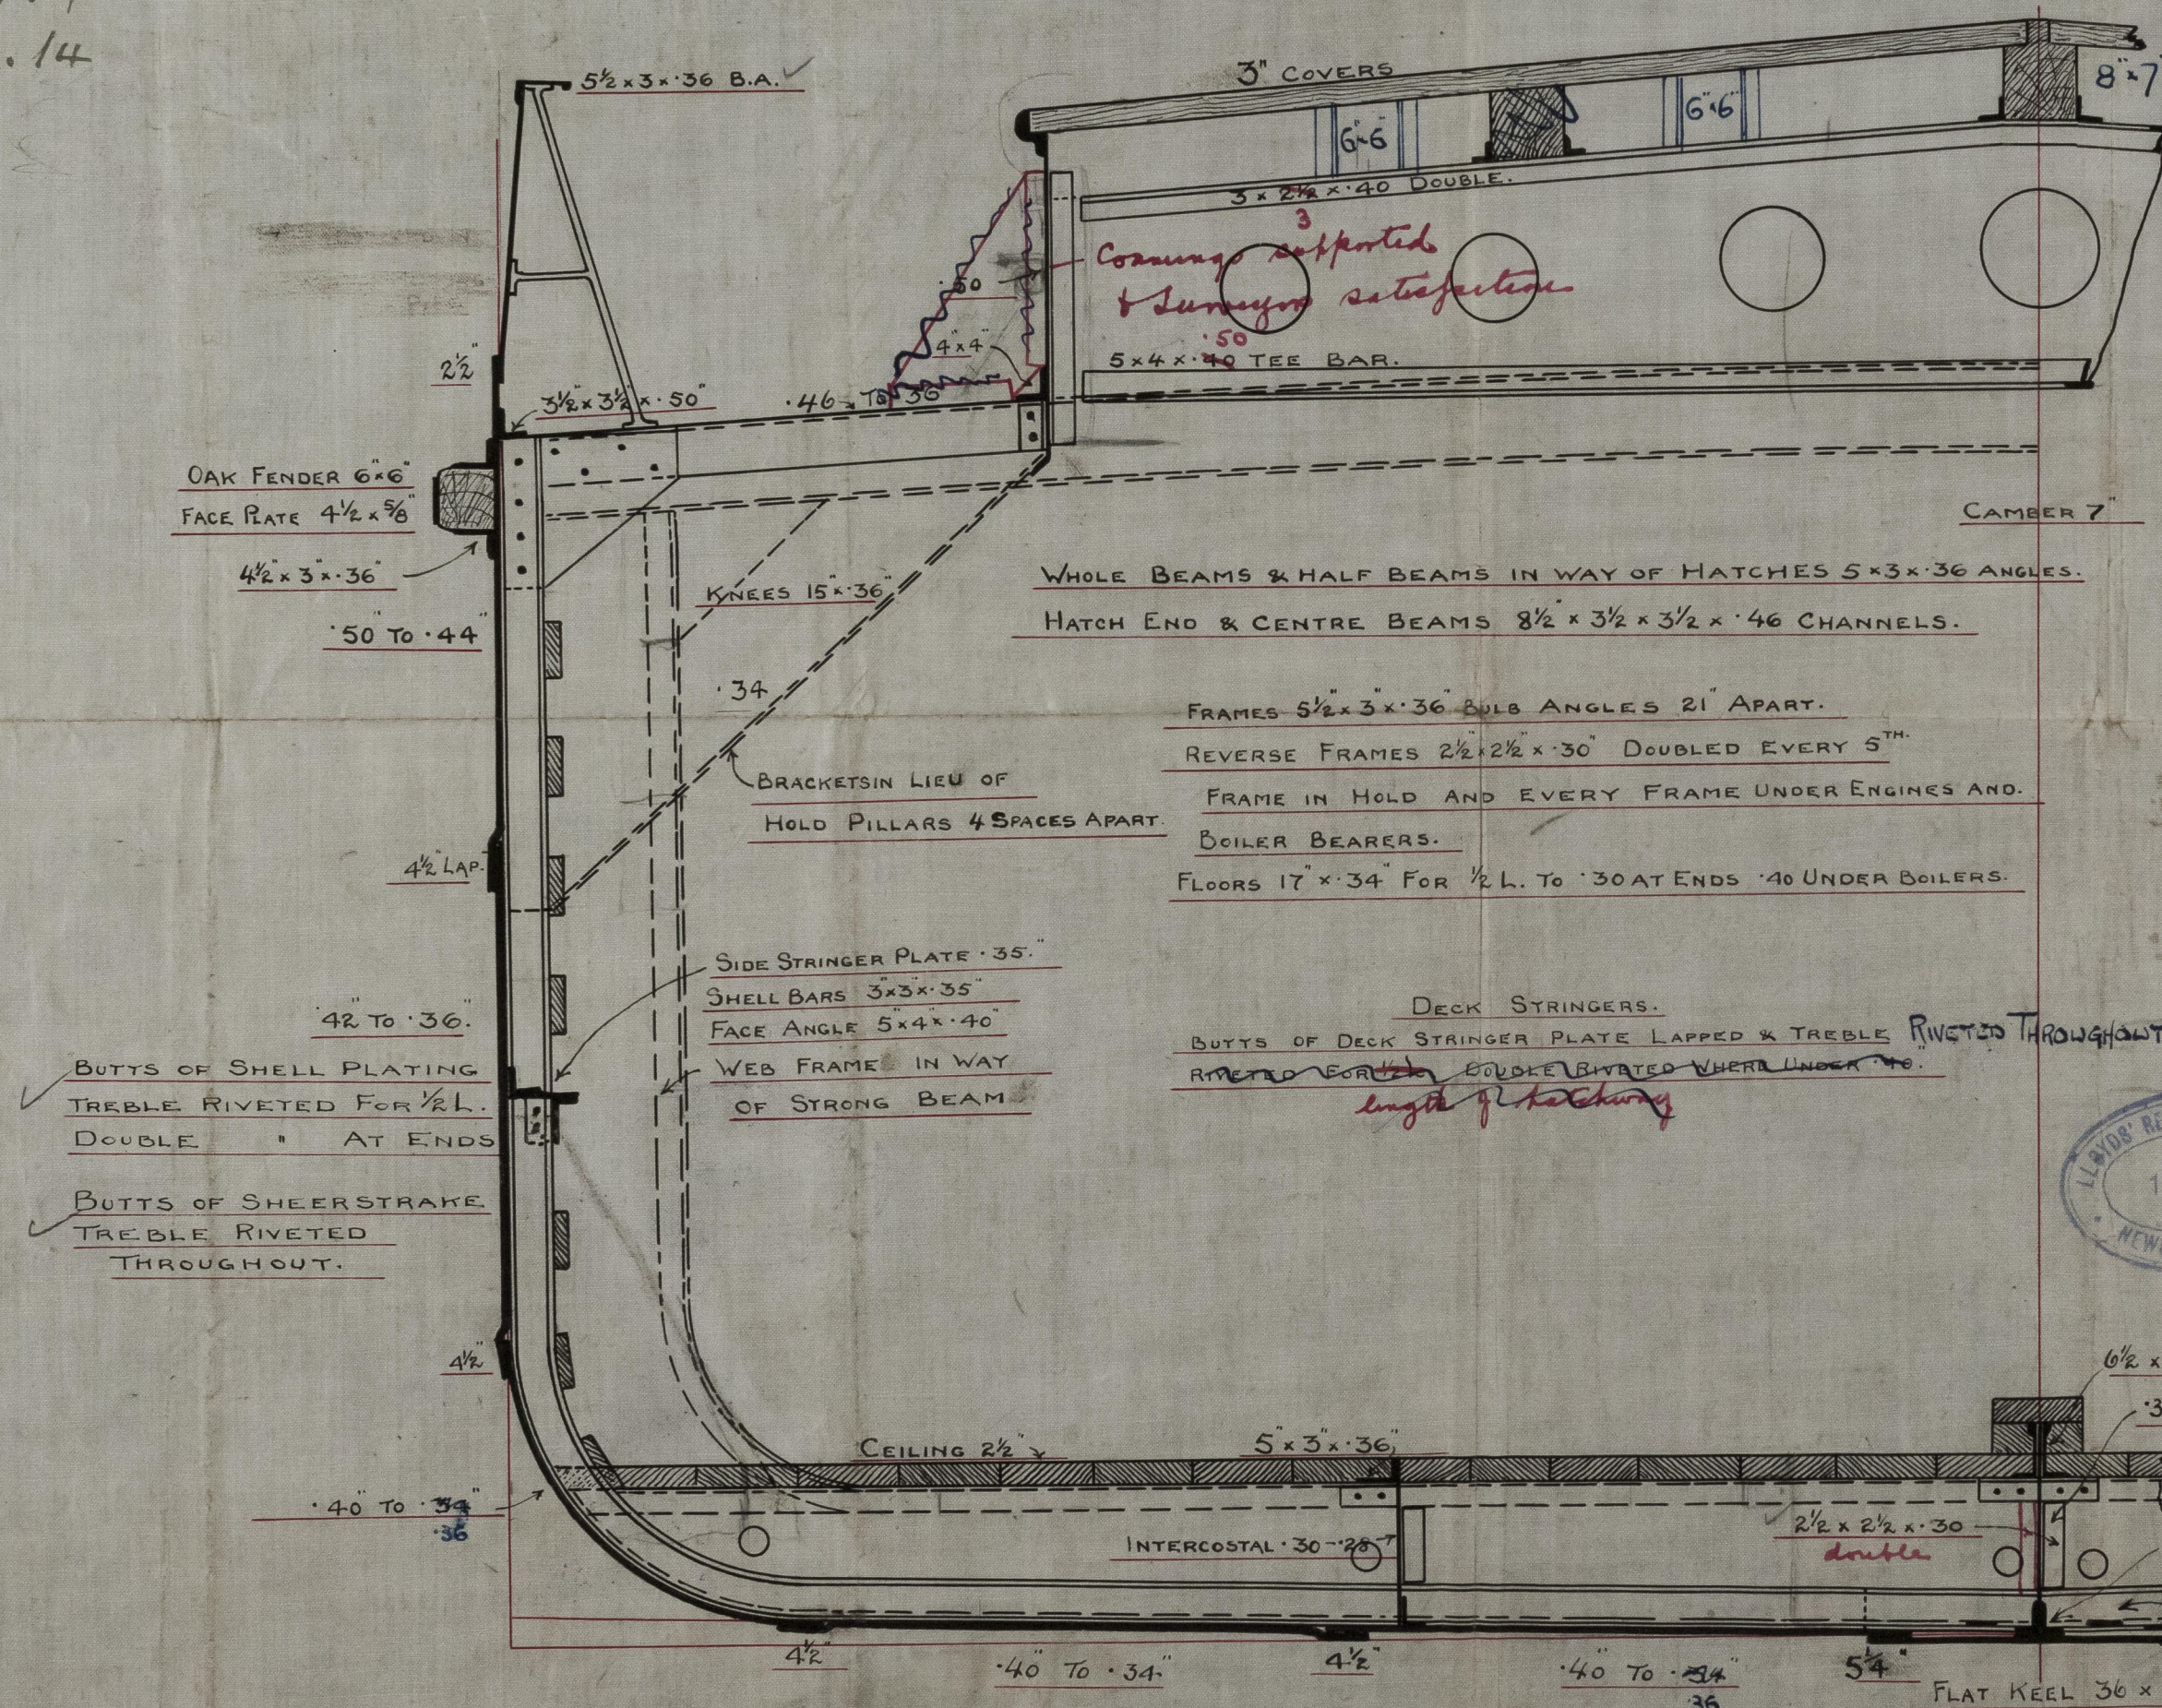

DEC 1 1961

26. 1. 11

BAR FOR $\frac{3}{4}$ h.

42"

ETED ~~FOR~~ $\frac{1}{2}$ L.

DEPTH

BREAST





Wood Skinner & Co.

- No 191 -

Midship Section.

S.S. "GRINKLE."

Proc Rpt No. 66535

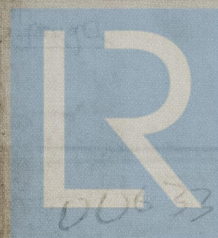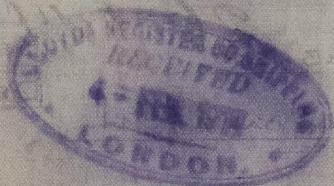

© 2021

Lloyd's Register
Foundation