

5.2.12
(N=159+00) 28.2.13

NUMERALS.

$B+D = 21.5 + 12.92 =$

34.42 TRANS: N^o.

$L(B+D) = 110 \times 34.42 =$

3786.2 LONGI: N^o.

DEPTH (d) = 11.58

N^{os} 149 & 153 + 159.160

MIDSHIP SECTION.

STEEL SCREW FLEETERS.

DIMS: 110'-0" x 21'-6" x 12'-11" N^o.

SCALE 1/2" = 1 FT.

CLASS 100 A.I. LLOYDS.

EQUIPMENT

1 ANCHOR 5 CWT EX STOCK.


1 " 4 1/2 " " " "

1 " 2 1/2 " " " "

90 FATHOMS 1" STUD LINK CABLE.

60 " 5 1/2" HAWSER.

60 " 4" WARP.

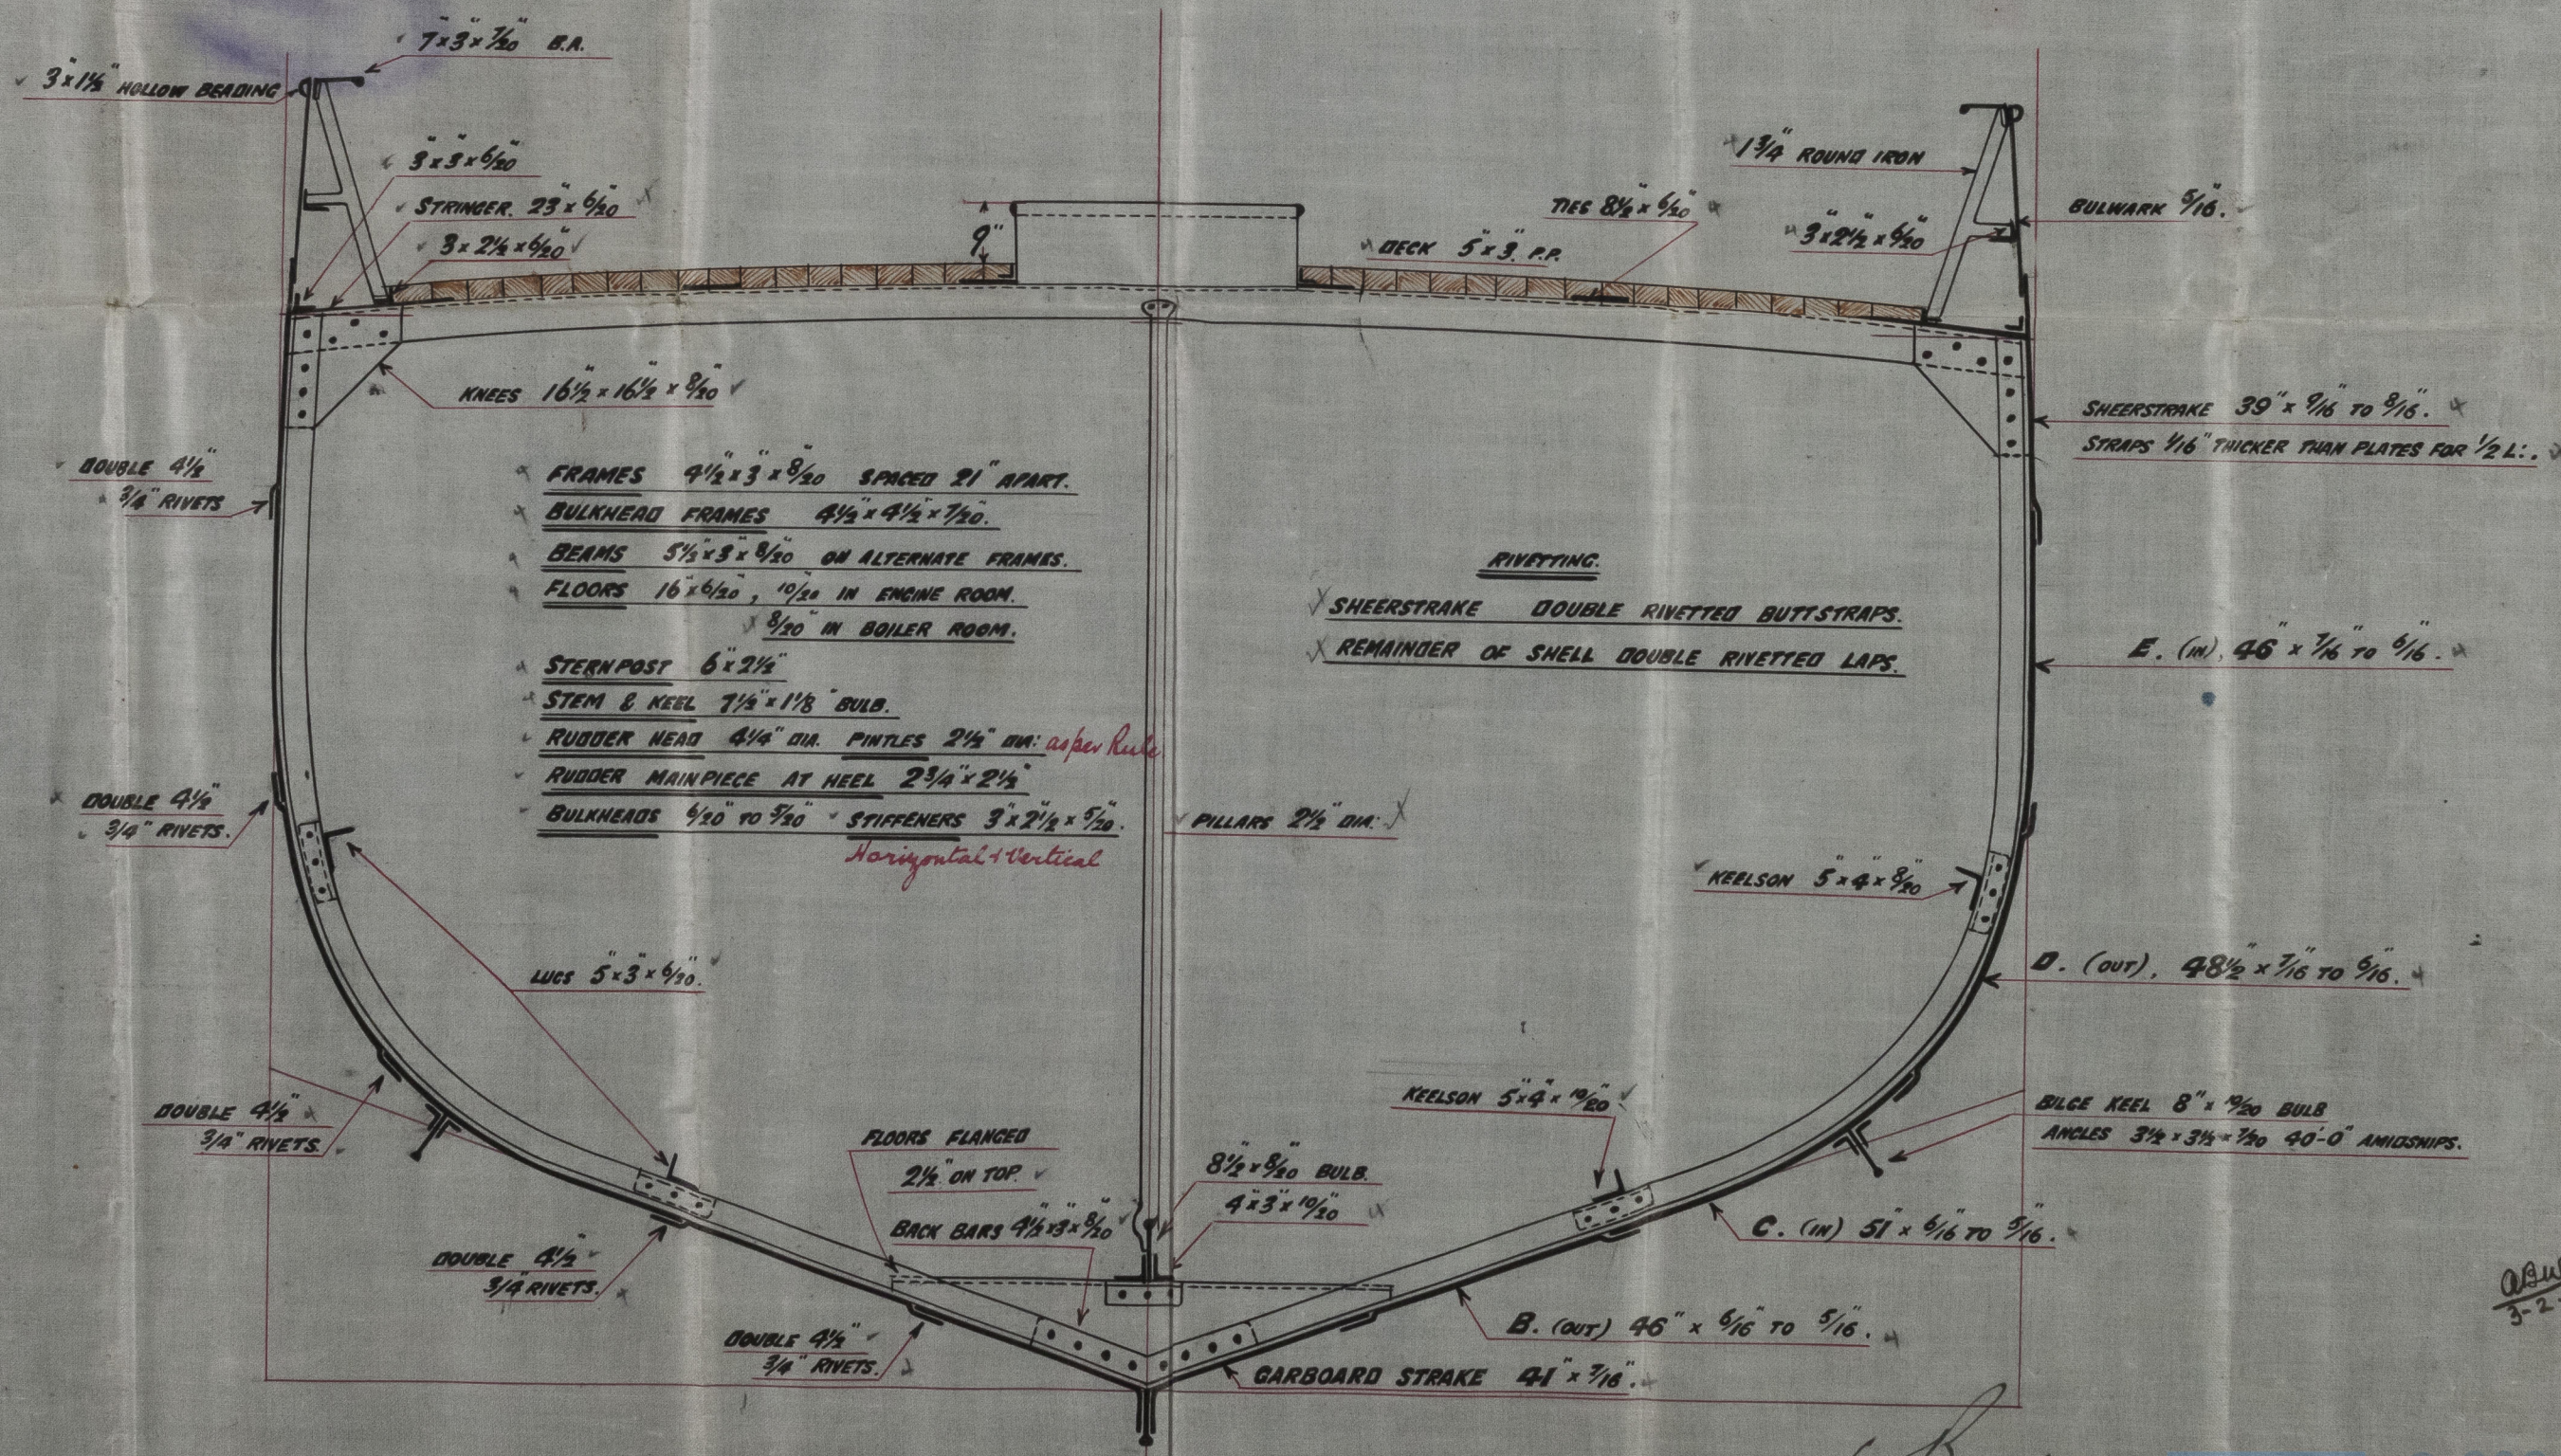

ABW
3-2-12

Book Shipbuilding, Repairing &c.

N^o 149-153.

Midship Section ^{+ 159-160}

s/s Vries. Hull Rph No. 25196

" Warbler "	"	"	25516
" Kildeer "	"	"	26889
" Trumpeter "	"	"	26959



© 2021

Lloyd's Register
Foundation

006343-006357-0189