



5-2-12
28.2.13 (N^o 159-160)

N^o 149 & 153. N^o 159-160.
ELEVATION.
DIMS: 110'-0" x 21'-6" x 12'-11" M.L.D.
SCALE 1/4" = 1 FOOT

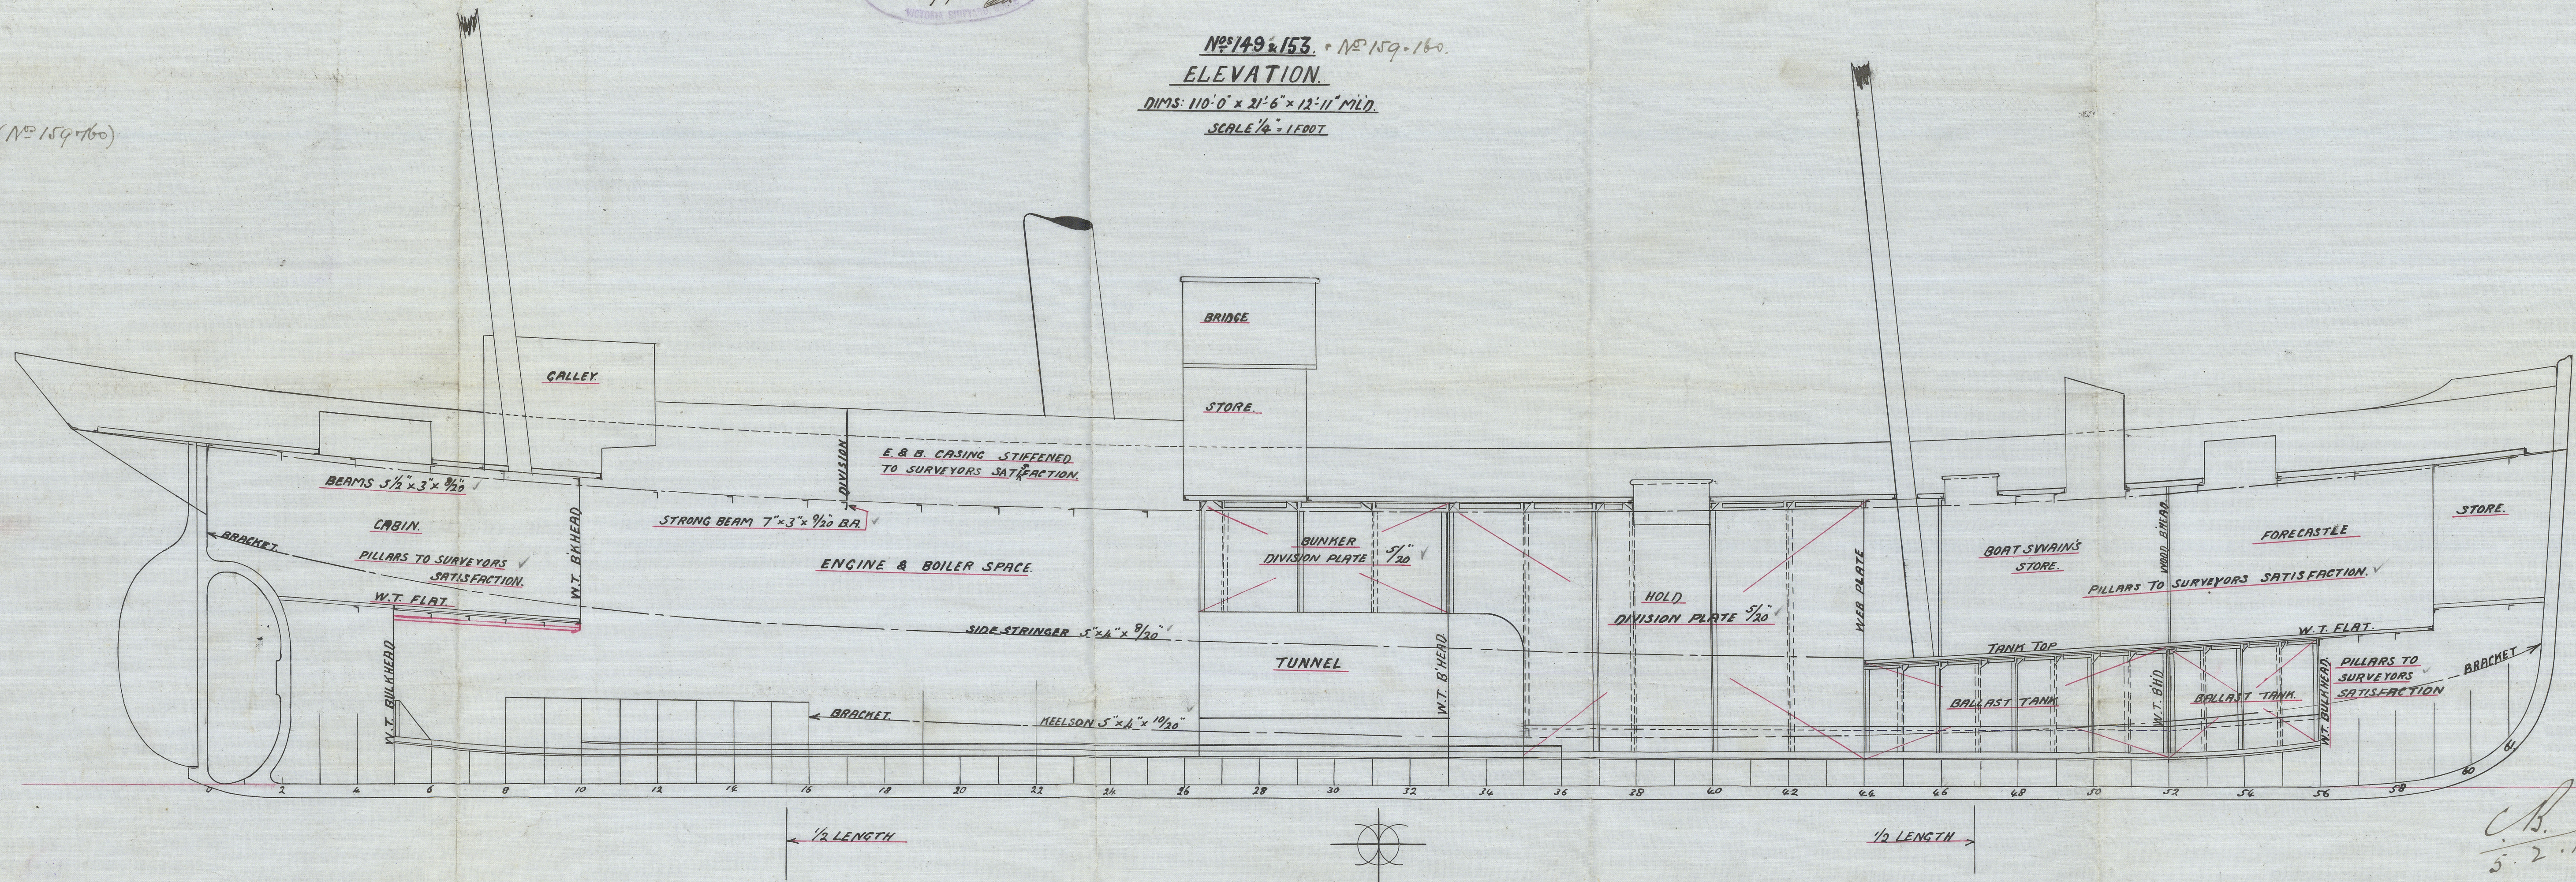

SECTION THROUGH BALLAST TANK
SCALE 1/2" = 1 FOOT

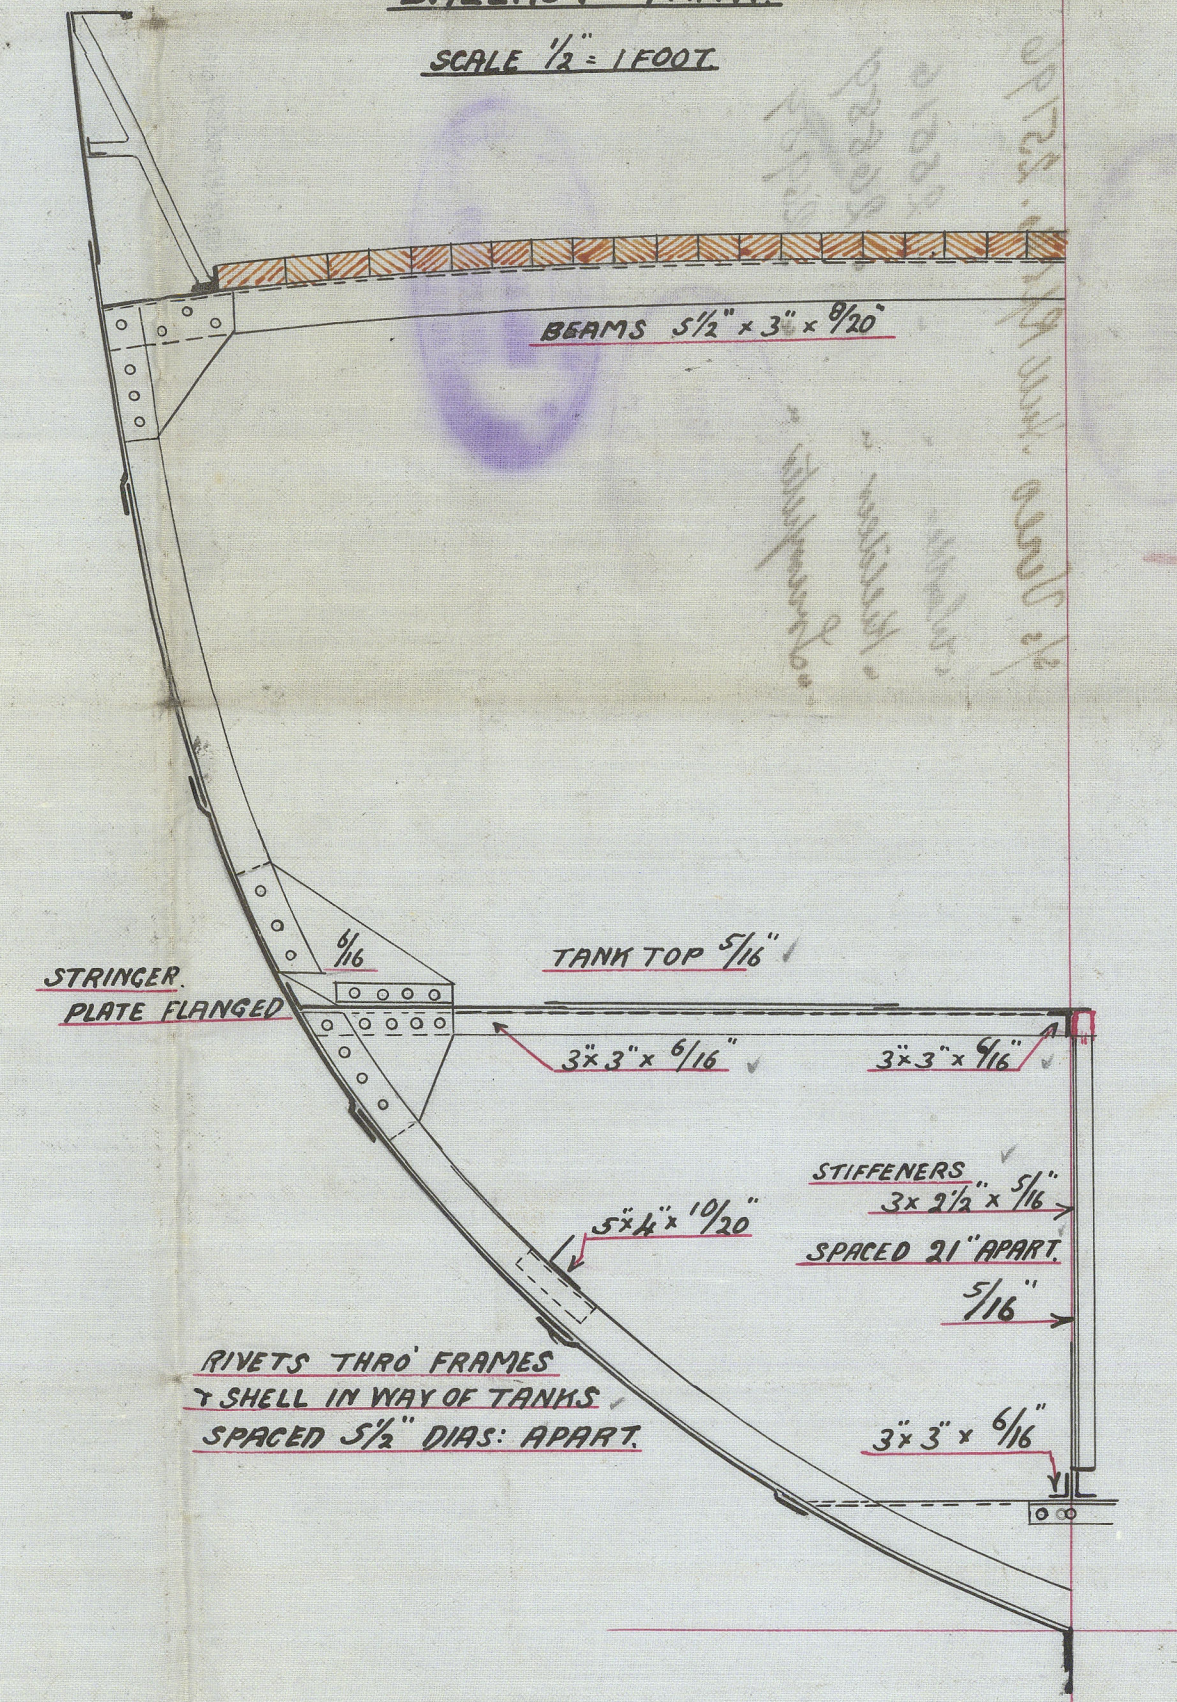

C.B.
5.2.12.

Good Shipbuilding & Repairing Co.

No 149 and 153.

Section ⁺¹⁵⁹⁺¹⁶⁰


Profile

s/s Vasco Hull Rph No. 25196

" Warbler " " 25516

" Kulldeer " " 26889

" Trumpeter " " 26959

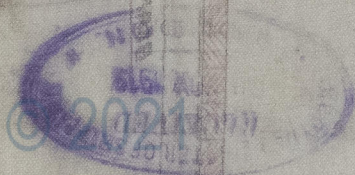

10071 - 5/1 1902

Lloyd's Register
Foundation

006343-006257-0190