


2 1/2" 2 1/4" DIA. BOLTS.
4 EACH SIDE.

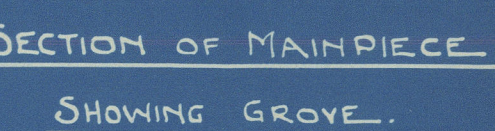

~~3 1/4"~~ METAL



10" x 1" ~~10" x 4 5/8~~

STERN FRAME OF CAST STEEL
IN TWO PIECES.

Nº 860.

SCALE $\frac{1}{2}" = 1 \text{ FOOT.}$

SCALE 3" = 1 FOOT.

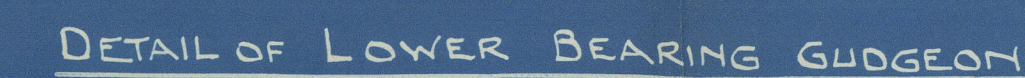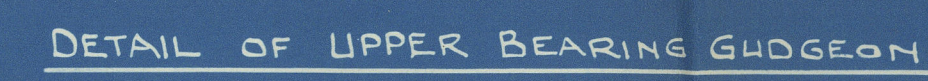

Messrs Swan Hunter &
Wigham Richardson Ltd


S.S. 860

Plan of stern frame &
rudder.

SS. "GOLDENFELS"

NEWCASTLE - ON - TYNE.

REPORT No 61374

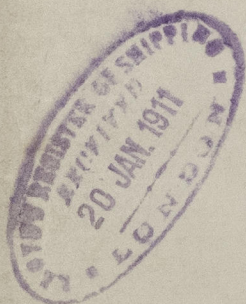

© 2021

Lloyd's Register
Foundation

006358-006368-0017