


S. S. 'JONATHAN HARDY.'
MIDSHIP SECTION.
TO CLASS 100 A.1. "STEAM TRAWLER"
SCALE $\frac{1}{2}$ " = ONE FOOT

DIMENSIONS.

LENGTH B.P.	115'0"	TRANS NO	22+13 = 35.
BREADTH M.P.	22'0"	LONGT NO	115x35 = 4025.
DEPTH M.P.	13'0"	d AMIDSHIPS	= 11'66
B = 5.23	D = 8.84	d IN WAY OF TANK	= 9.5.

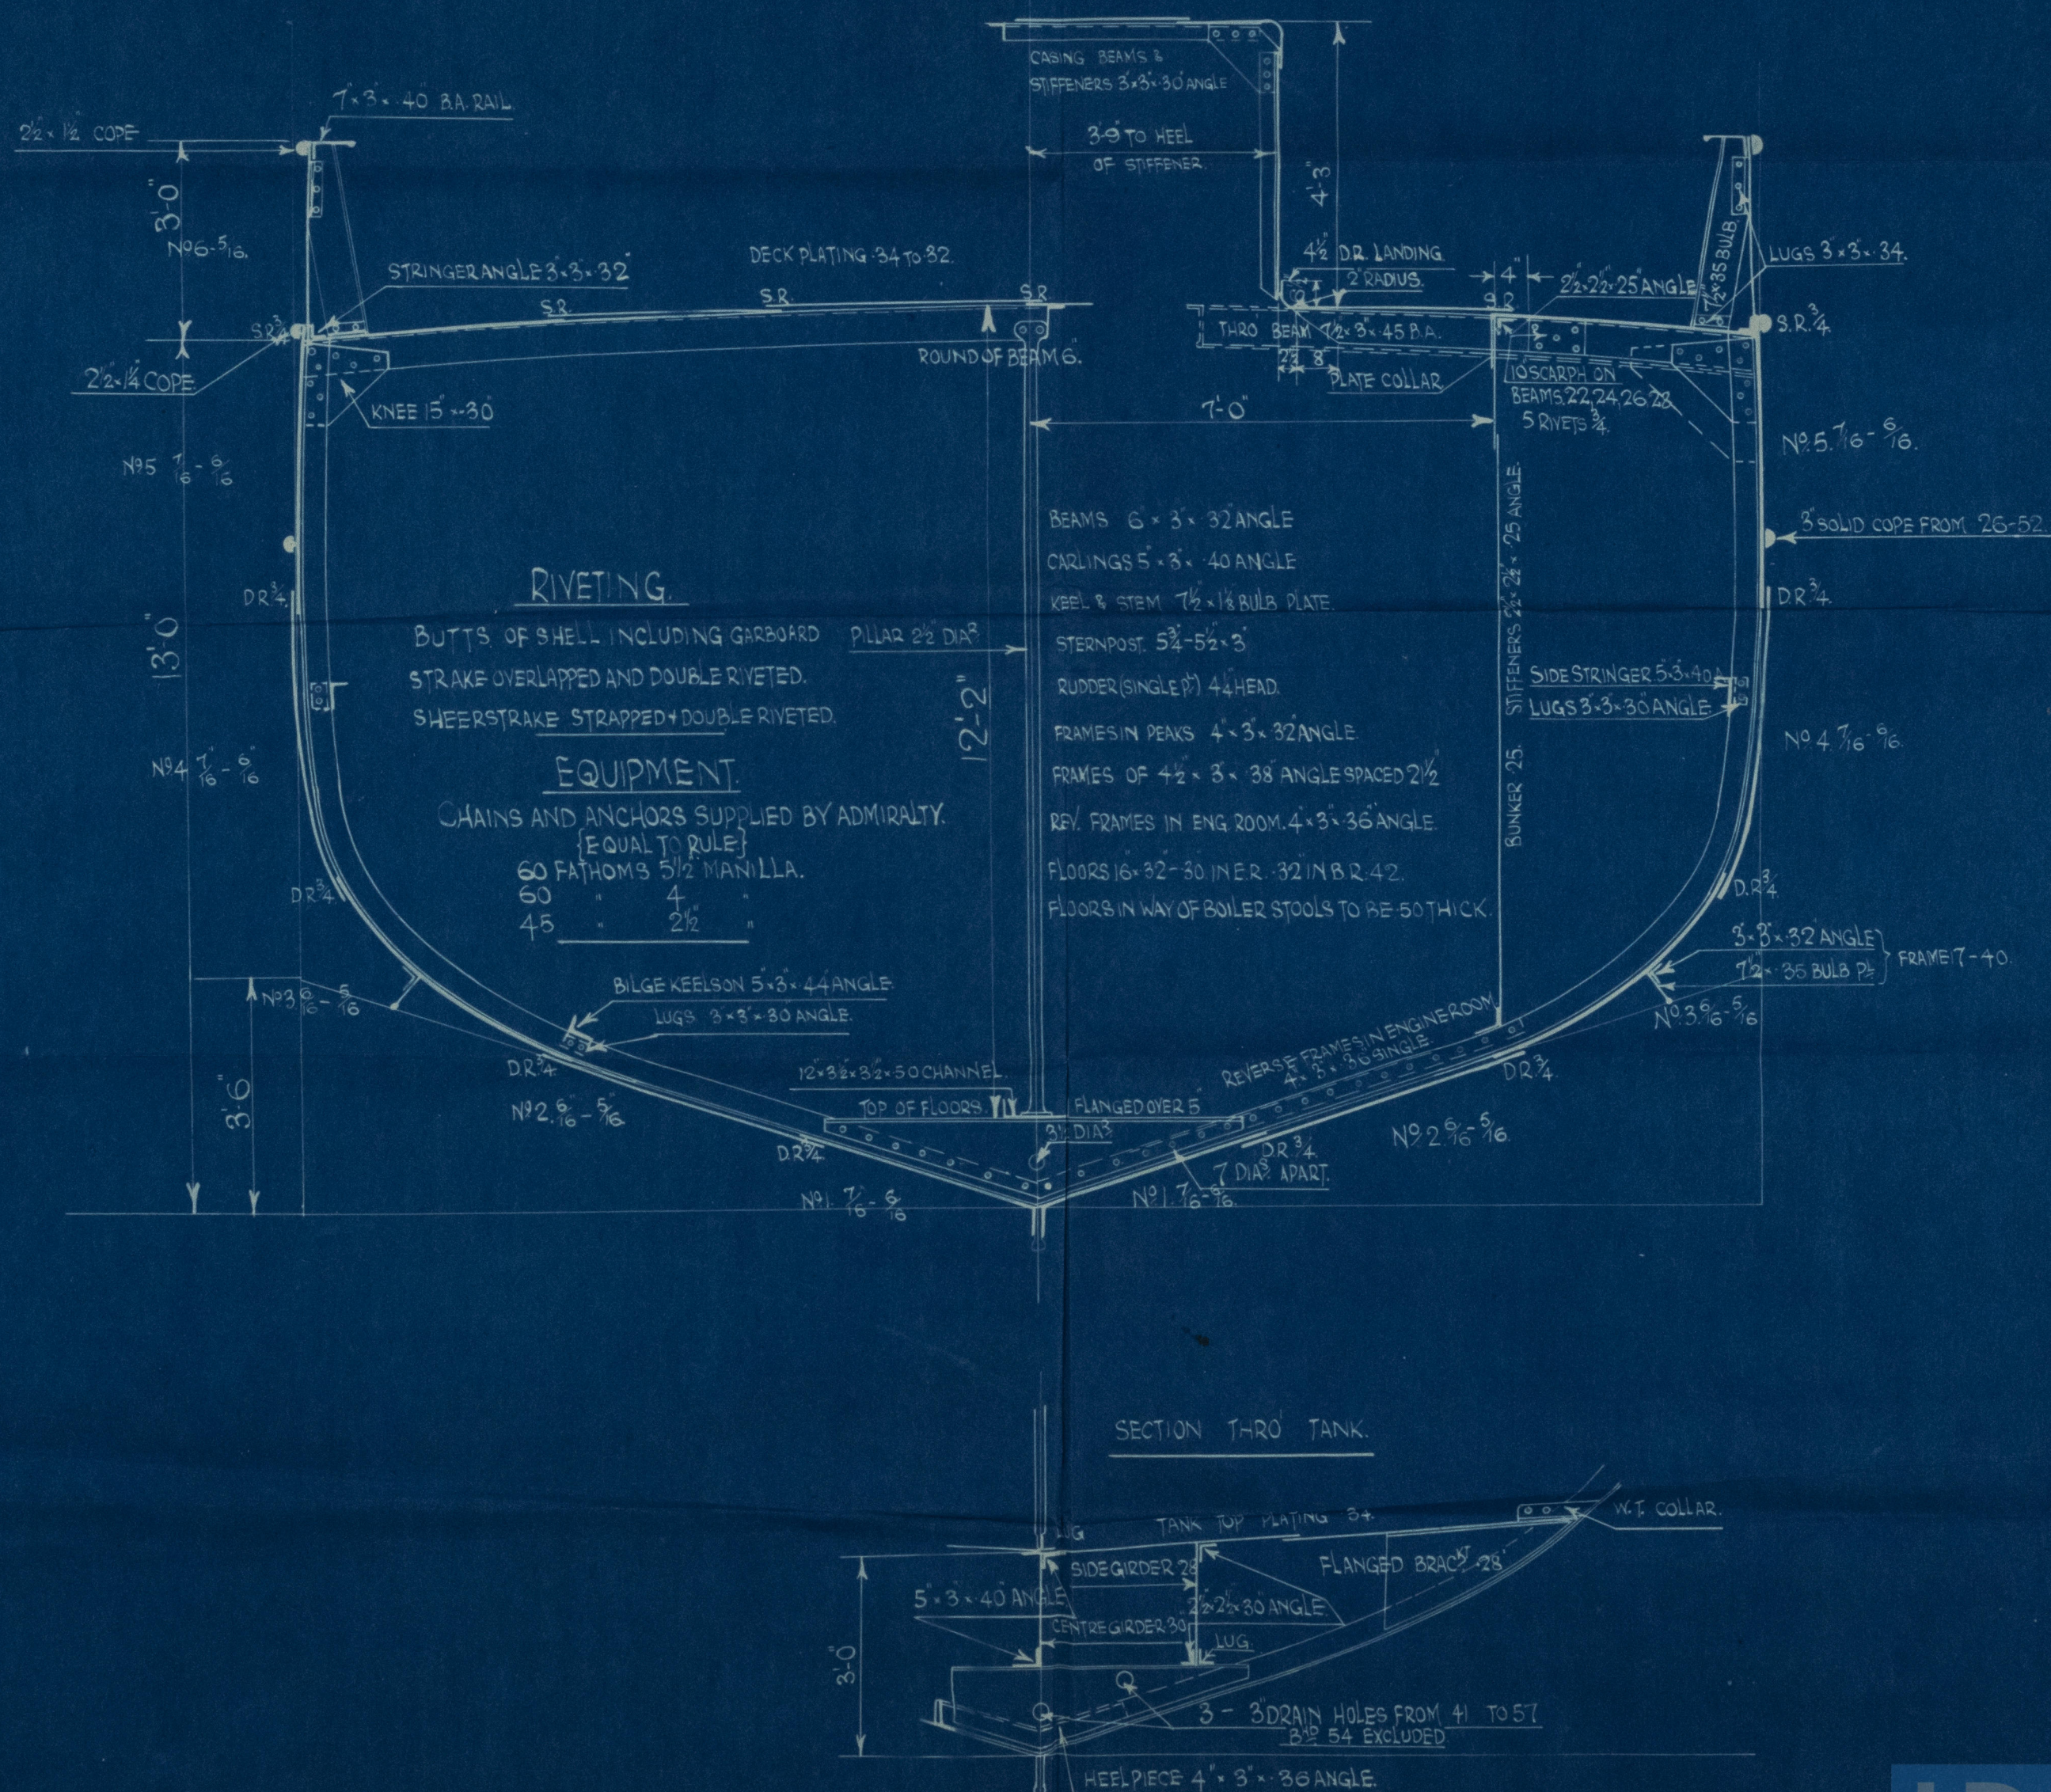

- JOHN FULLERTON & CO. -

Midship Section.

"JONATHAN HARDY"


No. 259.

— " —

GLASGOW REPORT No. 38315

Mul.

9.11.18.

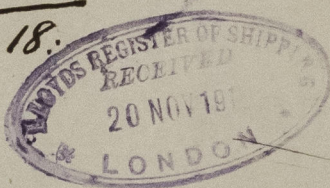

Roche Bleue

Disclass 49T

© 2020

Lloyd's Register

Foundation

006364-006386-001