

12-11-08.

Not given to 5205  
at present

# N<sup>o</sup> 446 MIDSHIP SECTION

STEEL SCREW TRAWLER



DIM<sup>s</sup> 130'-0" B.P. x 23'-0" EX. x 13'-0" MLD.

SCALE 1/2" = 1 FOOT.

TO CLASS 100.A.I. STEAM TRAWLER.

ENGINE & BOILER CASING AS PREVIOUSLY APPROVED.

DECK PLATED OVER IN WAY OF MACHINERY SPACE.

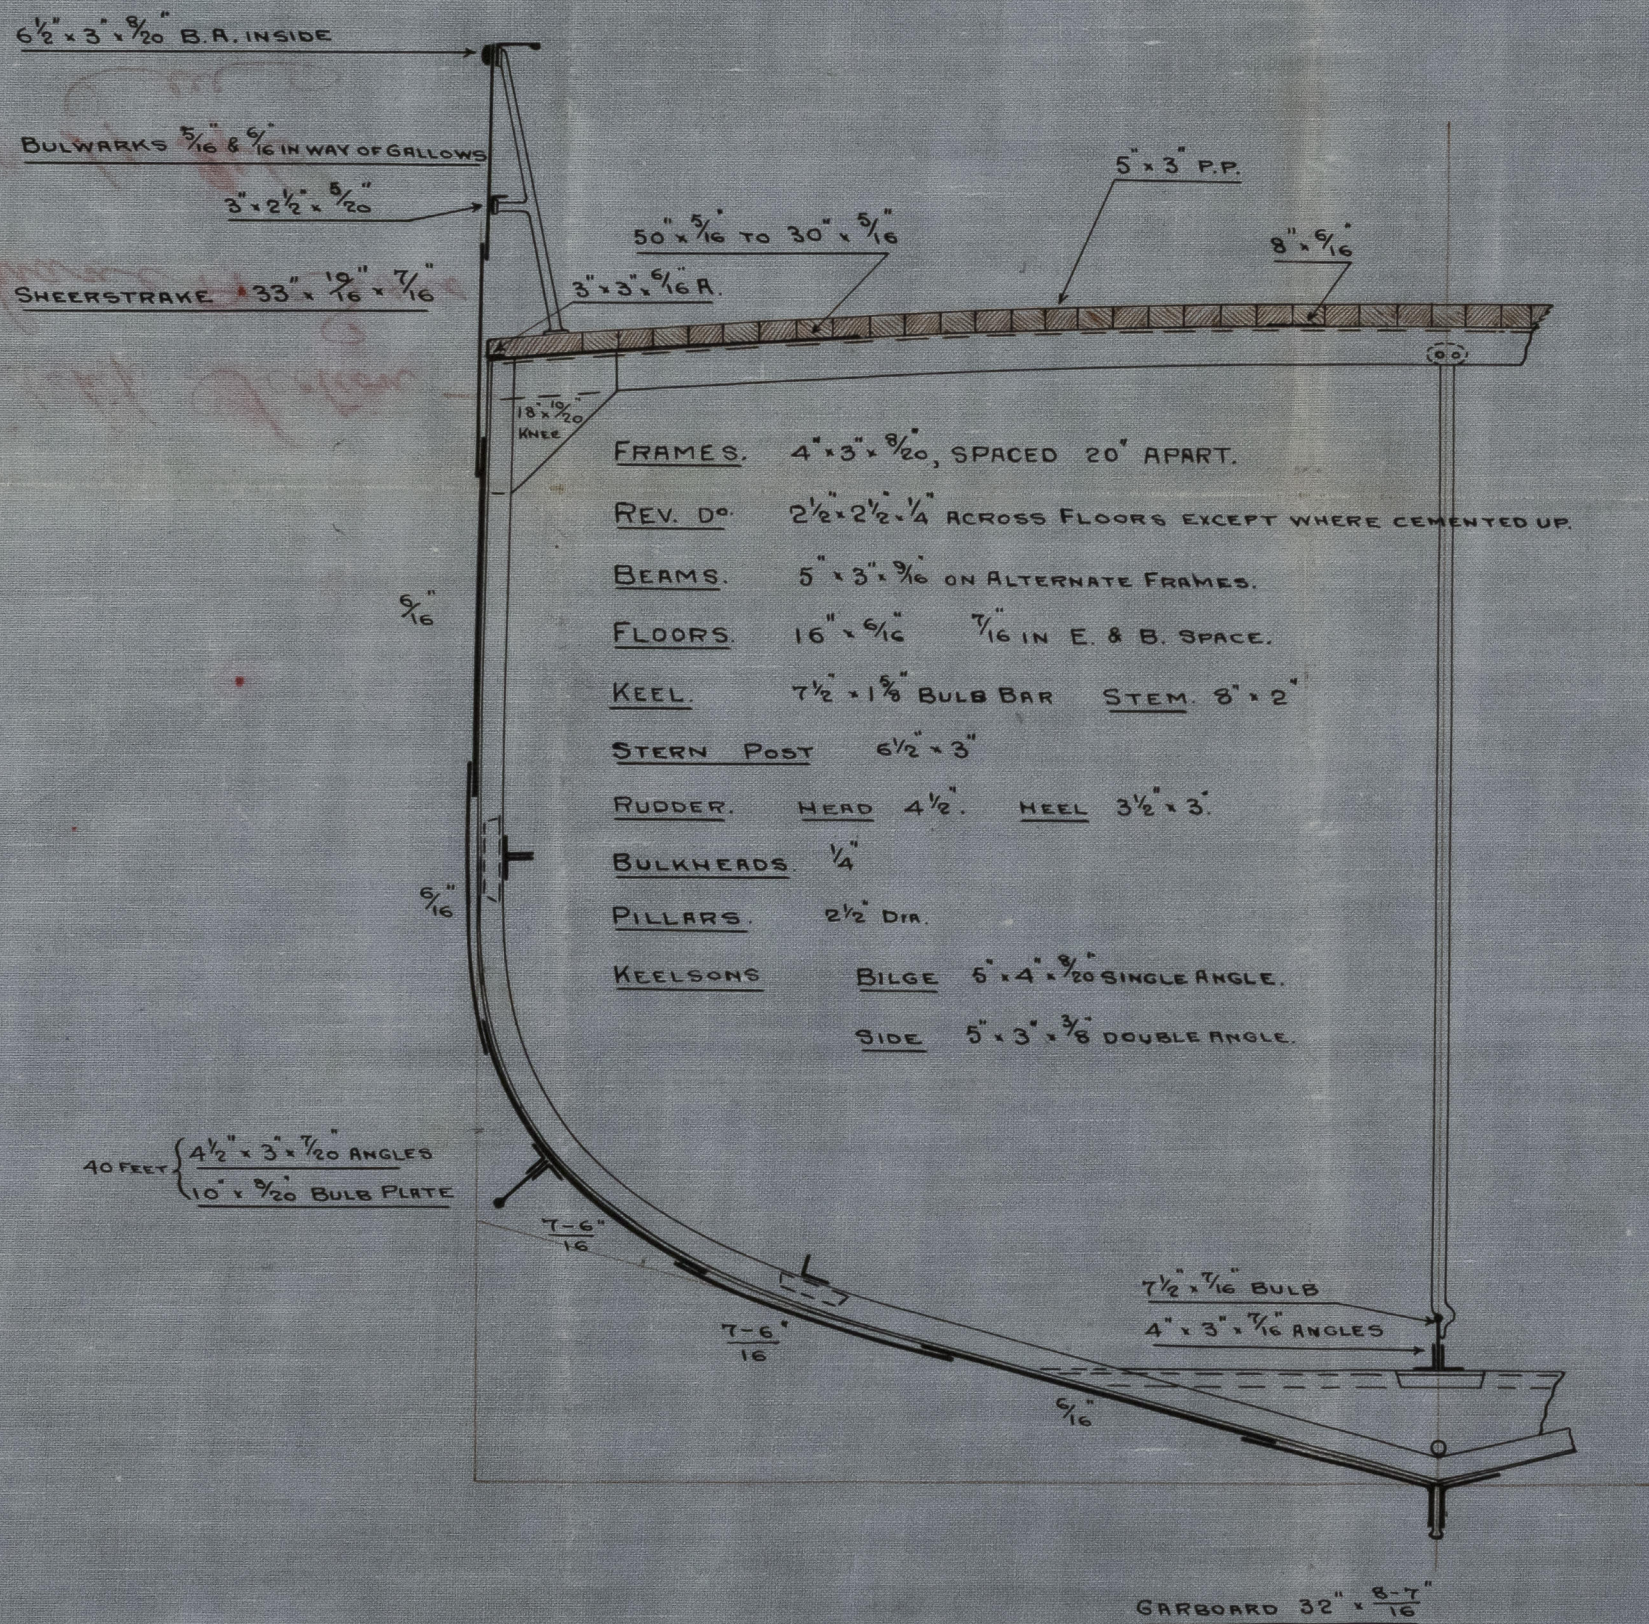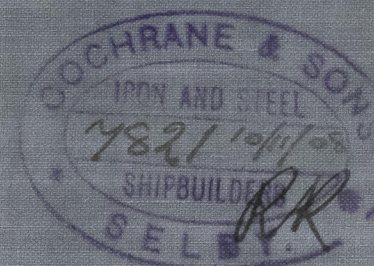

## LLOYDS NUMERALS

1/2 GIRTH	20.75
1/2 BREADTH	11.44
DEPTH	13.47
	45.66 1 <sup>st</sup> N <sup>o</sup>
LENGTH AS PER RULE	128.75
	5880.55 2 <sup>nd</sup> N <sup>o</sup>

## PROPORTIONS


L/D	9.5
L/B	5.6

## EQUIPMENT.

1 <sup>st</sup> BOWER ANCHOR	5 3/4 CWTs. EX STOCK
2 <sup>nd</sup> "	5 1/4 " " "
3 <sup>rd</sup> "	3 " " "
105 FATHOMS	1 1/16" CABLE
60 "	6" HAWSER
60 "	5" WARP

## RIVETING.

BUTTS OF SHELL PLATING LAPPED & DOUBLE RIVETED, EXCEPT GARBOARD & SHEERSTRAKES WHICH ARE TO BE STRAPPED. LANDINGS DOUBLE RIVETED. BULKHEADS SINGLE RIVETED BUTTS OF STRINGER & TIE PLATES OVERLAPPED & DOUBLE RIVETED.

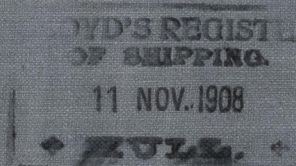

C.B. 12.11.08.



© 2020

006 361-006786-047 Register Foundation





— Midship Section —  
Cochrane & Sons

No 446  
Lee



s/s Scouber  
Hull Report No. 20992

15.11.08

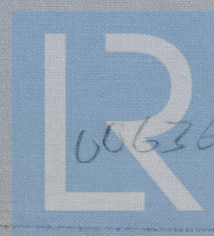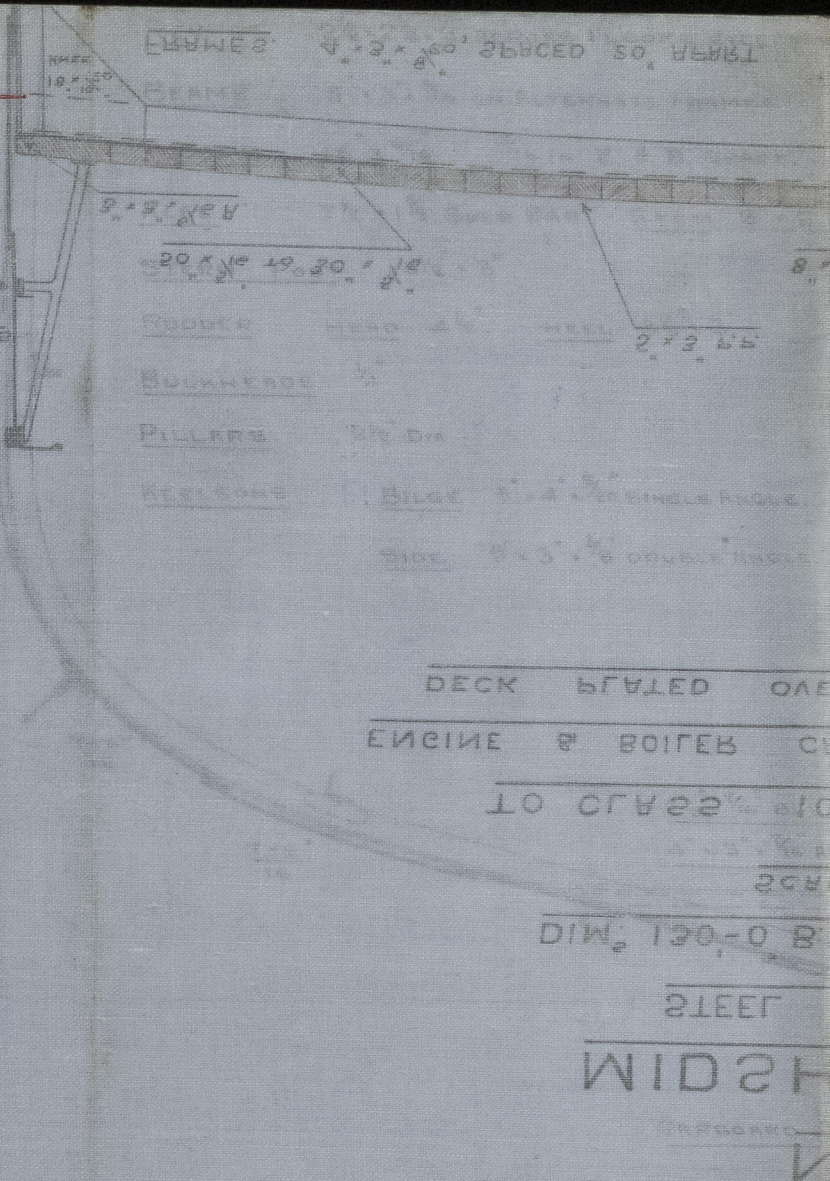

© 2020

006369-006386-0197  
Lloyd's Register  
Foundation