


12.11.08


Nº 446
— PROFILE & DECK PLAN —
DIM'S 130'-0" BP x 23'-0" EX x 13'-0" MOULDED
SCALE $\frac{1}{4}$ " = 1 FOOT



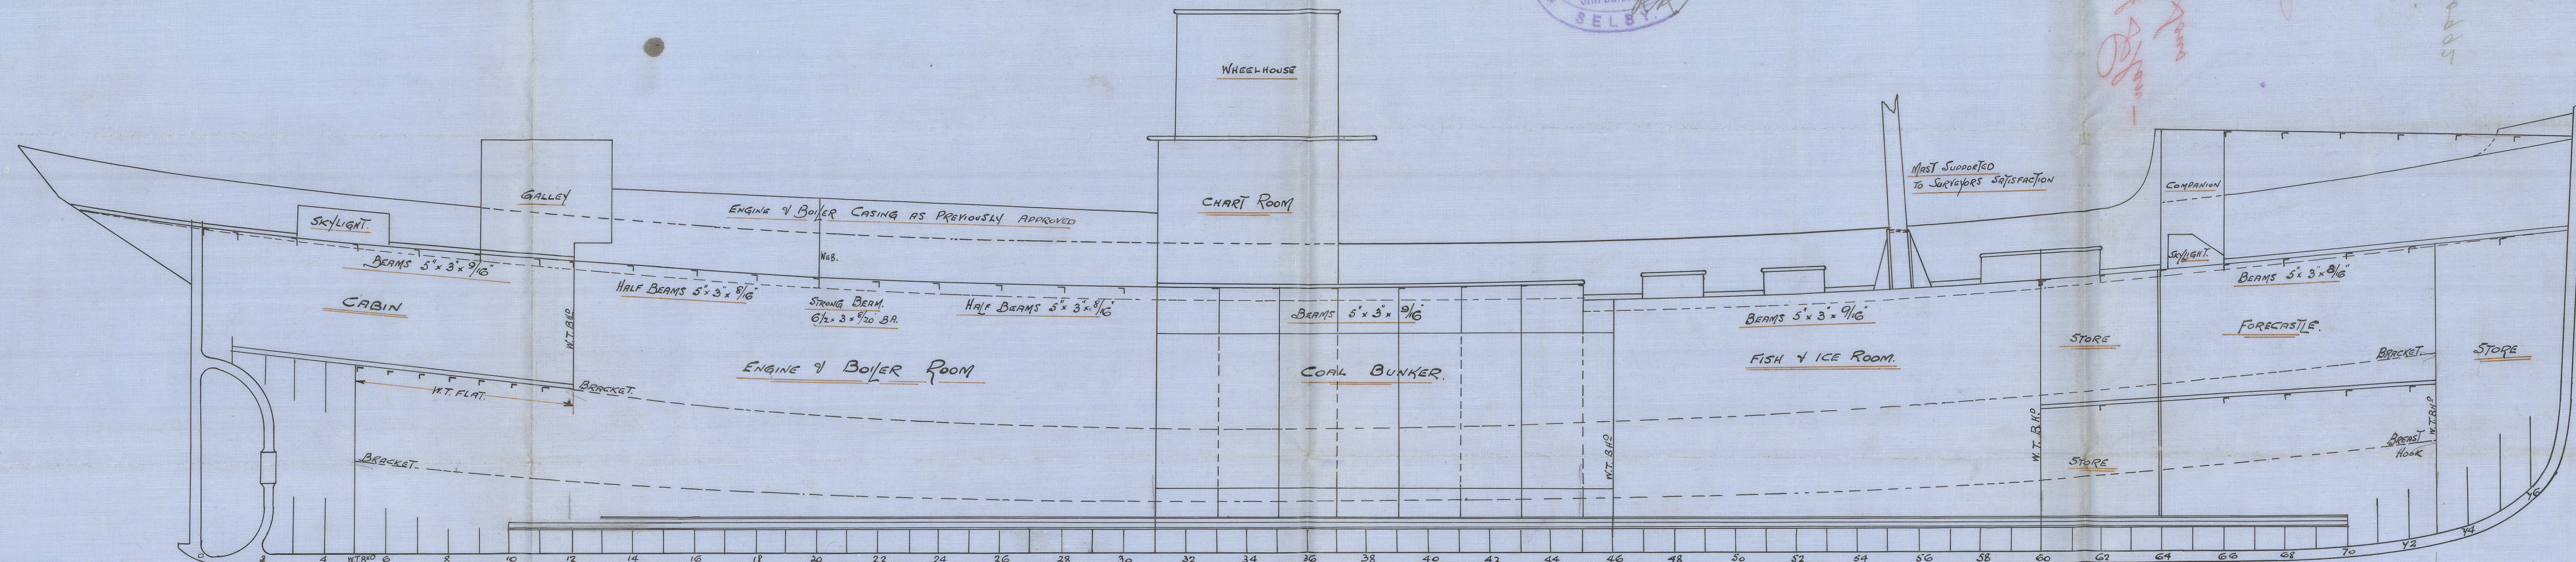

Pillaring arrangements throughout to Surveyors satisfaction

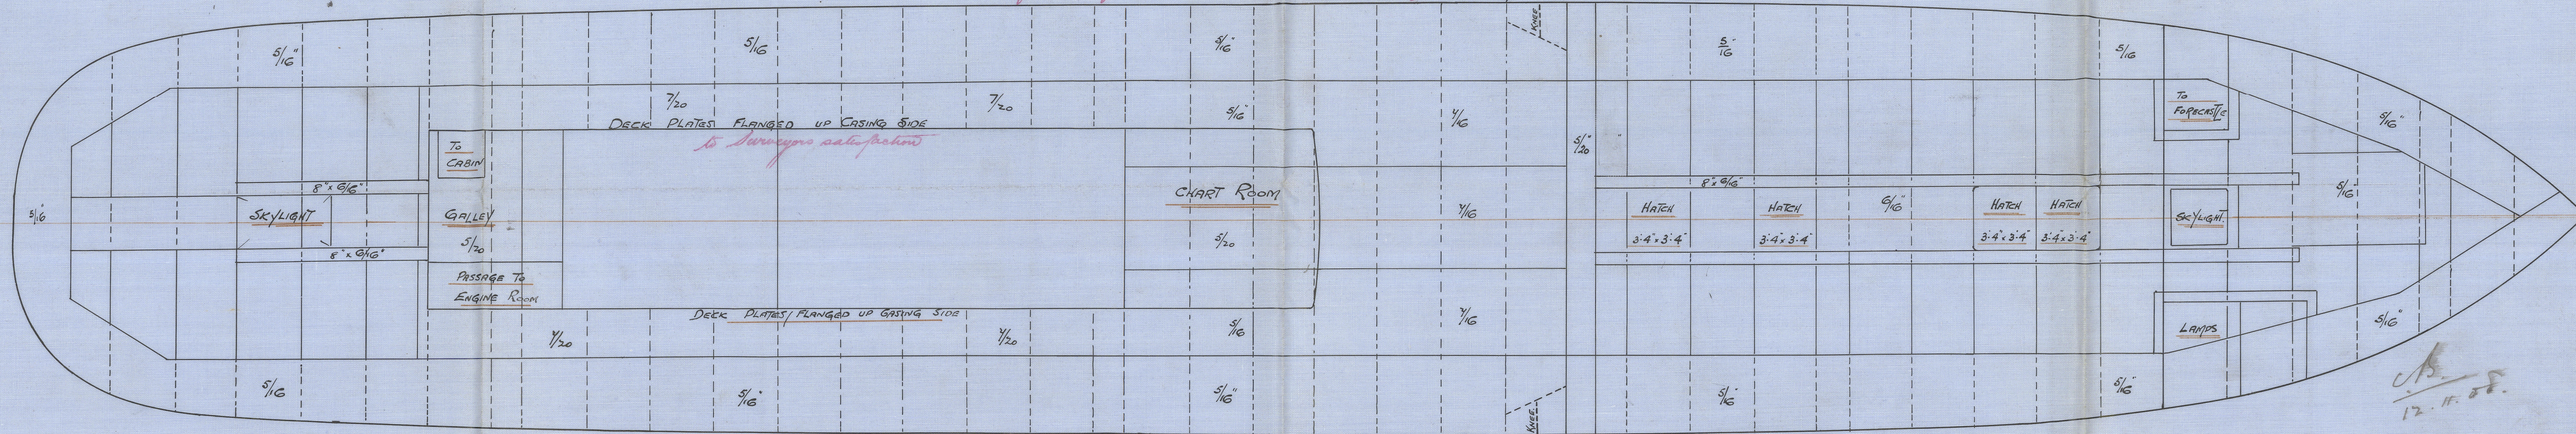

PILLARS THROUGHOUT TO SURVEYORS SATISFACTION.

YD'S REGIST.
OF SHIPPING.
11 NOV. 1908
HULL.


006364-06386-0148

- Profile & Deck Plan -
Cochrane & Sons

No 4 ~~46~~
u



s/s Scumber
Hull Report No. 20992

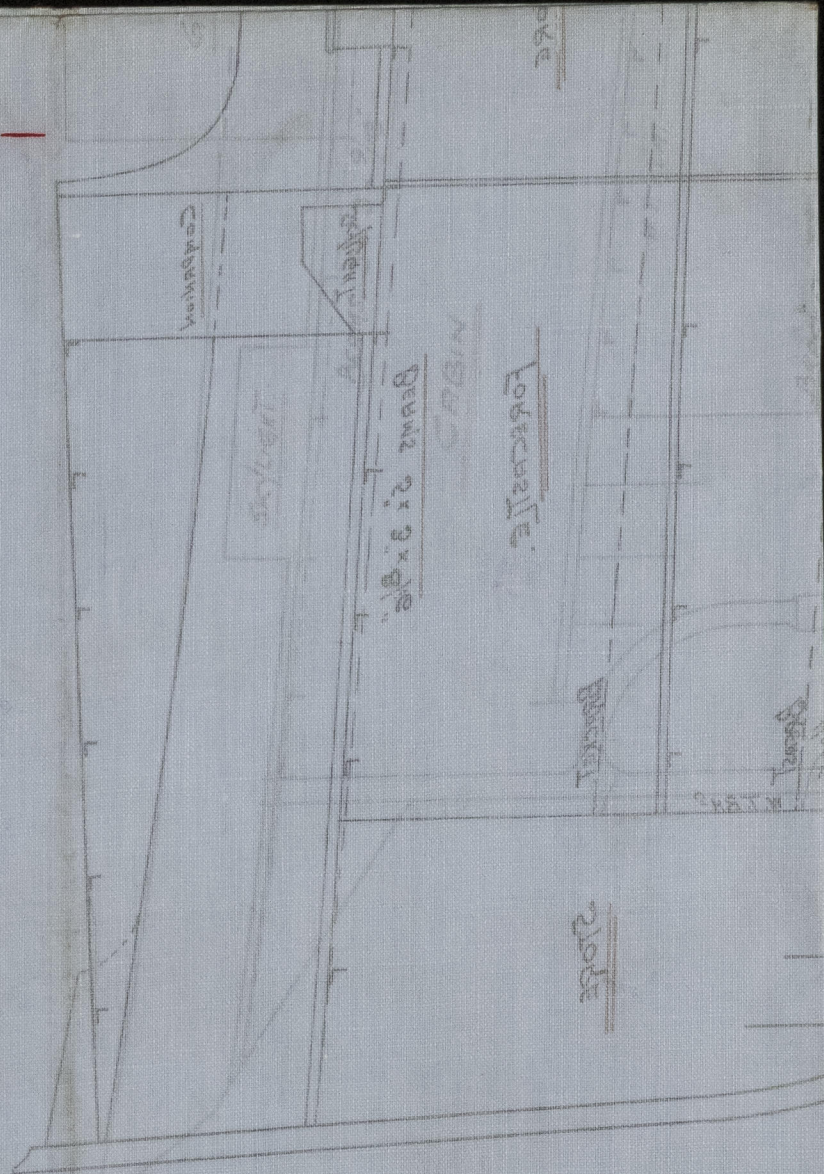

© 2020

006769-1063-148
Lloyd's Register
Foundation