
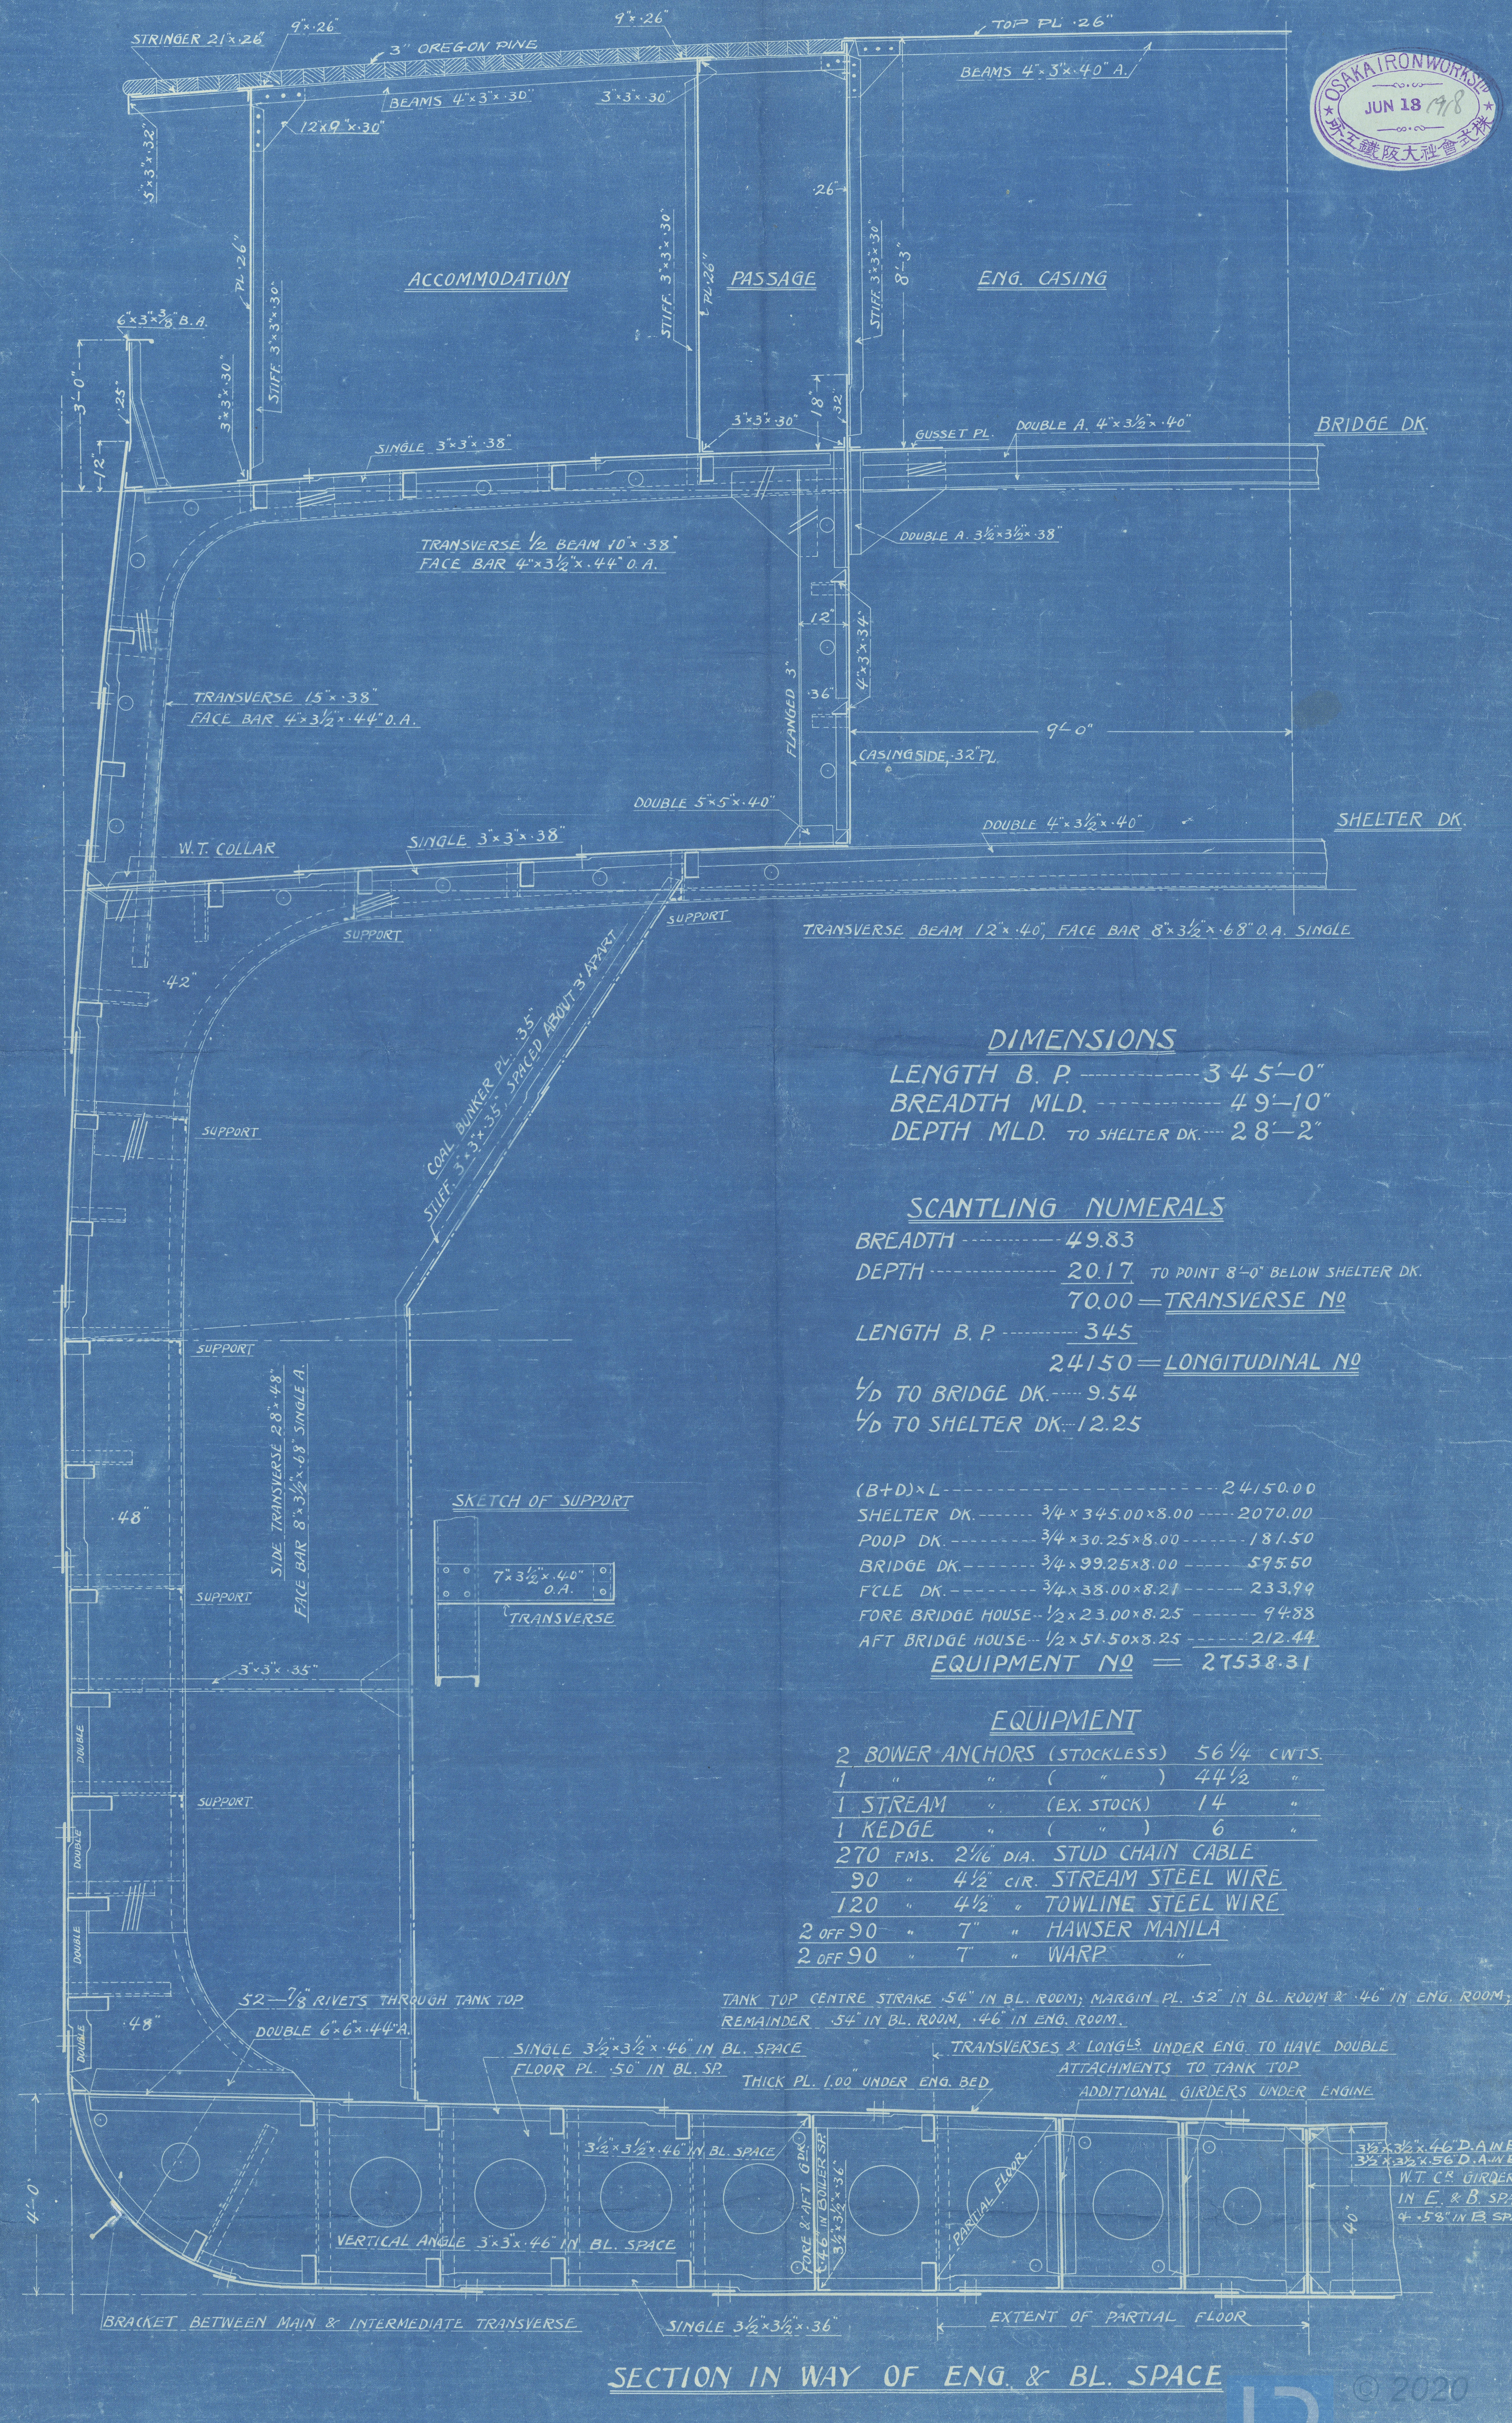


No 913

MIDSHIP SECTION

SCALE: 1/2" TO 1 FT.

TO CLASS+100 A.I. LLOYD'S
ISHERWOOD SYSTEM (PATENT)

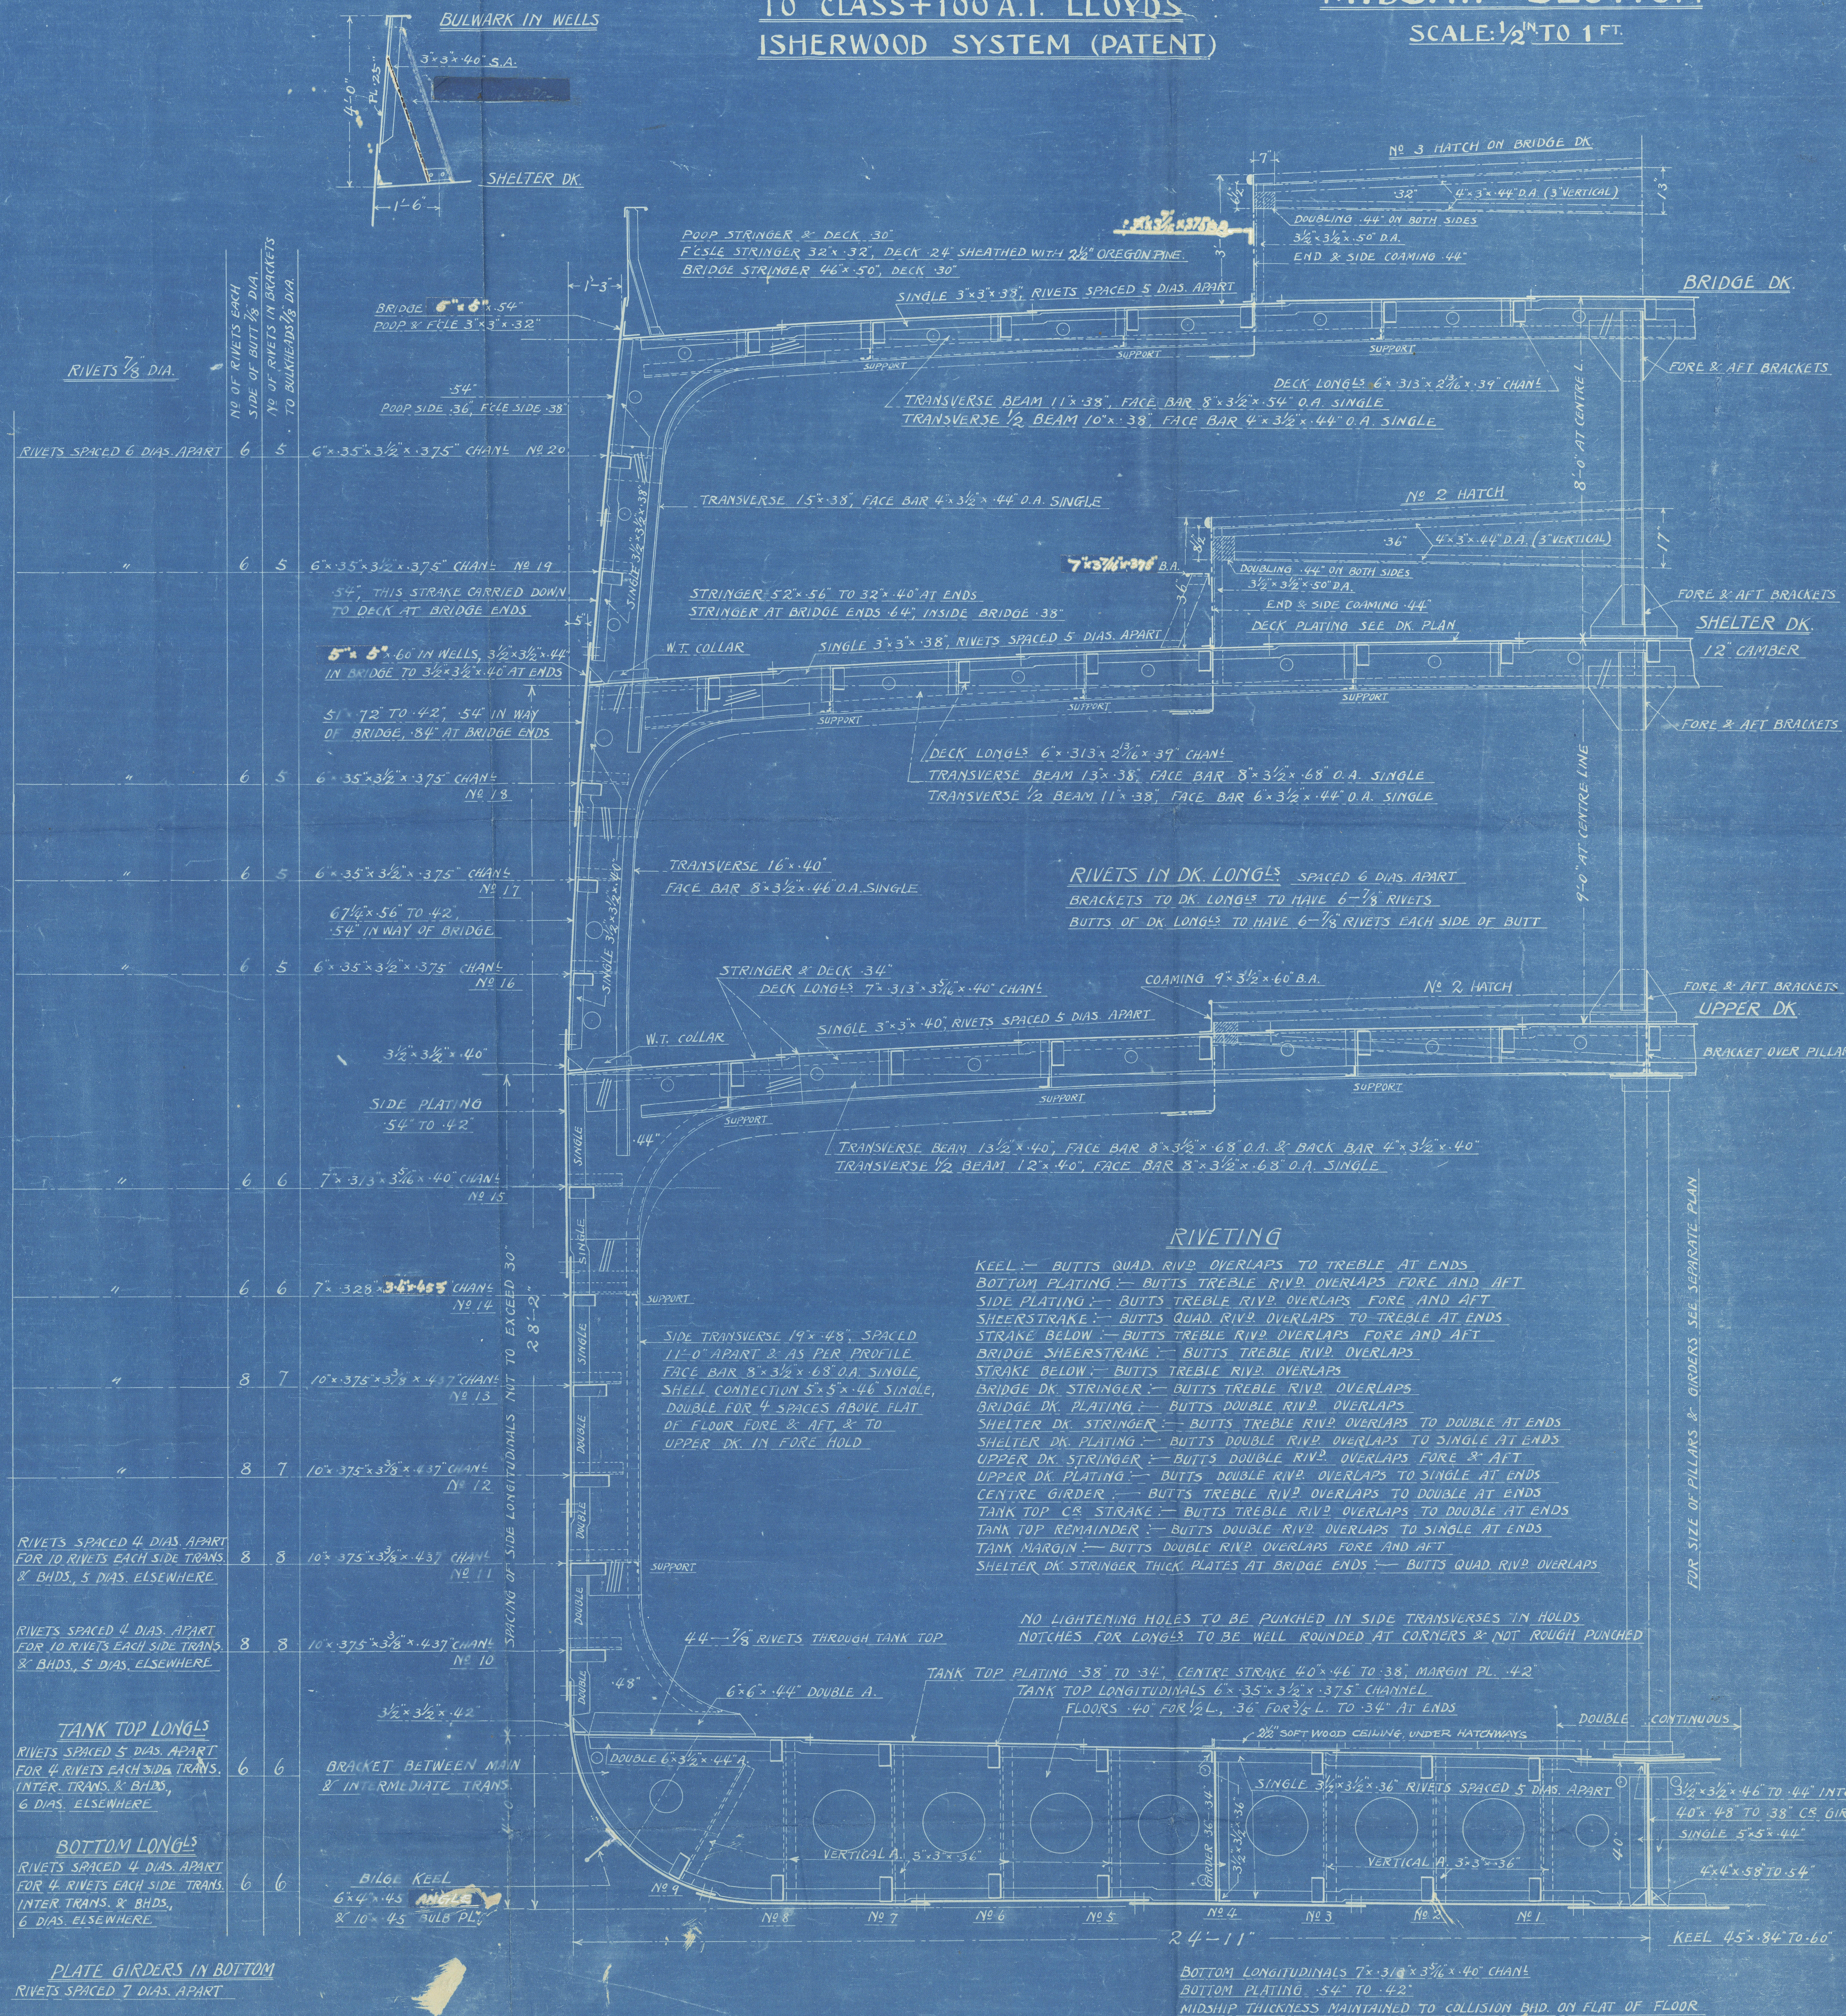

Ogata Iron Works
(Imnoshima Branch)
S. S. War Maid
No 913. Kobe 23/2



© 2020


Lloyd's Register
Foundation

006369-006386-0288

9/3 1/2

Midship section.

006364-006386-0288

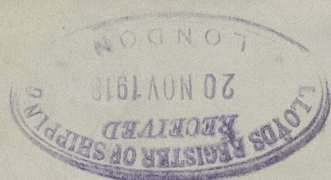

Midship section.



© 2020

Lloyd's Register
Foundation