
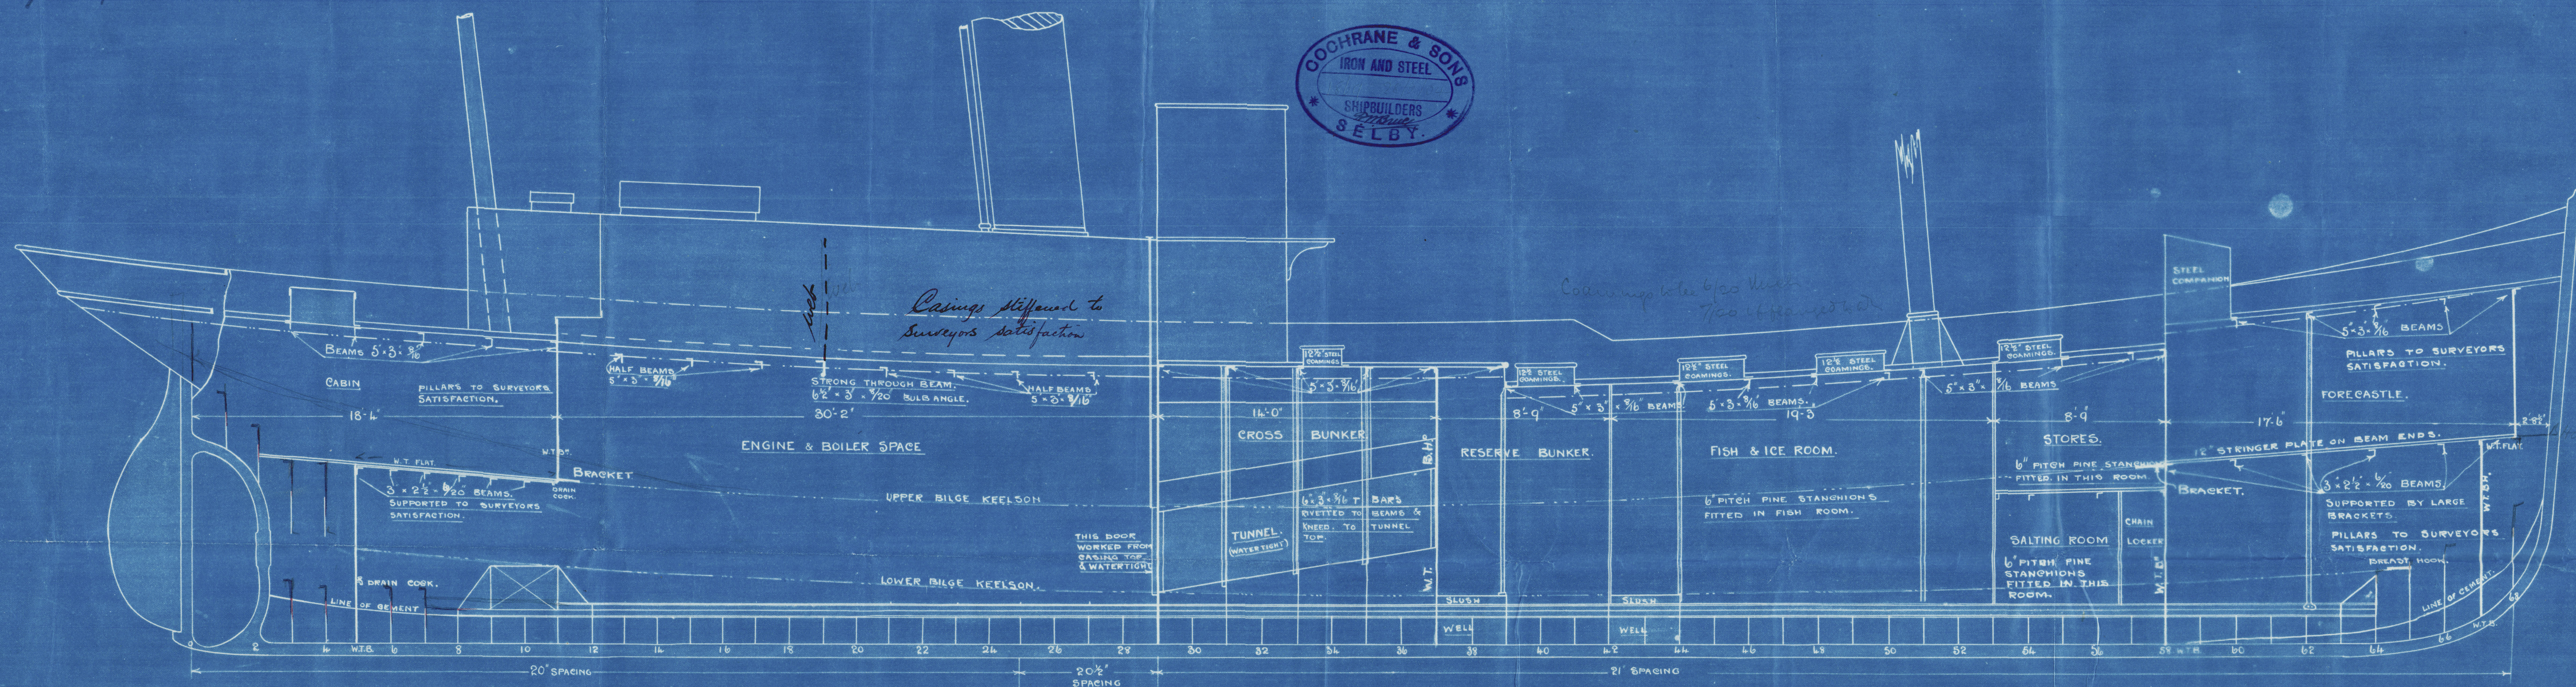


Nº 328.

120'-0" x 22'-0" x 12'-4" MLR.

SCALE $\frac{1}{4}'' = 1 \text{ FOOT.}$

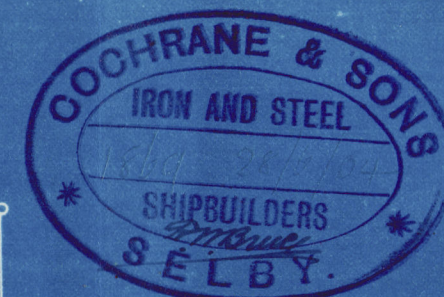


LLOYD'S REGISTER
OF SHIPPING.
29 JUN. 1904
+ HULL +

32

Profile & S'k Plan

Cochrane & Sons

No. 328 ^{s/s}

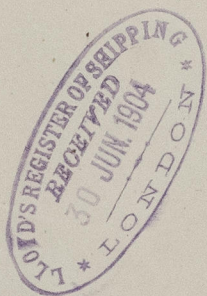

^{s/s} "Monarch"

Hull Rpt. No 16366



© 2020

Lloyd's Register

006387-006400-0002