

Checkers 59

ADMIRALTY DRIFTERS.

NOS 55 TO 66.



APPROVED BY LLOYDS.

16/5/17.

STERN & RUDDER

FORGING.

55.	"Indian Summer".	AB ^M REPORT N ^o 12032.
56.	"Leeward".	" " " 12033.
57.	"Snowdrift".	" " " 12052
58.	"Lull".	" " " 12053.
59.	"Lunar bow".	" " " 12090-
60.	"Landfall".	" " " 12091.
61.	"Moonbeam".	" " " "
62.	"Moonshine".	" " " "
63.	"Sunburst".	" " " "
64.	"Musk".	" " " "
65.	"Mirage".	" " " "
66.	"Mist".	" " " "

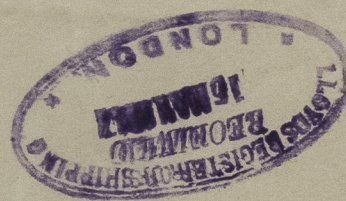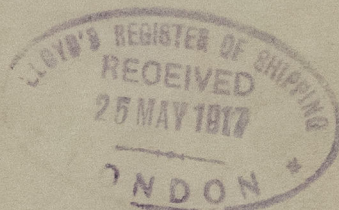

No frame but frame not fitted
Frame returned to London
A few measurements taken on
Stern, but tank broken
1917