

16.5.17

MIDSHIP SECTION STEEL SCREW DRIFTER

CLASS. LLOYDS. 100 A.I. FOR FISHING PURPOSES

DIMENSIONS

LENGTH B.P. ----- 86'-0"
BREADTH MOULDED ----- 18'-6"
DEPTH MOULDED ----- 10'-0"

EQUIPMENT

1 ANCHOR EX STOCK 3 1/2" C 1 ANCHOR EX STOCK 2" C
1 ANCHOR " 3 1/2" C 60 FATHOMS 1 1/2" CHAIN (STUD)
TO BE SUPPLIED BY ADMIRALTY
60 FATHOMS 5 1/2" HAWSE 60 FATHOMS 3" WARD

SCALE 3/4" INCH TO ONE FOOT

NUMERALS


TRANSVERSE N° (B+D) = 18.5 + 10.0 = 28.50

LONGITUDINAL N° L(B+D) = 86 x 28.5 = 2451

DEPTH "d" = 8.833

1/8 = 4.6

1/10 = 8.6

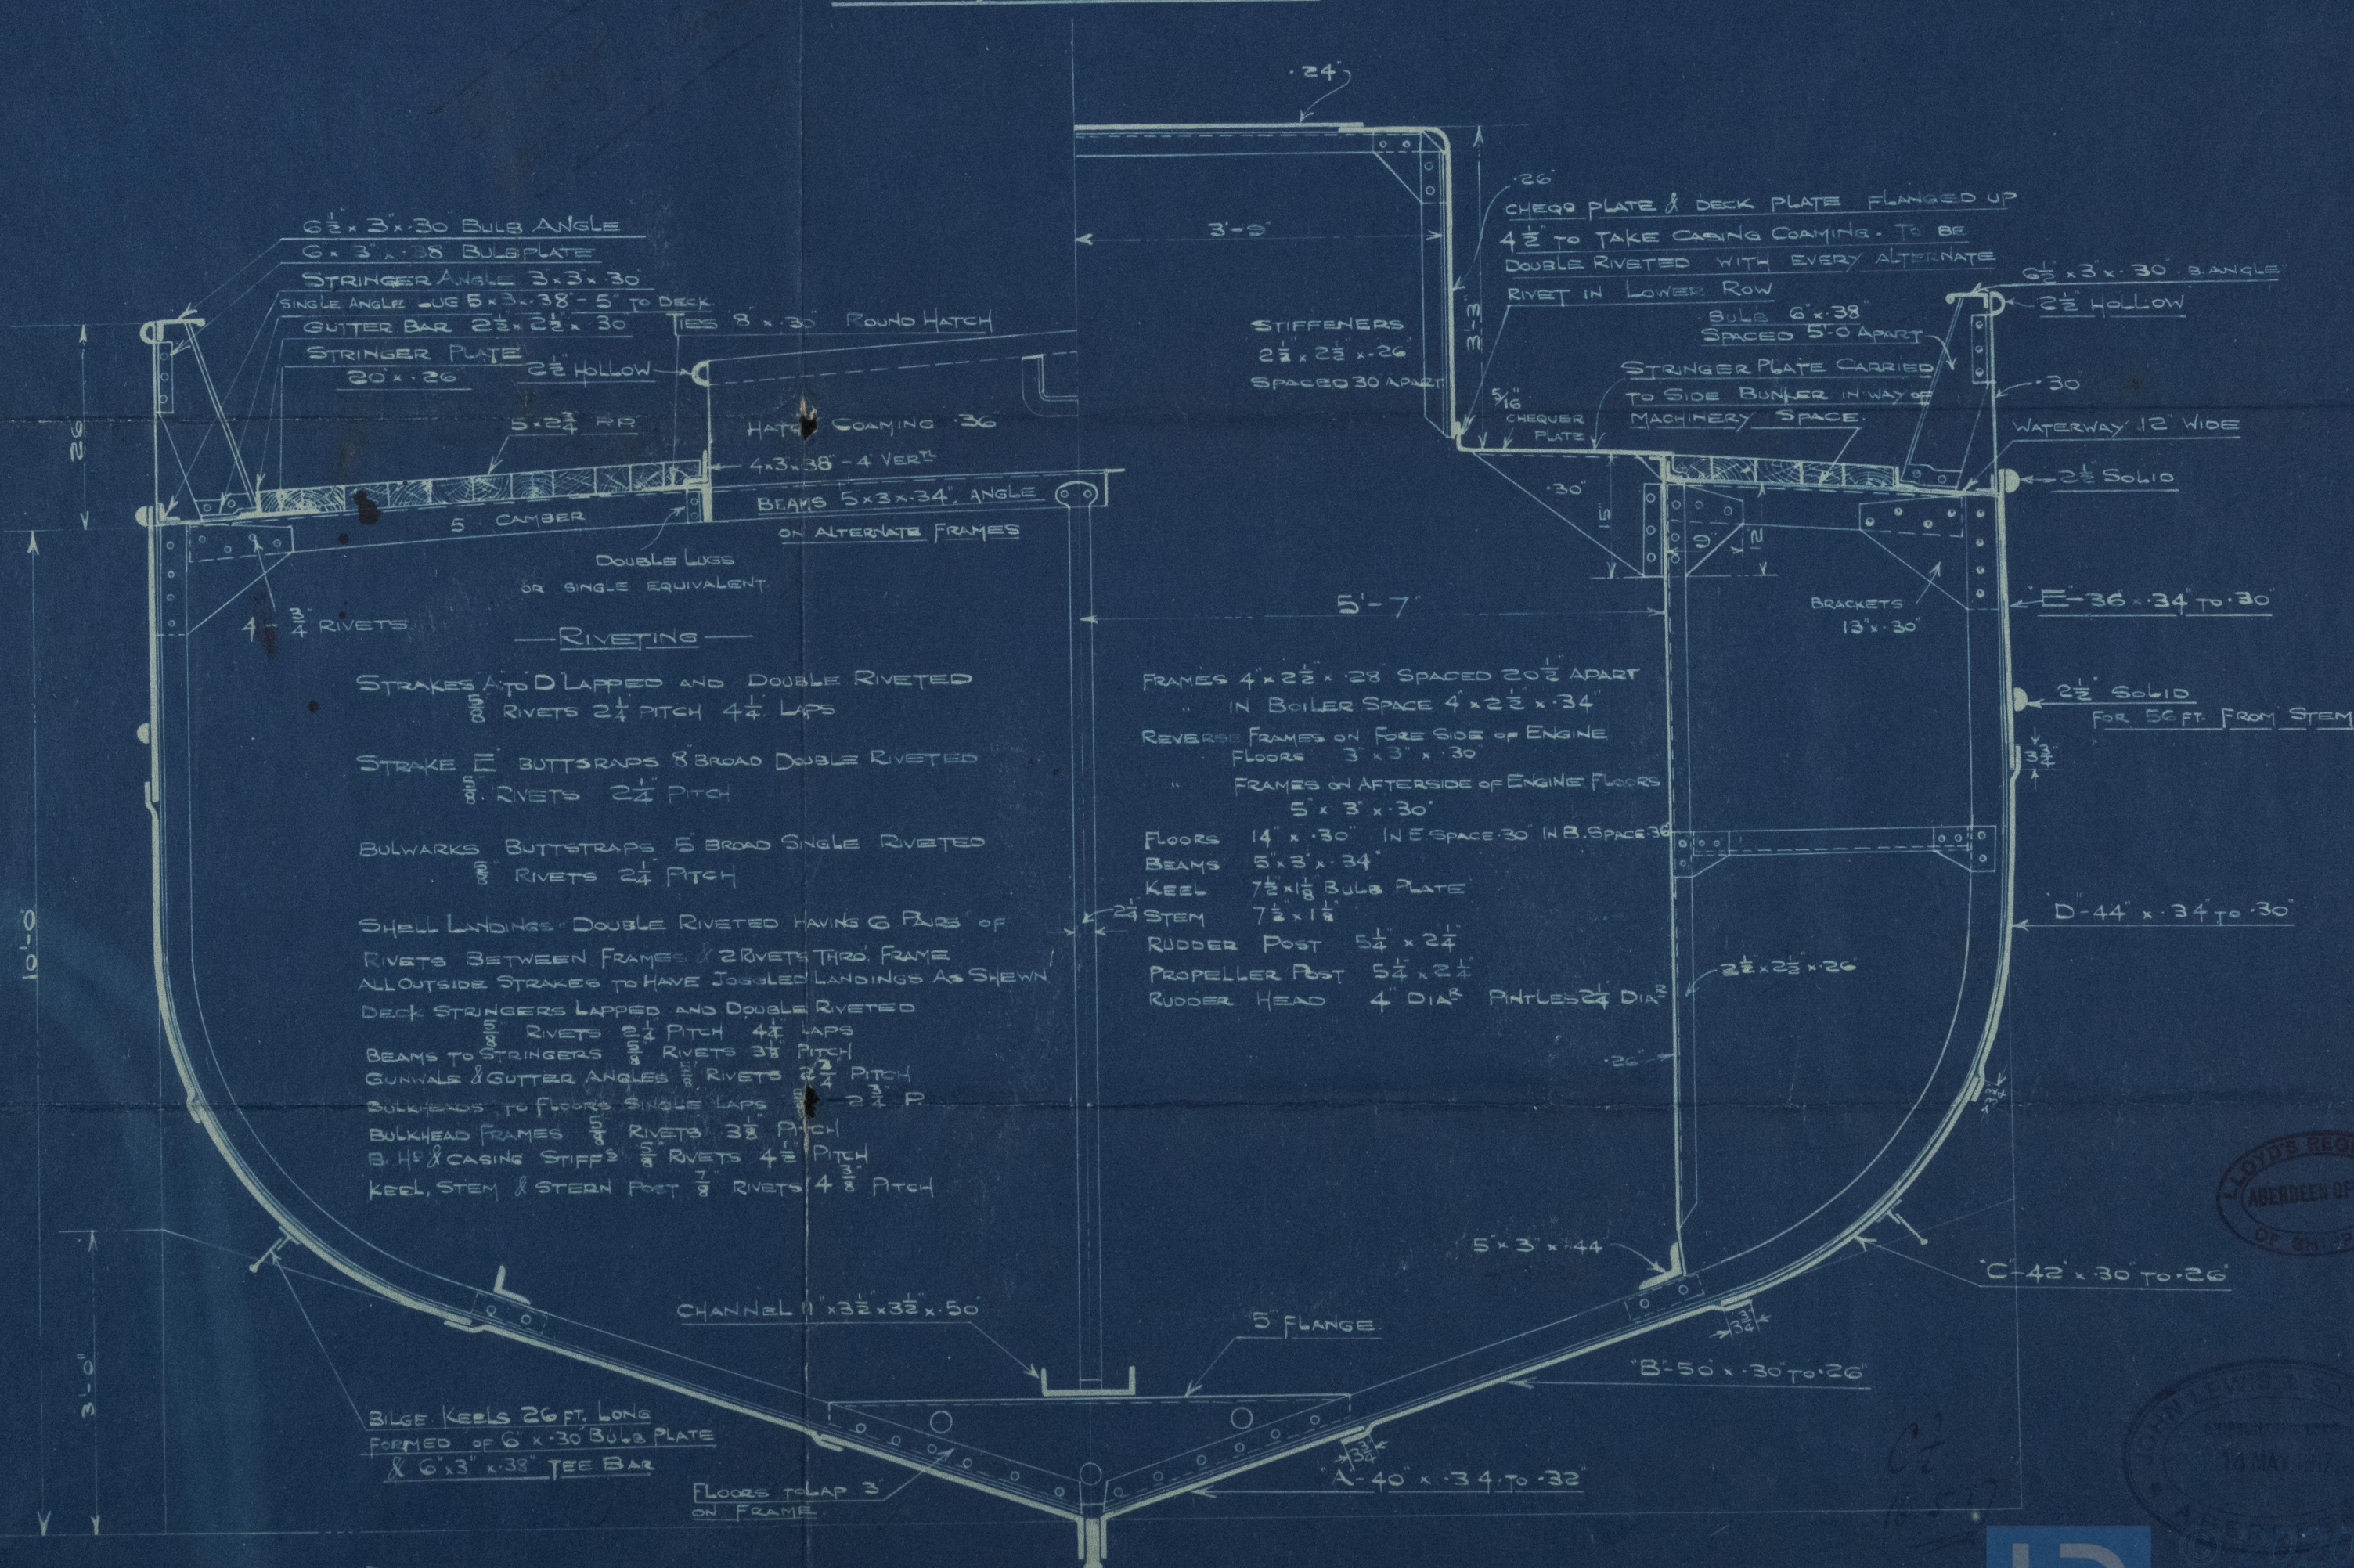

LLOYD'S REGISTER
ABERDEEN OFFICE
OF SHIPPING

JOHN LEWIS & SONS
10 MAY 1917
ABERDEEN

D.69 / 568



Lloyd's Register
Foundation

ADMIRALTY DRIFTERS.




N^{os} 55 TO 66.

APPROVED BY LLOYDS.

16/5/17.

MIDSHIP SECTION:

- | | | |
|-----|------------------|---|
| 55. | "Indian Summer." | AB ⁿ REPORT N ^o = 12032 |
| 56. | "Leeward." | " " " 12033. |
| 57. | "Snowdrift." | {Sled deck in this }
{following vessel.} 12052 |
| 58. | "Lull." | " " " 12053 |
| 59. | "Lunar Bow." | " " " 12090 |
| 60. | "Landfall." | " " " 12091. |
| 61. | "Moonbeam." | " " " |
| 62. | "Moonshine." | " " " |
| 63. | "Sunburst." | " " " |
| 64. | "Munk." | " " " |
| 65. | "Mirage." | " " " |
| 66. | "Mist." | " " " 12162 |

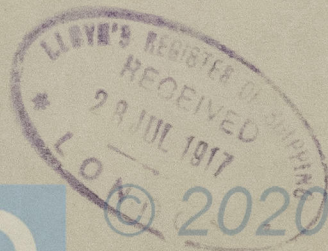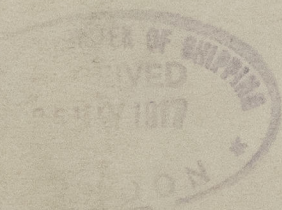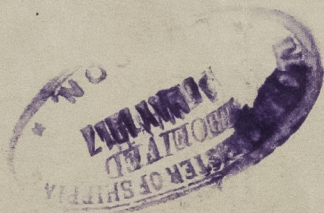

Lloyd's Register
Foundation

000387-006400-0056