


19/9/17

Nos 55 TO 66

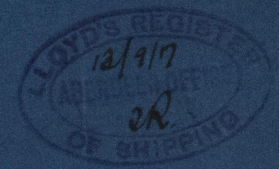


Made Subj. to Surveyor's Satisfaction.

Made Subj. to Surveyor's Satisfaction.

Made Subj. to Surveyor's Satisfaction.

- FRAME SPACING -	
FRS 1 TO 12	20"
FRS 12 TO 28	20 1/2"
FRS 28 TO 42	21"
FRS 42 TO 50	20 1/2"

PROFILE PLAN
STEEL SCREW DRIFTER
CLASS 100 A.1. LLOYDS FOR FISHING PURPOSES
SCALE 1/4" = ONE FOOT.

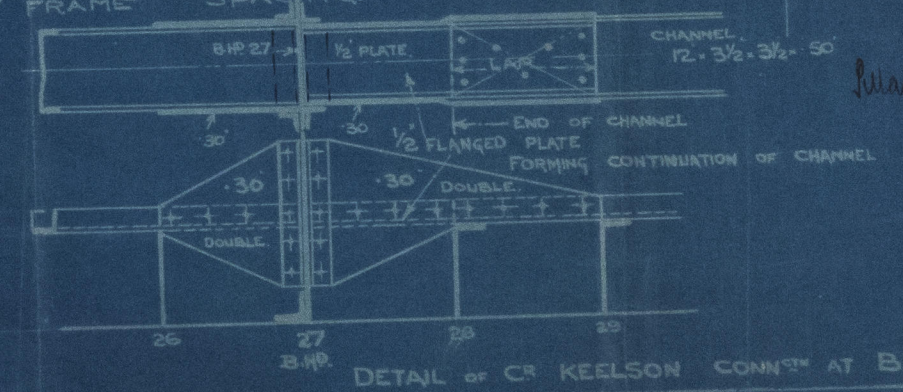

D.70 810.

006387-006400-0087



John Lewis & Sons Ltd

Nos. 55-66.

Admiralty Drifters

Profile

aberddeen Repal.
No.

55. "Indian Summer." = 12032

56. "Leeward." = 12033

57. "Snowdrift." = 12052

58. "Lull" = 12053

59. "Lunar Boia" = 12090

60. "Landfall" = 12091

61. "Moonbeam." =

62. "Moonshine." =

63. "Sunburst" =

64. "Musk." =

65. "Mirage" =

66. "Mist." =

© 2020

Lloyd's Register

0063870640-0057