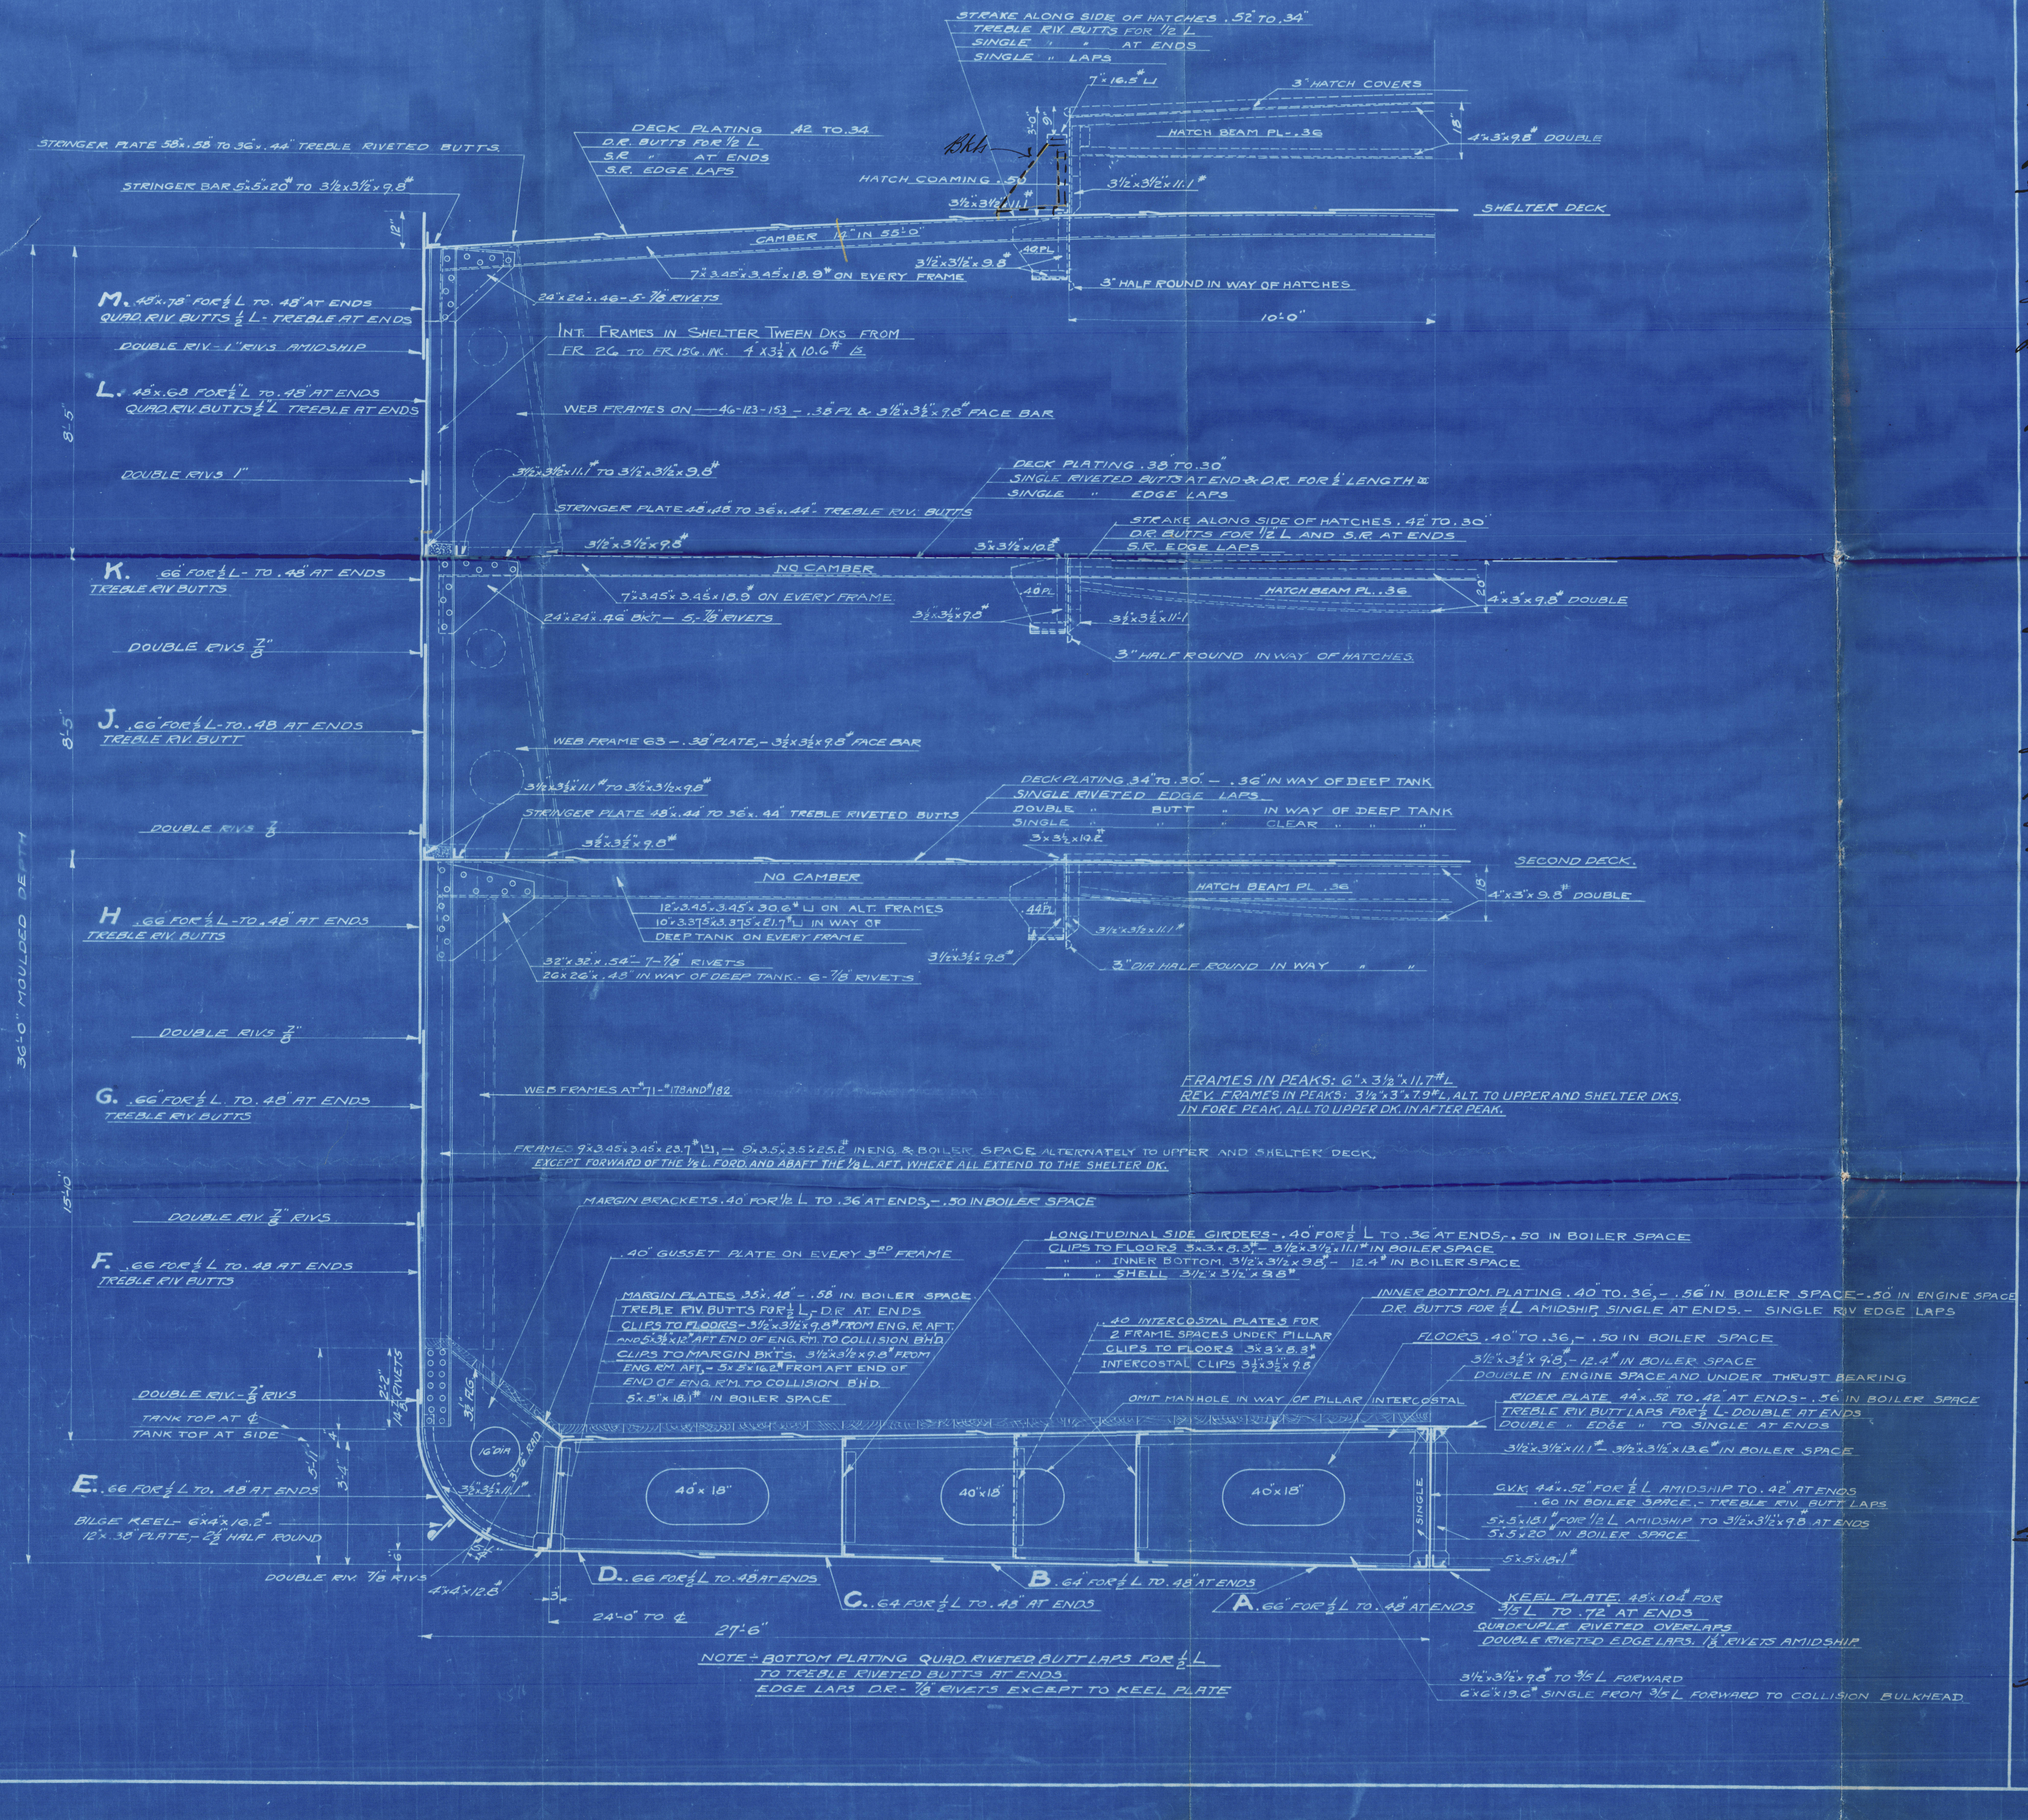

Dimensions

Length O.A.	439' 10"
" (Lloyd's)	434' 8½"
Beam (Mld.)	55' 0"
Depth (Mld.) to shelter dk.	36' 0"
" " to 8 ft. below "	28' 0"

Lloyd's Numerals

1st Numeral	55' + 28' = 83
2nd "	83 x 434'.7 = 35950
Depth (d)	15' 10"
Proportions to Shelter Dk. =	11.8

Equipment number

Plating number	35950
Deck houses	437
Shelter deck	3550
Equipment № =	38937

Equipment

2 Bower anchors	7616 stockless
1 " "	6550 "
1 stream "	2660 "
1 kedge "	1120 "
270 fms. 2 5/16" stud-link cable	
90 " of 5" sis. steel-wire stream	
120 " " 5 1/2" " " towline	
2 Hawsers 7" manila 90 fathoms each	
2 do 8" " 90 fathoms each	

ALTERATIONS

DESCRIPTION	DATE	APPD.
9-23-19 Intermediate Angle Frs. in Shelter Tween Dks. added.		JPS

Skinner & Eddy Corpn.
Seattle Wash.
Yard No. 74
S.S. "Robin Adair"
F100A1 shelter deck
with freeboard

HULLS № ~~[illegible]~~ 74
Dimensions
439' 8½" x 55'.0" x 36'.0" to Shelter Deck

73-74-75-76 8-8-19 BUILDERS ACCT

MIDSHIP SECTION.
Scale 1/2" = 1'-0" 8-8-19

SKL

6239 J100 H.1005