
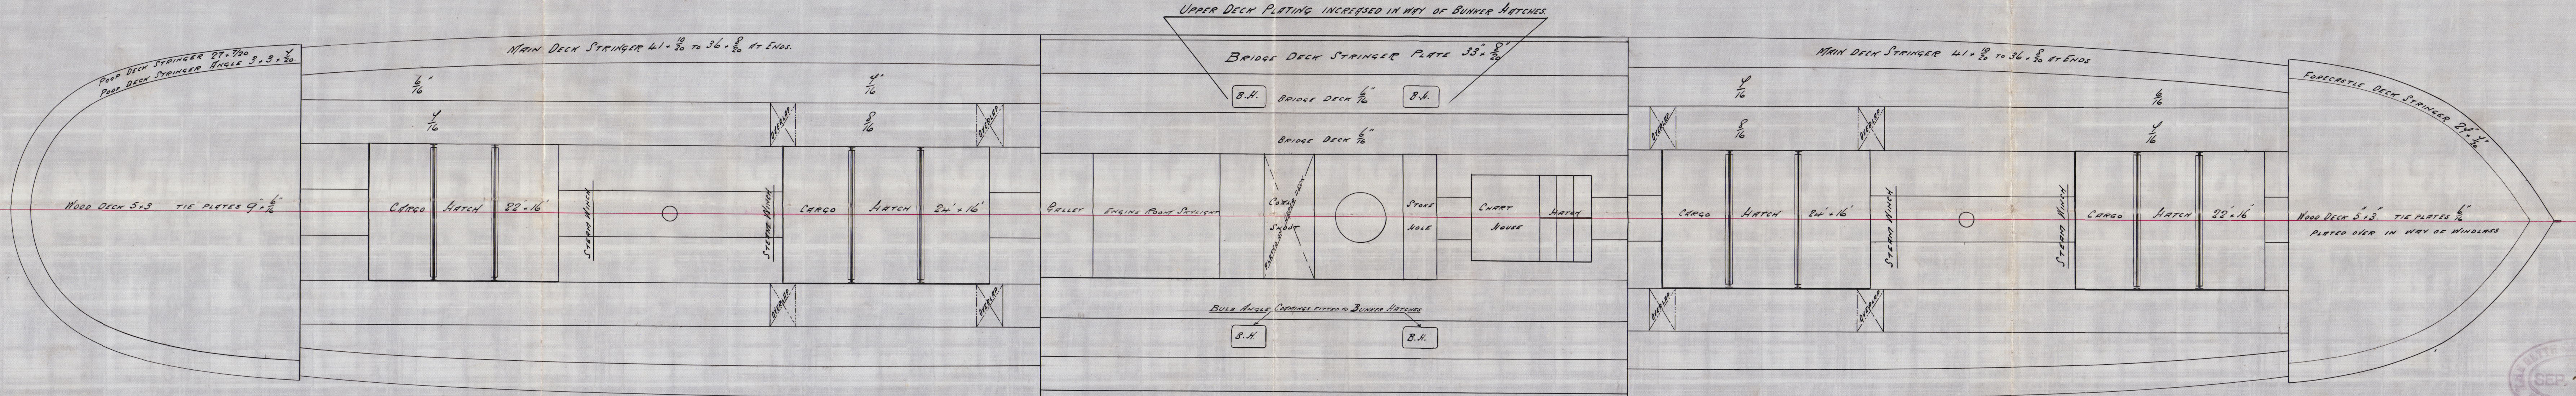


2.10.00  
14.11.00

# LONGITUDINAL SECTION S.S. N°107-8.

SCALE  $\frac{1}{8}$ " = 1 FOOT.

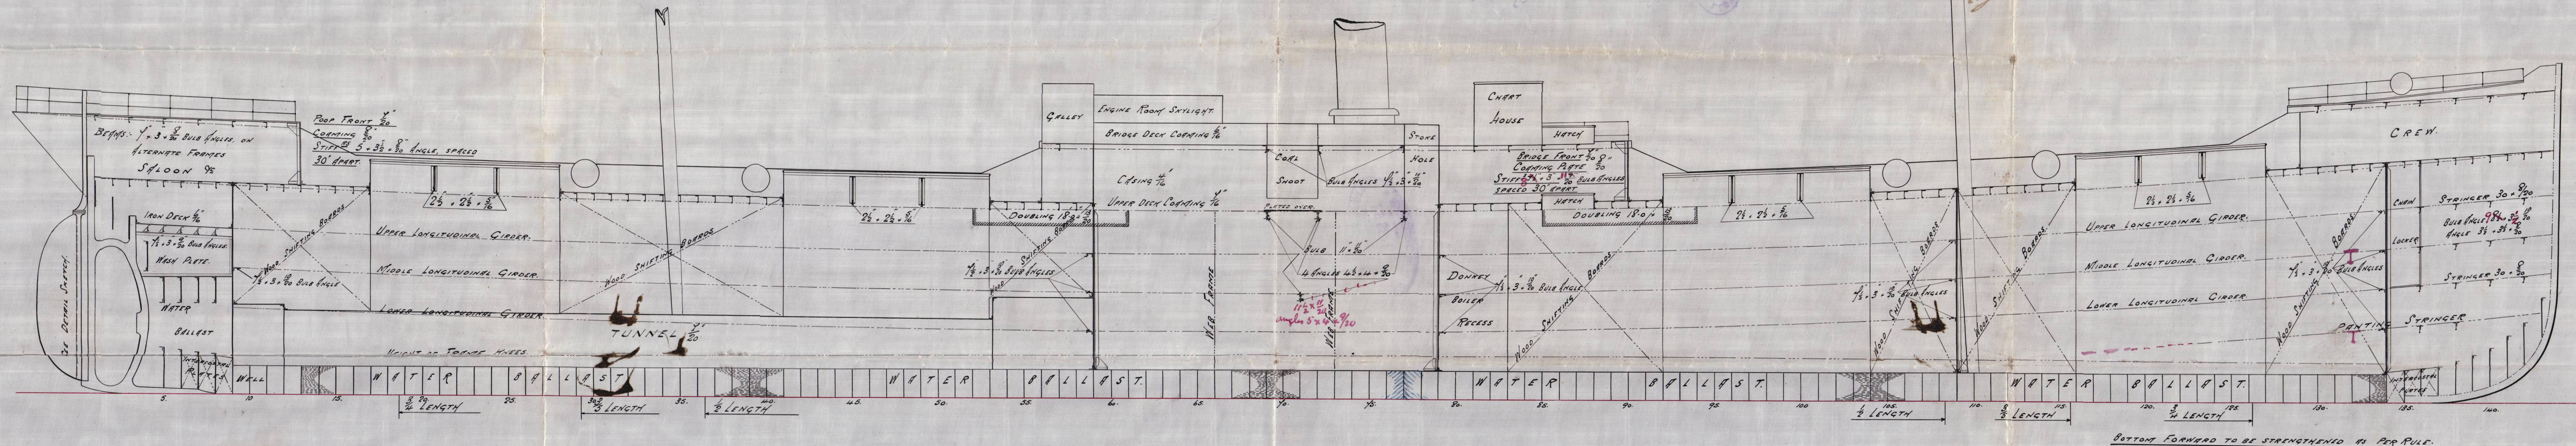

25/9/00  
J.C.R.

1.11.00  
2/10/00



Blyth S. B. Co

S. S. No 104-8

Profile


420



KITAKATA

MARU

D.S. 138

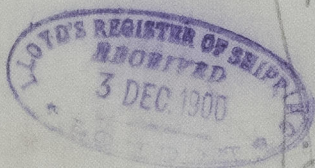

S.S. Battenhall

Newcastle Report

No 421759

S.S. Lady Mildred

Newcastle Report

No 43179



© 2020

Lloyd's Register  
Foundation

00 6387-000400