


2.10.00  
14.11.00

LENGTH. B. P. 287' 0."  
BREADTH EXT. 43.3.  
DEPTH MLD. 21.9.  
— CLASS: 100 A1. —  
SCALE :  $\frac{1}{2}" = 1 \text{ FOOT.}$

EQUIPMENT.		
2 BOWEN PICKERS .....	40 CENTS.	STUCKLESS.
1 " " .....	34 "	" "
1 STREAM " .....	10 1/2 "	EX. STOOK.
1 KEDGE " .....	5 1/2 "	" "
STEEL-CHAIN CABLE .....	240 FMS.	1 1/2 "
STEEL CHAIN .....	15 "	1 1/2 OR 4 1/2 STEEL WIRE.
TOWLINE .....	40 "	12 HEND OR 4 " "
2 HAWSERS .....	40 "	7 "
2 WHIPS .....	40 "	6 "

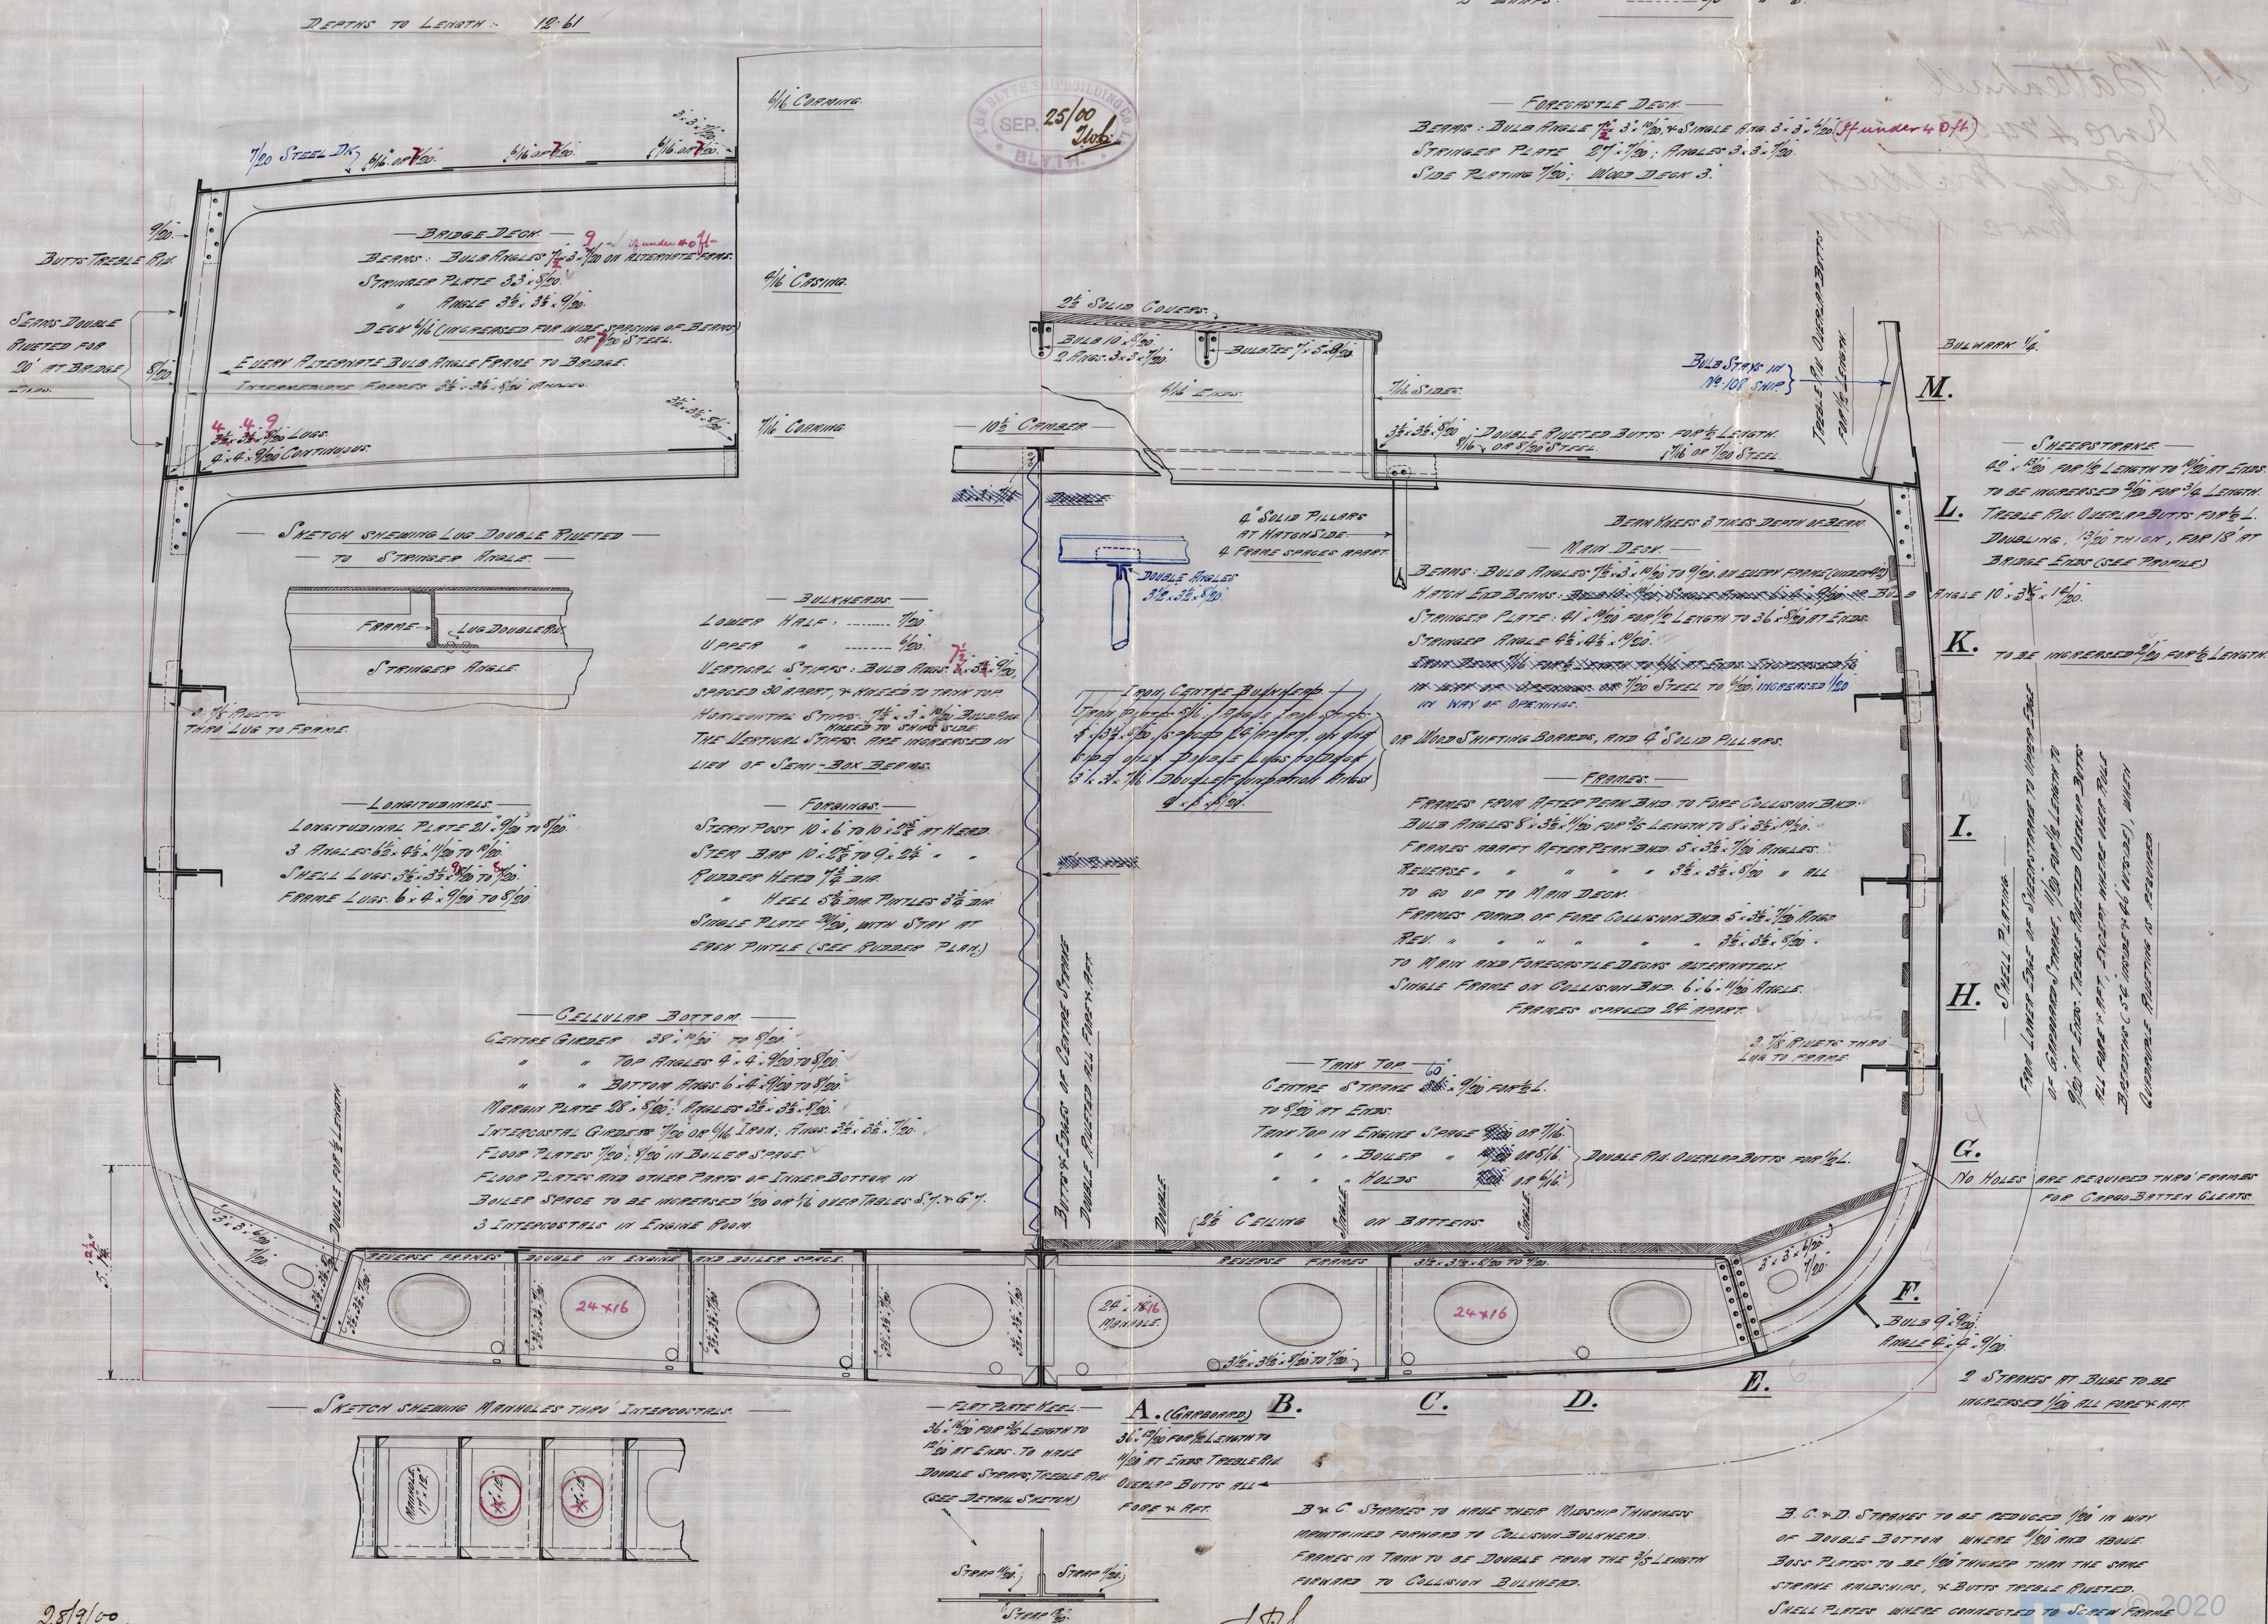



28/9/00  
J.C.H.



Blyth L. B. C?

N? 104-5

Midship Section

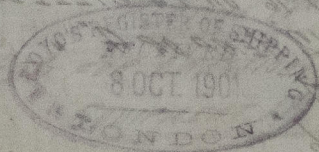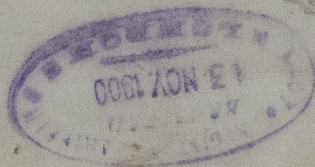

H. "Battenhall

Nwe 47459.

L. Lady Mildred

Nwe 43179.



© 2020

Lloyd's Register  
Foundation

006387006400-0186