

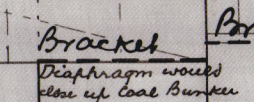


— Scale $\frac{1}{4}$ Inch = One Foot. —

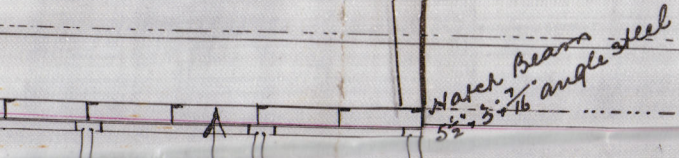

Wal
8/31/96

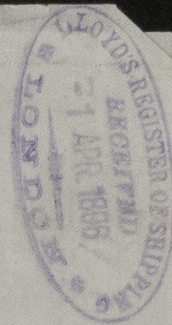

S. S. "Joseph Fisher" Glasgow Report
No. 14, 654.

006401-006406-0048

© 2020

Lloyd's Register
Foundation

Dunleith

006401-006406-0048



© 2020

Lloyd's Register
Foundation

*37