


PUMPING ARRANGEMENT - ENGINES N°696

SCALE 1/2" = 1 FOOT

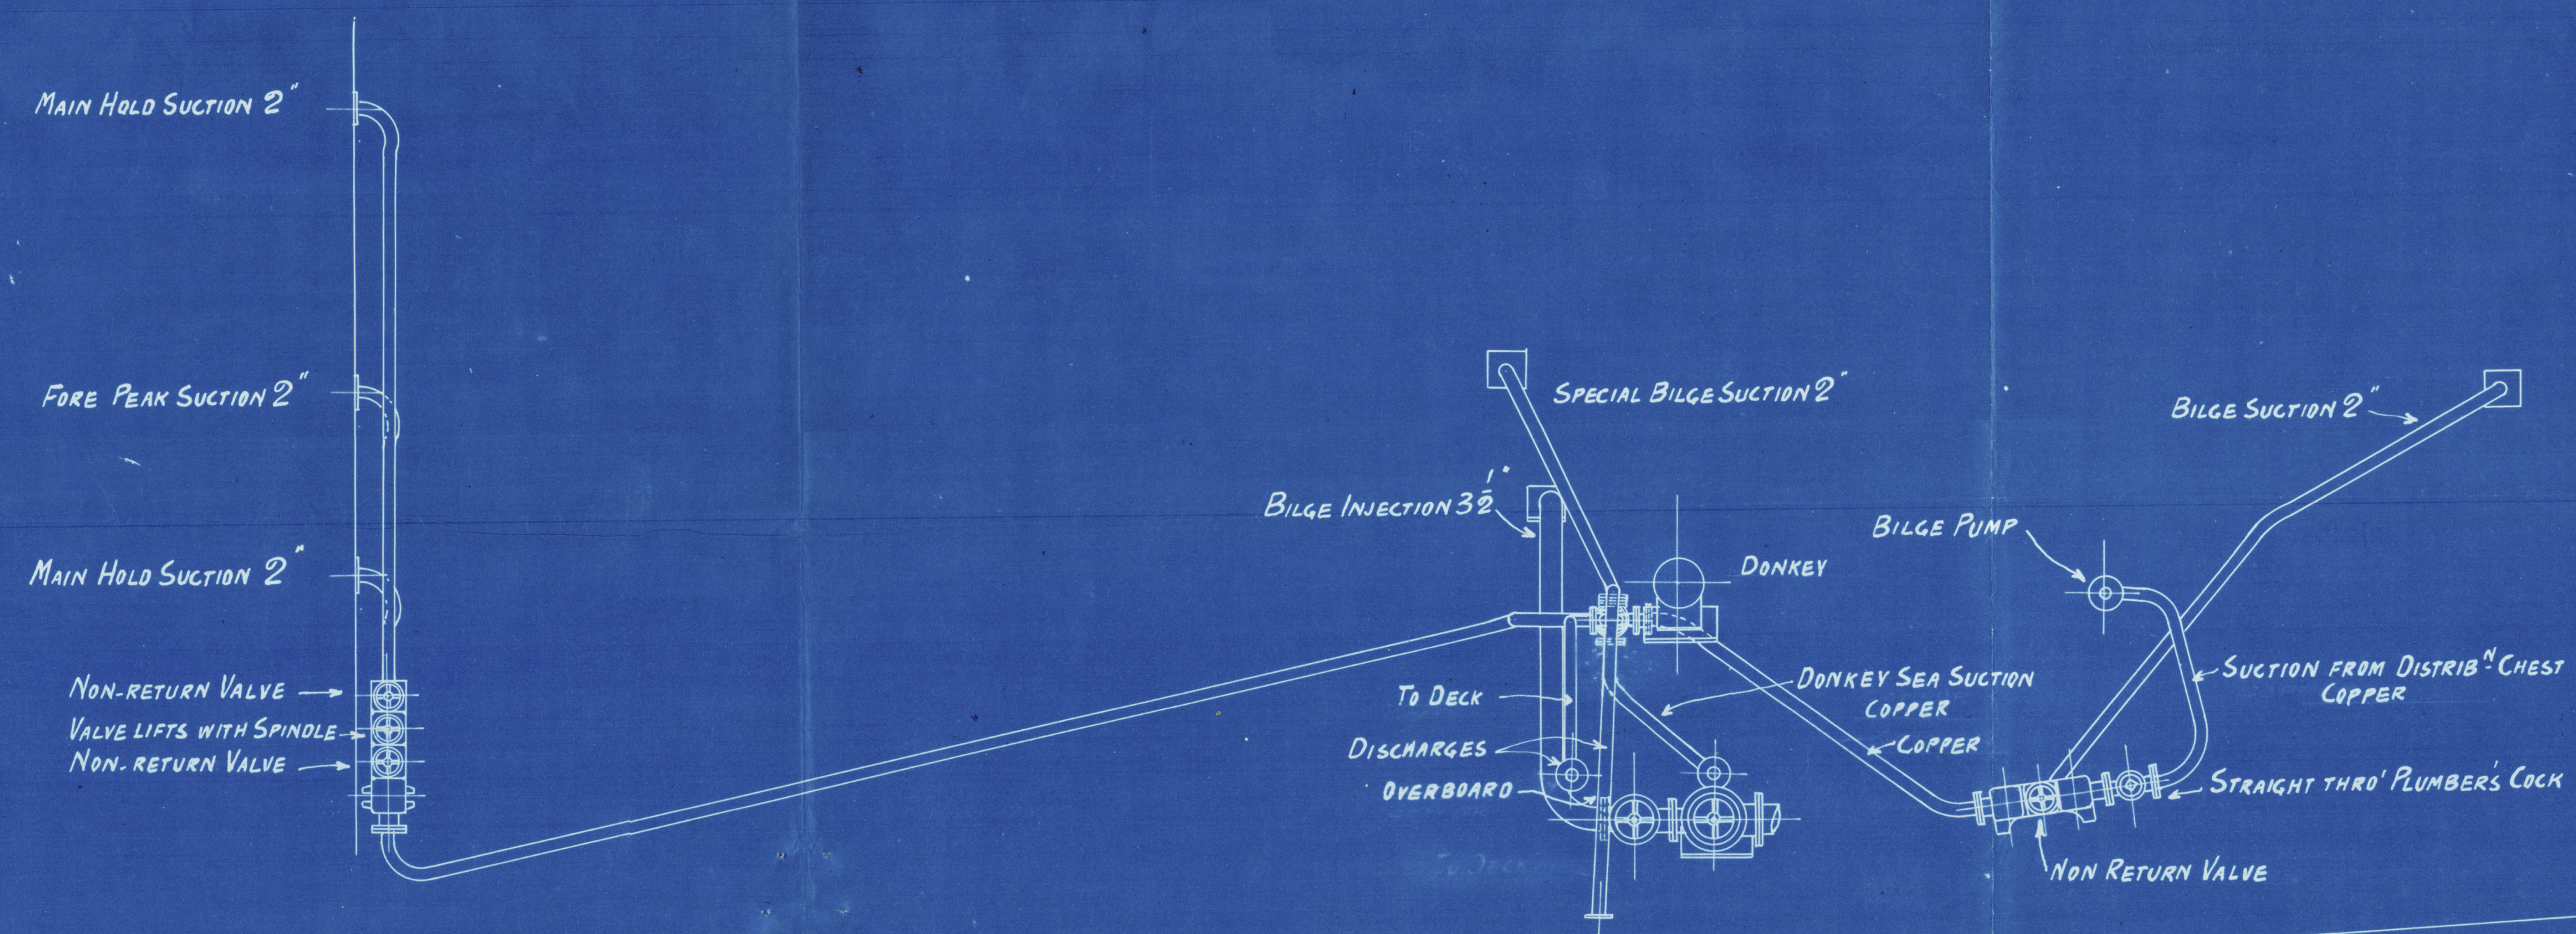

Amended plan
as now fitted
Crt'd 14/8/96

J. Fullerton
No 133
East Brown Butter
No 6-96
Amended Pumping
Plan
S. S. Joseph Fisher
of Newry
Glasgow Report
No 14658, -



© 2020

Lloyd's Register
Foundation

006401-006406-0049