


SECTION THROUGH STATIONARY FAIRWATER PIPE.  
SCALE 1/2"=1'-0"

NOTE: U.S. FAIRWATER TO BE FURNISHED BY OWNERS & INSTALLED BY CONTRACTOR.

*J. S. Irwin*  
Mobile, Ala.  
1338

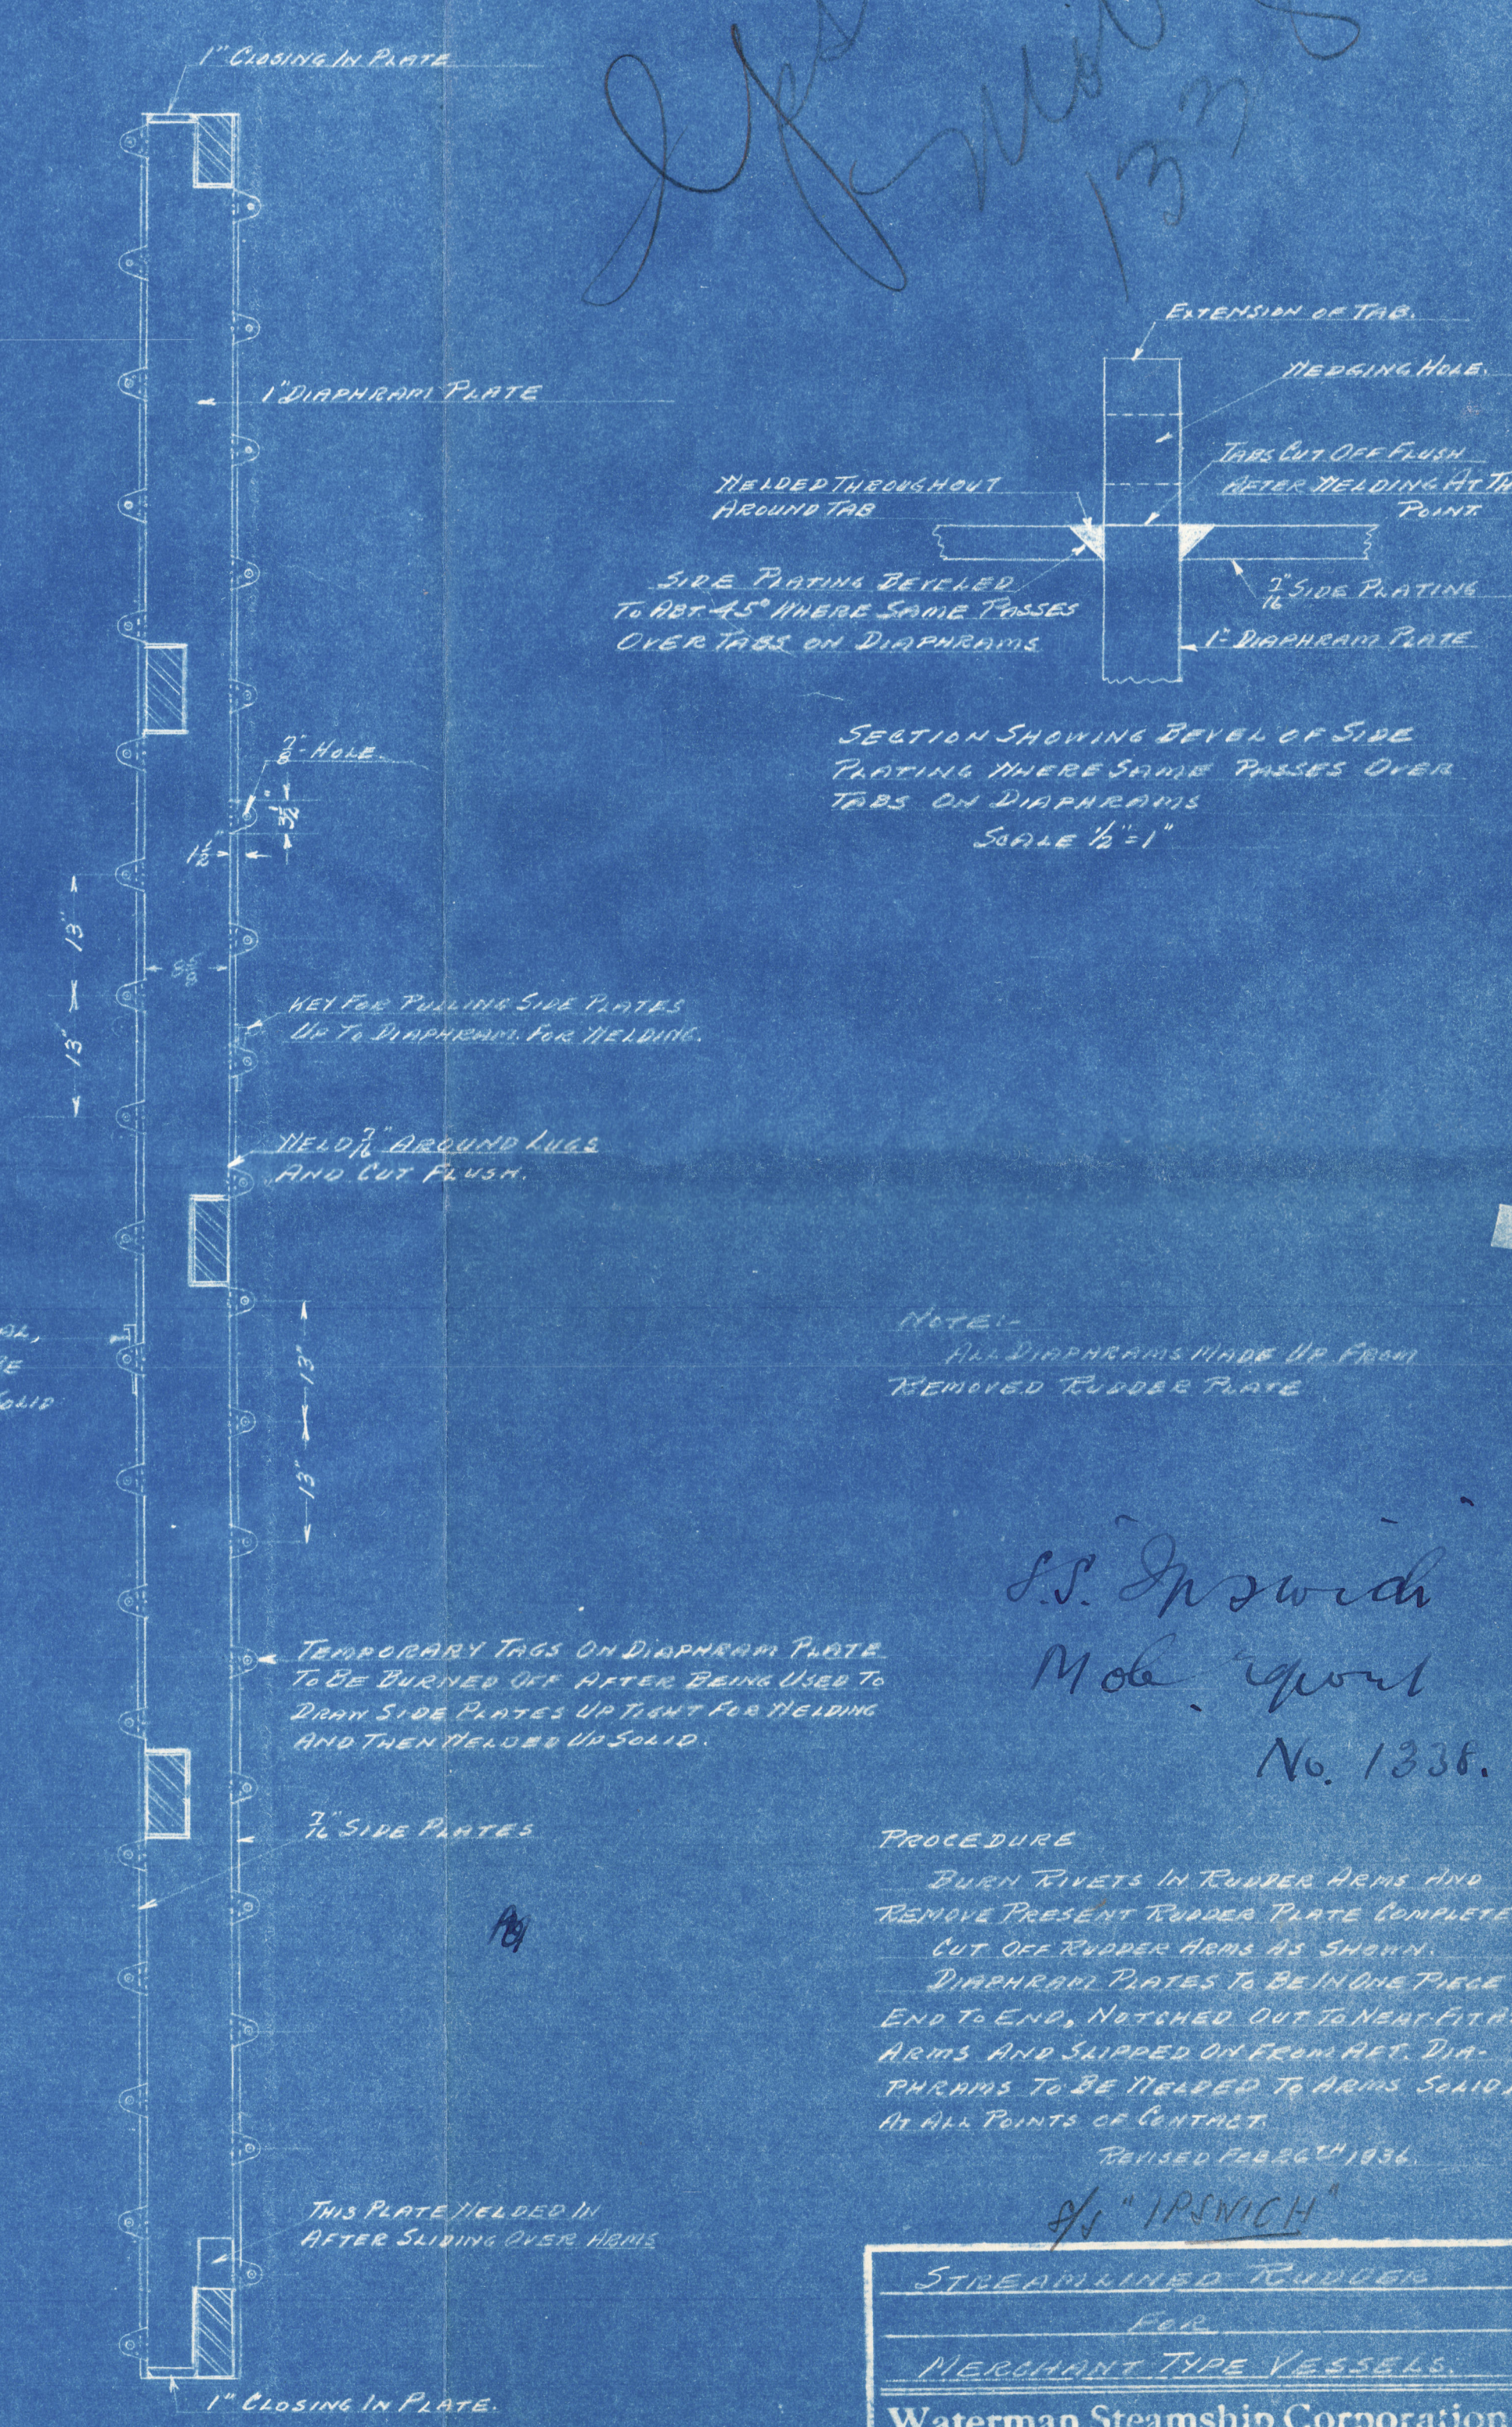

NOTE: ALL DIAPHRAGMS MADE UP FROM REMOVED RUBBER PLATE

*J. S. Irwin*  
Mobile, Ala.  
No. 1338.

PROCEDURE  
BURN RIVETS IN RUBBER ARMS AND REMOVE PRESENT RUBBER PLATE COMPLETE. CUT OFF RUBBER ARMS AS SHOWN. DIAPHRAGM PLATES TO BE IN ONE PIECE END TO END, NOTCHED OUT TO NEAR FIT AT ARMS AND SHIPPED ON FROM HET. DIAPHRAGMS TO BE WELDED TO ARMS SCALD BY AT ALL POINTS OF CONTACT.

REVISED PAGE 2/1338

*J. S. Irwin*

STREAMLINED RUBBER FOR MERCHANT TYPE VESSELS.	
Waterman Steamship Corporation	
MOBILE, ALA.	
ENGINEERING DEPT.	
Drawn by <i>C.E.H.</i>	Date <i>Jan. 22, 1936</i>
Approved by <i>C.E.H.</i>	Scale <i>3/8"=1'-0"</i>
Checked by <i>C.E.H.</i>	Drawing No. <i>116</i>
Traced by <i>C.E.H.</i>	Tracing No. <i>116</i>