


24.2.11
6.3.11
20.3.11
9.8.11

PLAN No. 697
FOR ENCLOSURE TO
Messrs Lloyd's Surveyors
Hull FROM
COCHRANE & SONS,
SHIPBUILDERS, SELBY.
DATE Sept 18th 11. RR



PROFILE & DECK PLAN

STEEL SCREW STEAMERS.
Nos. 499-500-1

PLAN No. 27
FOR ENCLOSURE TO
Messrs Lloyd's Surveyors
Hull FROM
COCHRANE & SONS,
SHIPBUILDERS, SELBY.
DATE 22/2/11. RR

DIM^S - LENGTH B.P. 105'-0" x 21'-0" E.A. x 12'-0" M.L.D.
SCALE 1/4" = 1 FOOT

at 1st mast
at 2nd mast
at 3rd mast

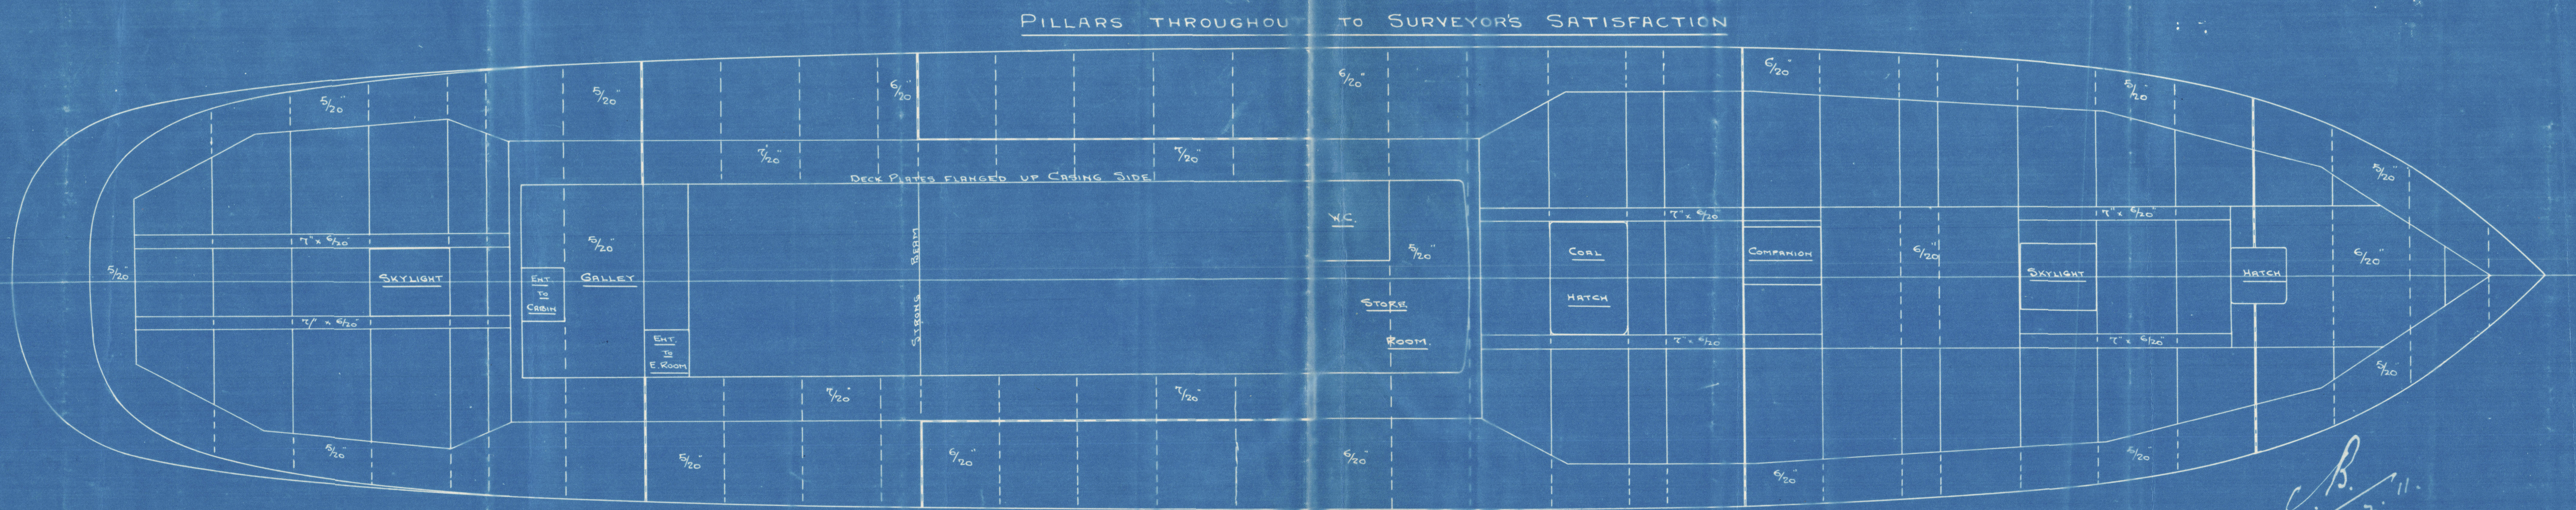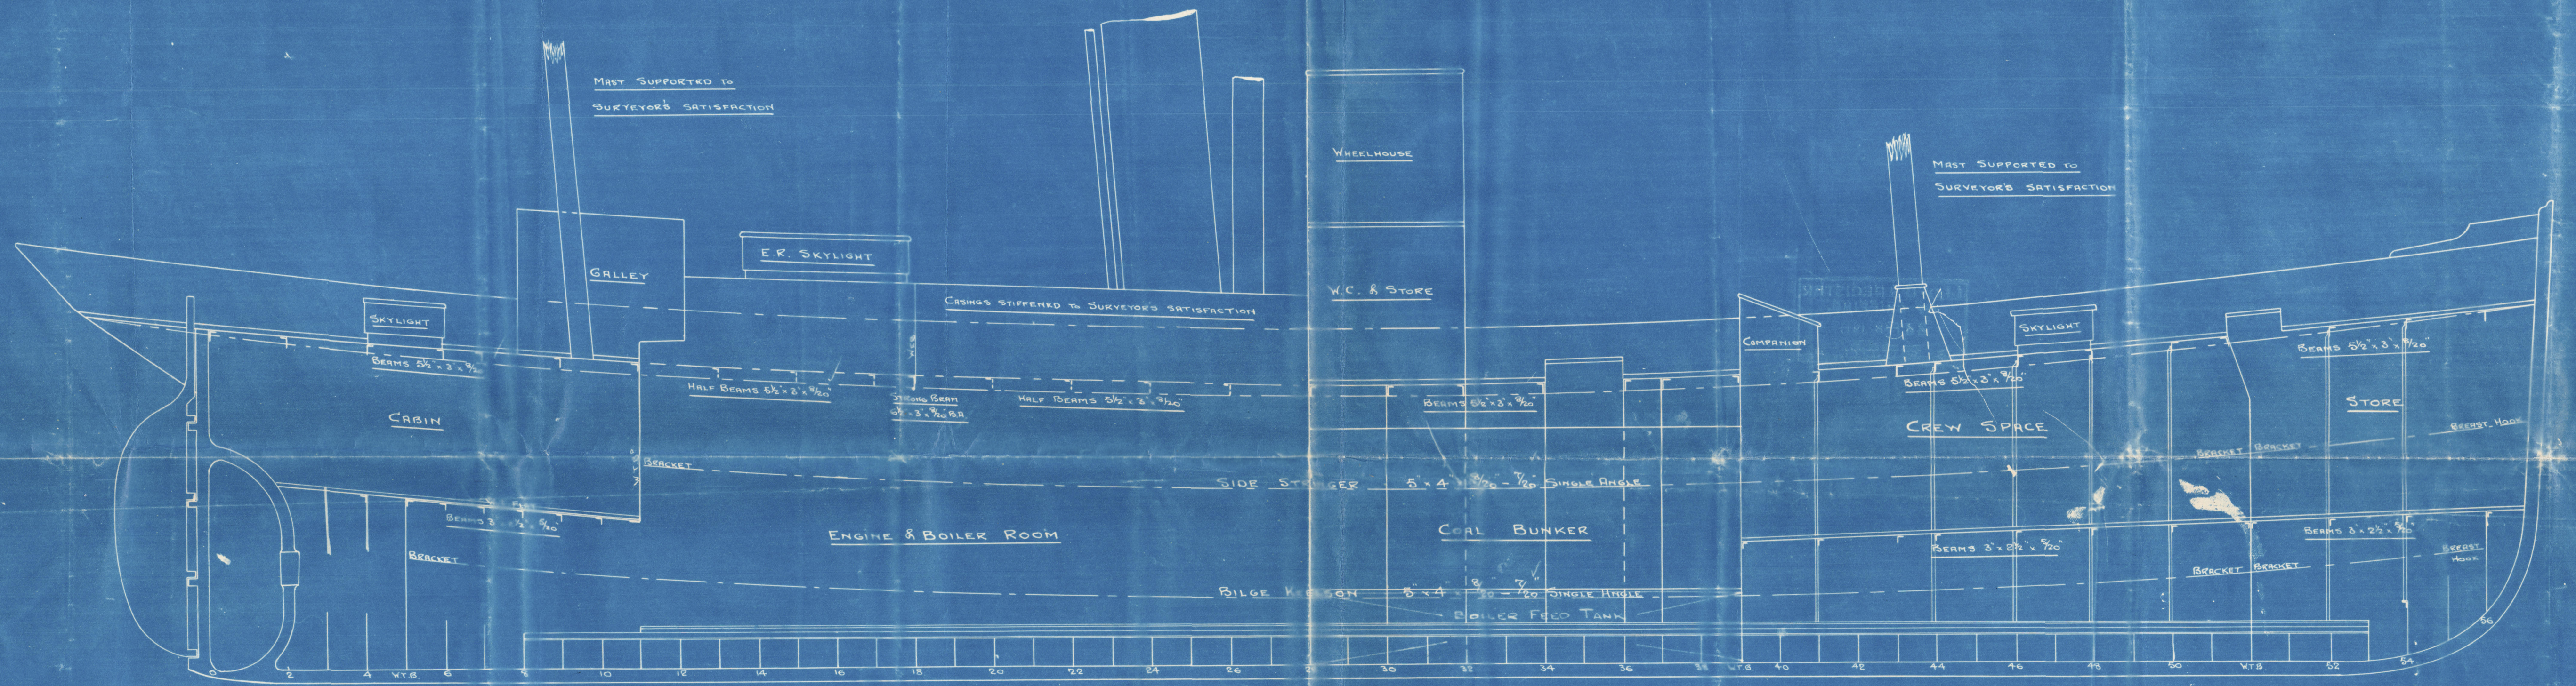

C.B.
24.2.11.

Cochrane & Sons.

No 499-500-501.

~~Duplicate.~~

~~Pumping Arrangements.~~

PROFILE & DECK

" " S.S. Jaci. Hull Rpt. No. 24221
" " " " " 24287
" " " " " 24395



© 2021

Lloyd's Register
Foundation

006412-006422-0264