

MIDSHIP SECTION

28

Messrs Lloyds Surveyors
Hull

PLAN No. 574
FOR ENCLOSURE TO
Messrs Lloyds Surveyors
Hull
FROM
COCHRANE & SONS,
SHIPBUILDERS, SELBY
DATE 4/8/11 RK

STEEL SCREW STEAMERS.

N^{os}. 499-500-1

22/2/11. RK


DIM^s - LENGTH B.P. 105'-0" x 21'-0" Ex. x 12'-0" M^{LD}.

SCALE 1/2" = 1 FOOT.

TO CLASS 100.A.I. LLOYD'S

DECK PLATED OVER IN WAY OF MACHINERY SPACE.

ENGINE & BOILER CASING AS PREVIOUSLY APPROVED.

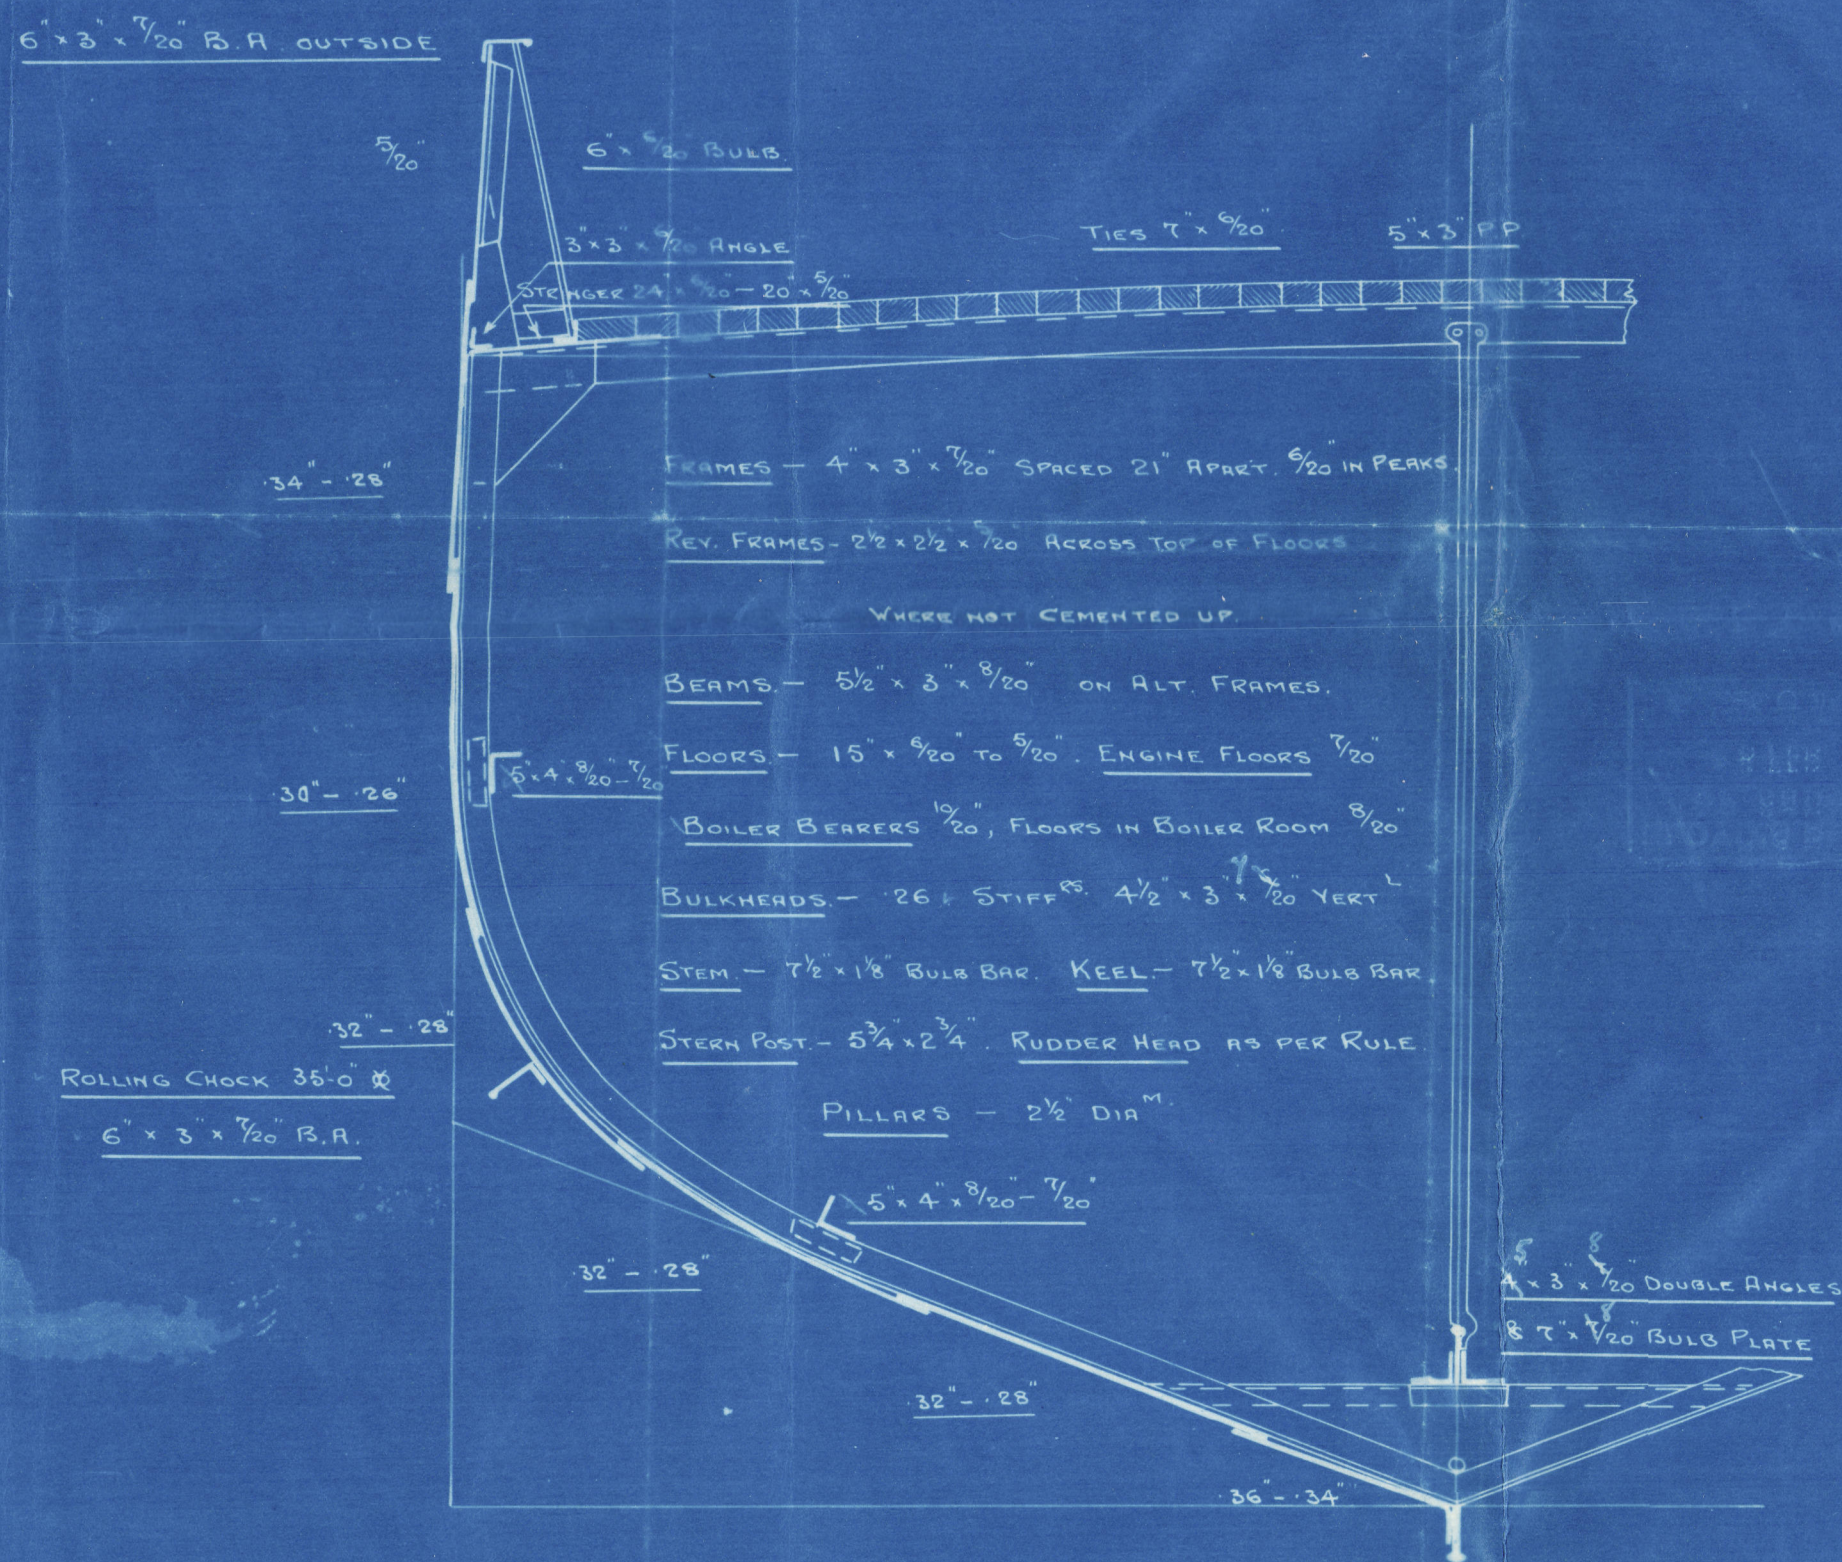

$$L \times (B + D) = 3451$$

EQUIPMENT

2 BOWER ANCHORS	4 1/4" CWTs. EX STOCK
1 STREAM	1 1/4" " " "
1 KEDGE	1 1/4" " " "
120 FATHOMS	12 1/16" STUD LINK CABLE.
45 "	9 1/16" CHAIN OR 2" STEEL WIRE.
75 "	6" HEMP OR 2 1/4" STEEL WIRE.
30 "	4" HAWSER.
30 "	4" WARP.

RIVETING

BUTTS OF SHELL PLATING LAPPED & DOUBLE RIVETED EXCEPT THOSE
OF GARBOARD & SHEERSTRAKE WHICH ARE TO BE STRAPPED. LANDING EDGES
DOUBLE RIVETED EXCEPT TOP EDGE OF SHEERSTRAKE, WHICH IS TO BE SINGLE
RIVETED. BUTTS OF STRINGER & TIE PLATES OVERLAPPED & DOUBLE RIVETED.

C.B.
24.2.11.

Messrs Lloyds Surveyors
Hull
200' 201.
Graham & Gano

Cochrane & Sons
No: 499 - 500, 501

Duplicate.

Midship Section.

SS. "Zaci"	Hull Rpt No:	24221
"Marakchi"	" "	24287
"Meknassi"	" "	24395



© 2021

Lloyd's Register
Foundation

006412-006422-0265