

9700^{TON} TYPE.

TILLER

MATERIAL
FORGED STEEL


To be made in
1/2 BORDEAUX MARU
in June 1928

in June 1928

per ^{me} motai

Kedara, K...

AWASAKI KISEN KAISHA

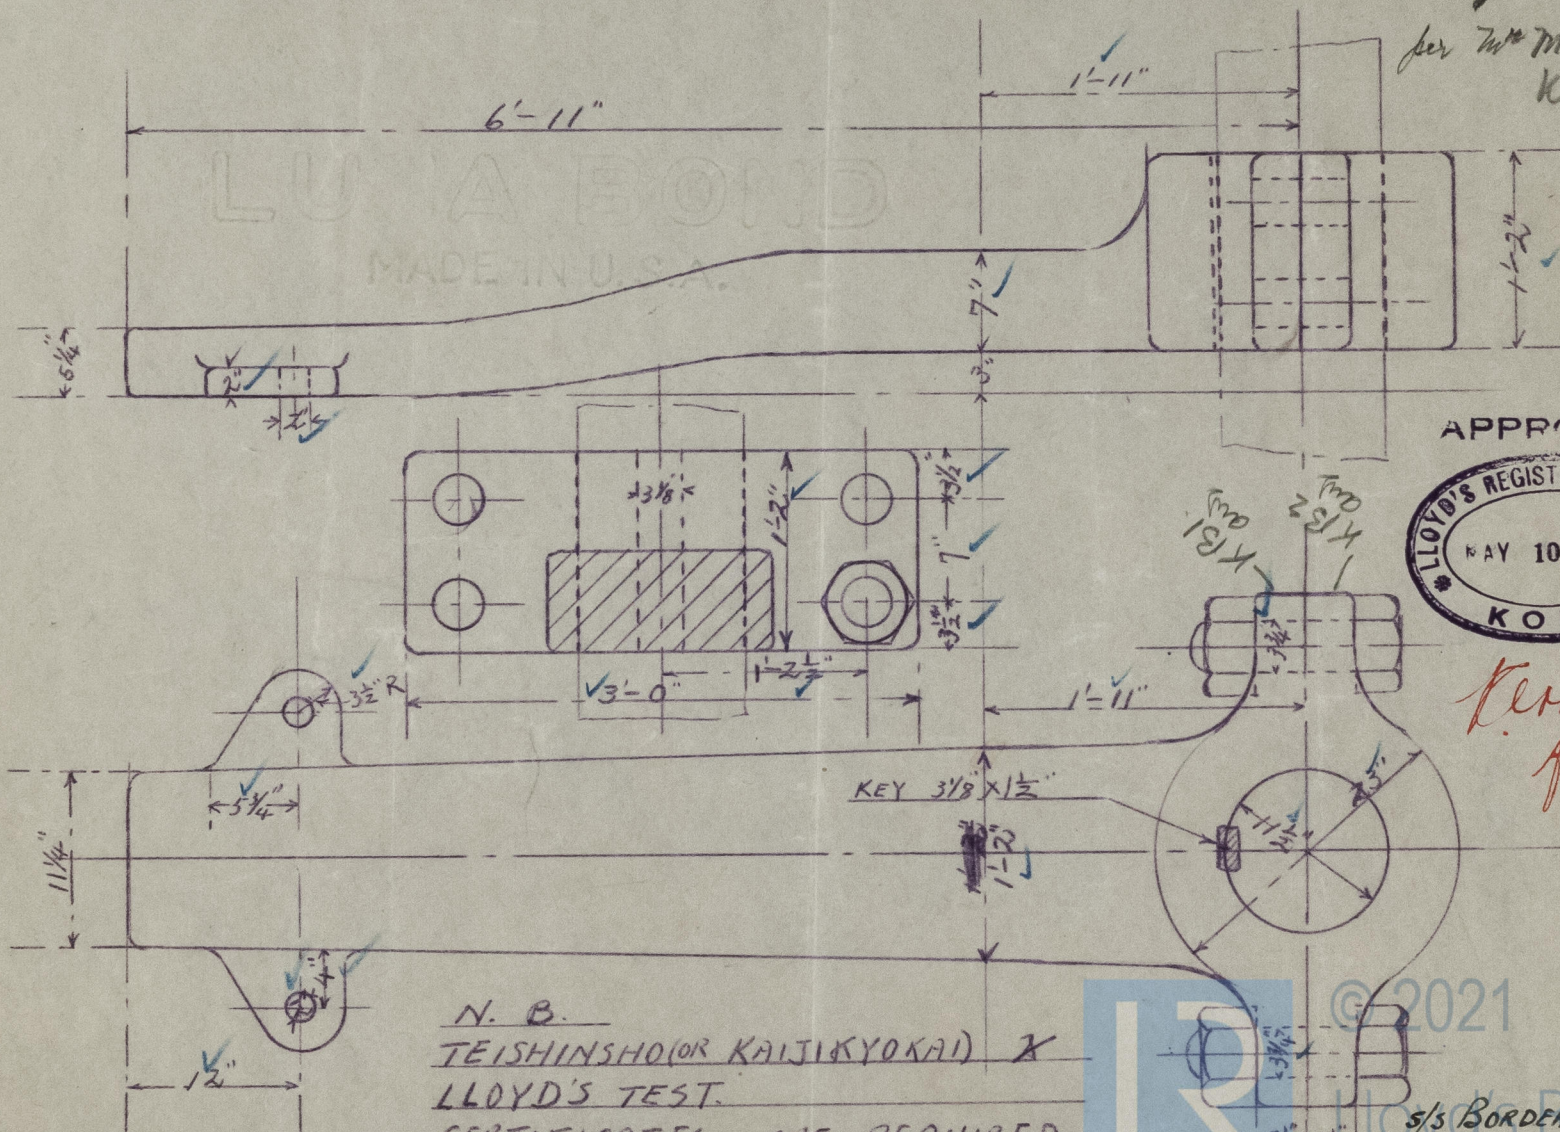

APPROVED



Kearnsford.
for H. G. Co.

N. B.
TEISHINSHO (OR KAIJIKYOKAI) &
LLOYD'S TEST.
CERTIFICATES ARE REQUIRED

© 2021

S/S BORDEAUX - MARU
Kobe Rpt no 6148
15/6/28 *and*