





S.S " BORDEAUX MARU "

REPAIR PLAN
OF STERN FRAME

12/6/1928.

PORT. — 
STARBOARD — 

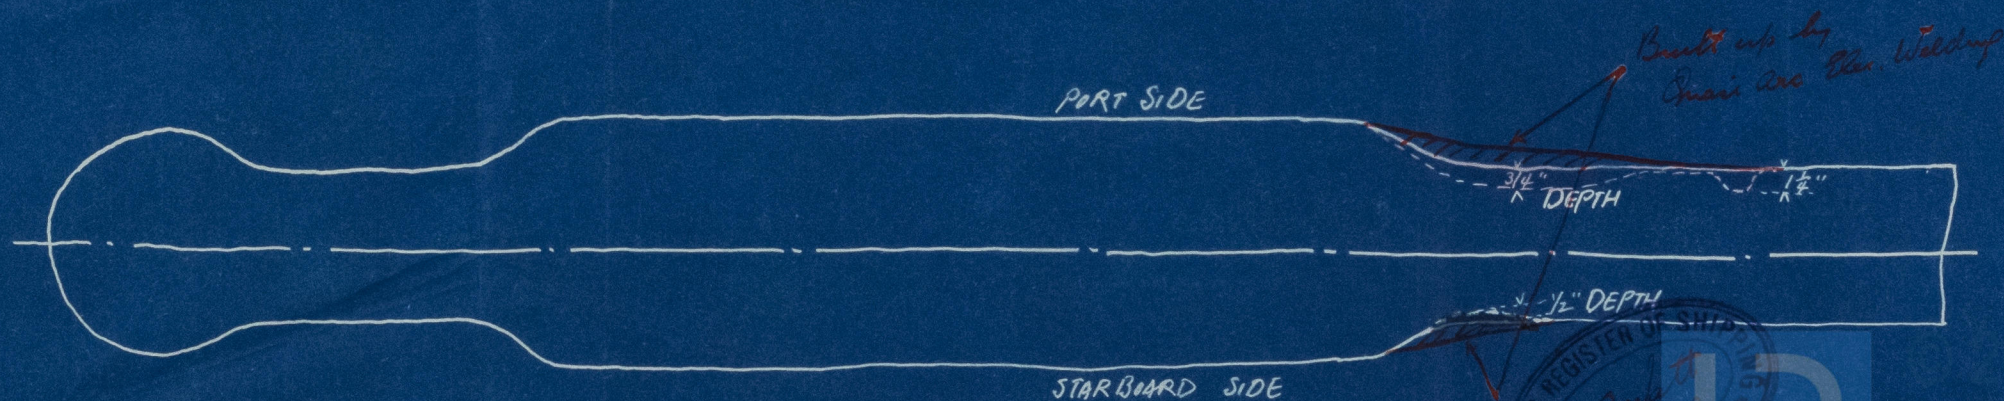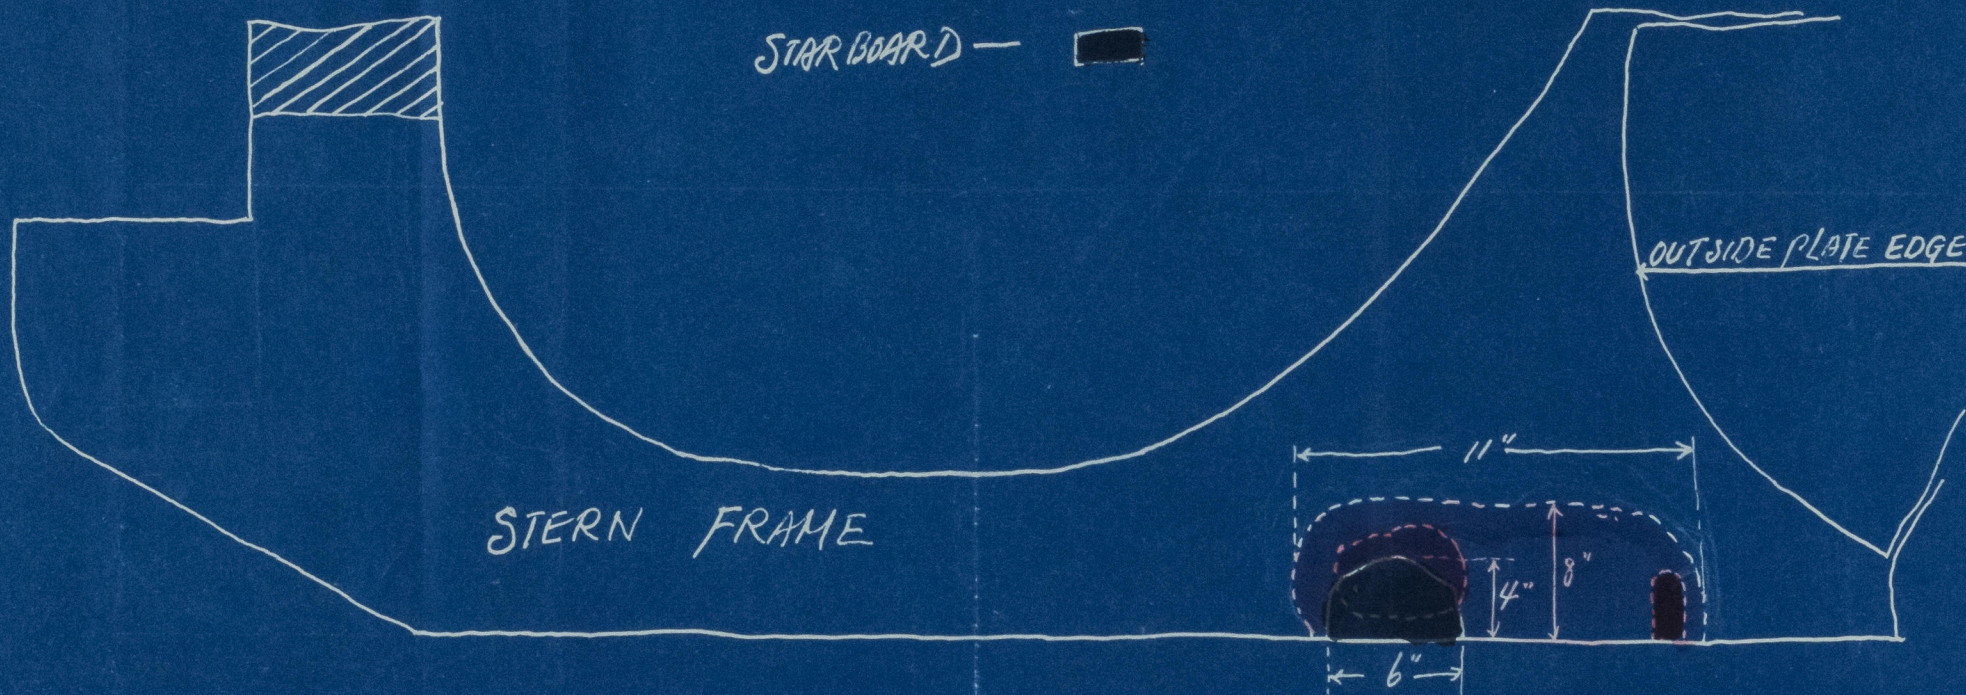

006479-006488-0022