




17.9.12

16817 + 18.
N^o 15 - HOPPER BARGES.

RUDDER AND STERNPOST.
SCALE 1" = 1'.

Naamloze Vennootschap
Scheepswerf "DORDRECHT"
DORDRECHT, Holland.

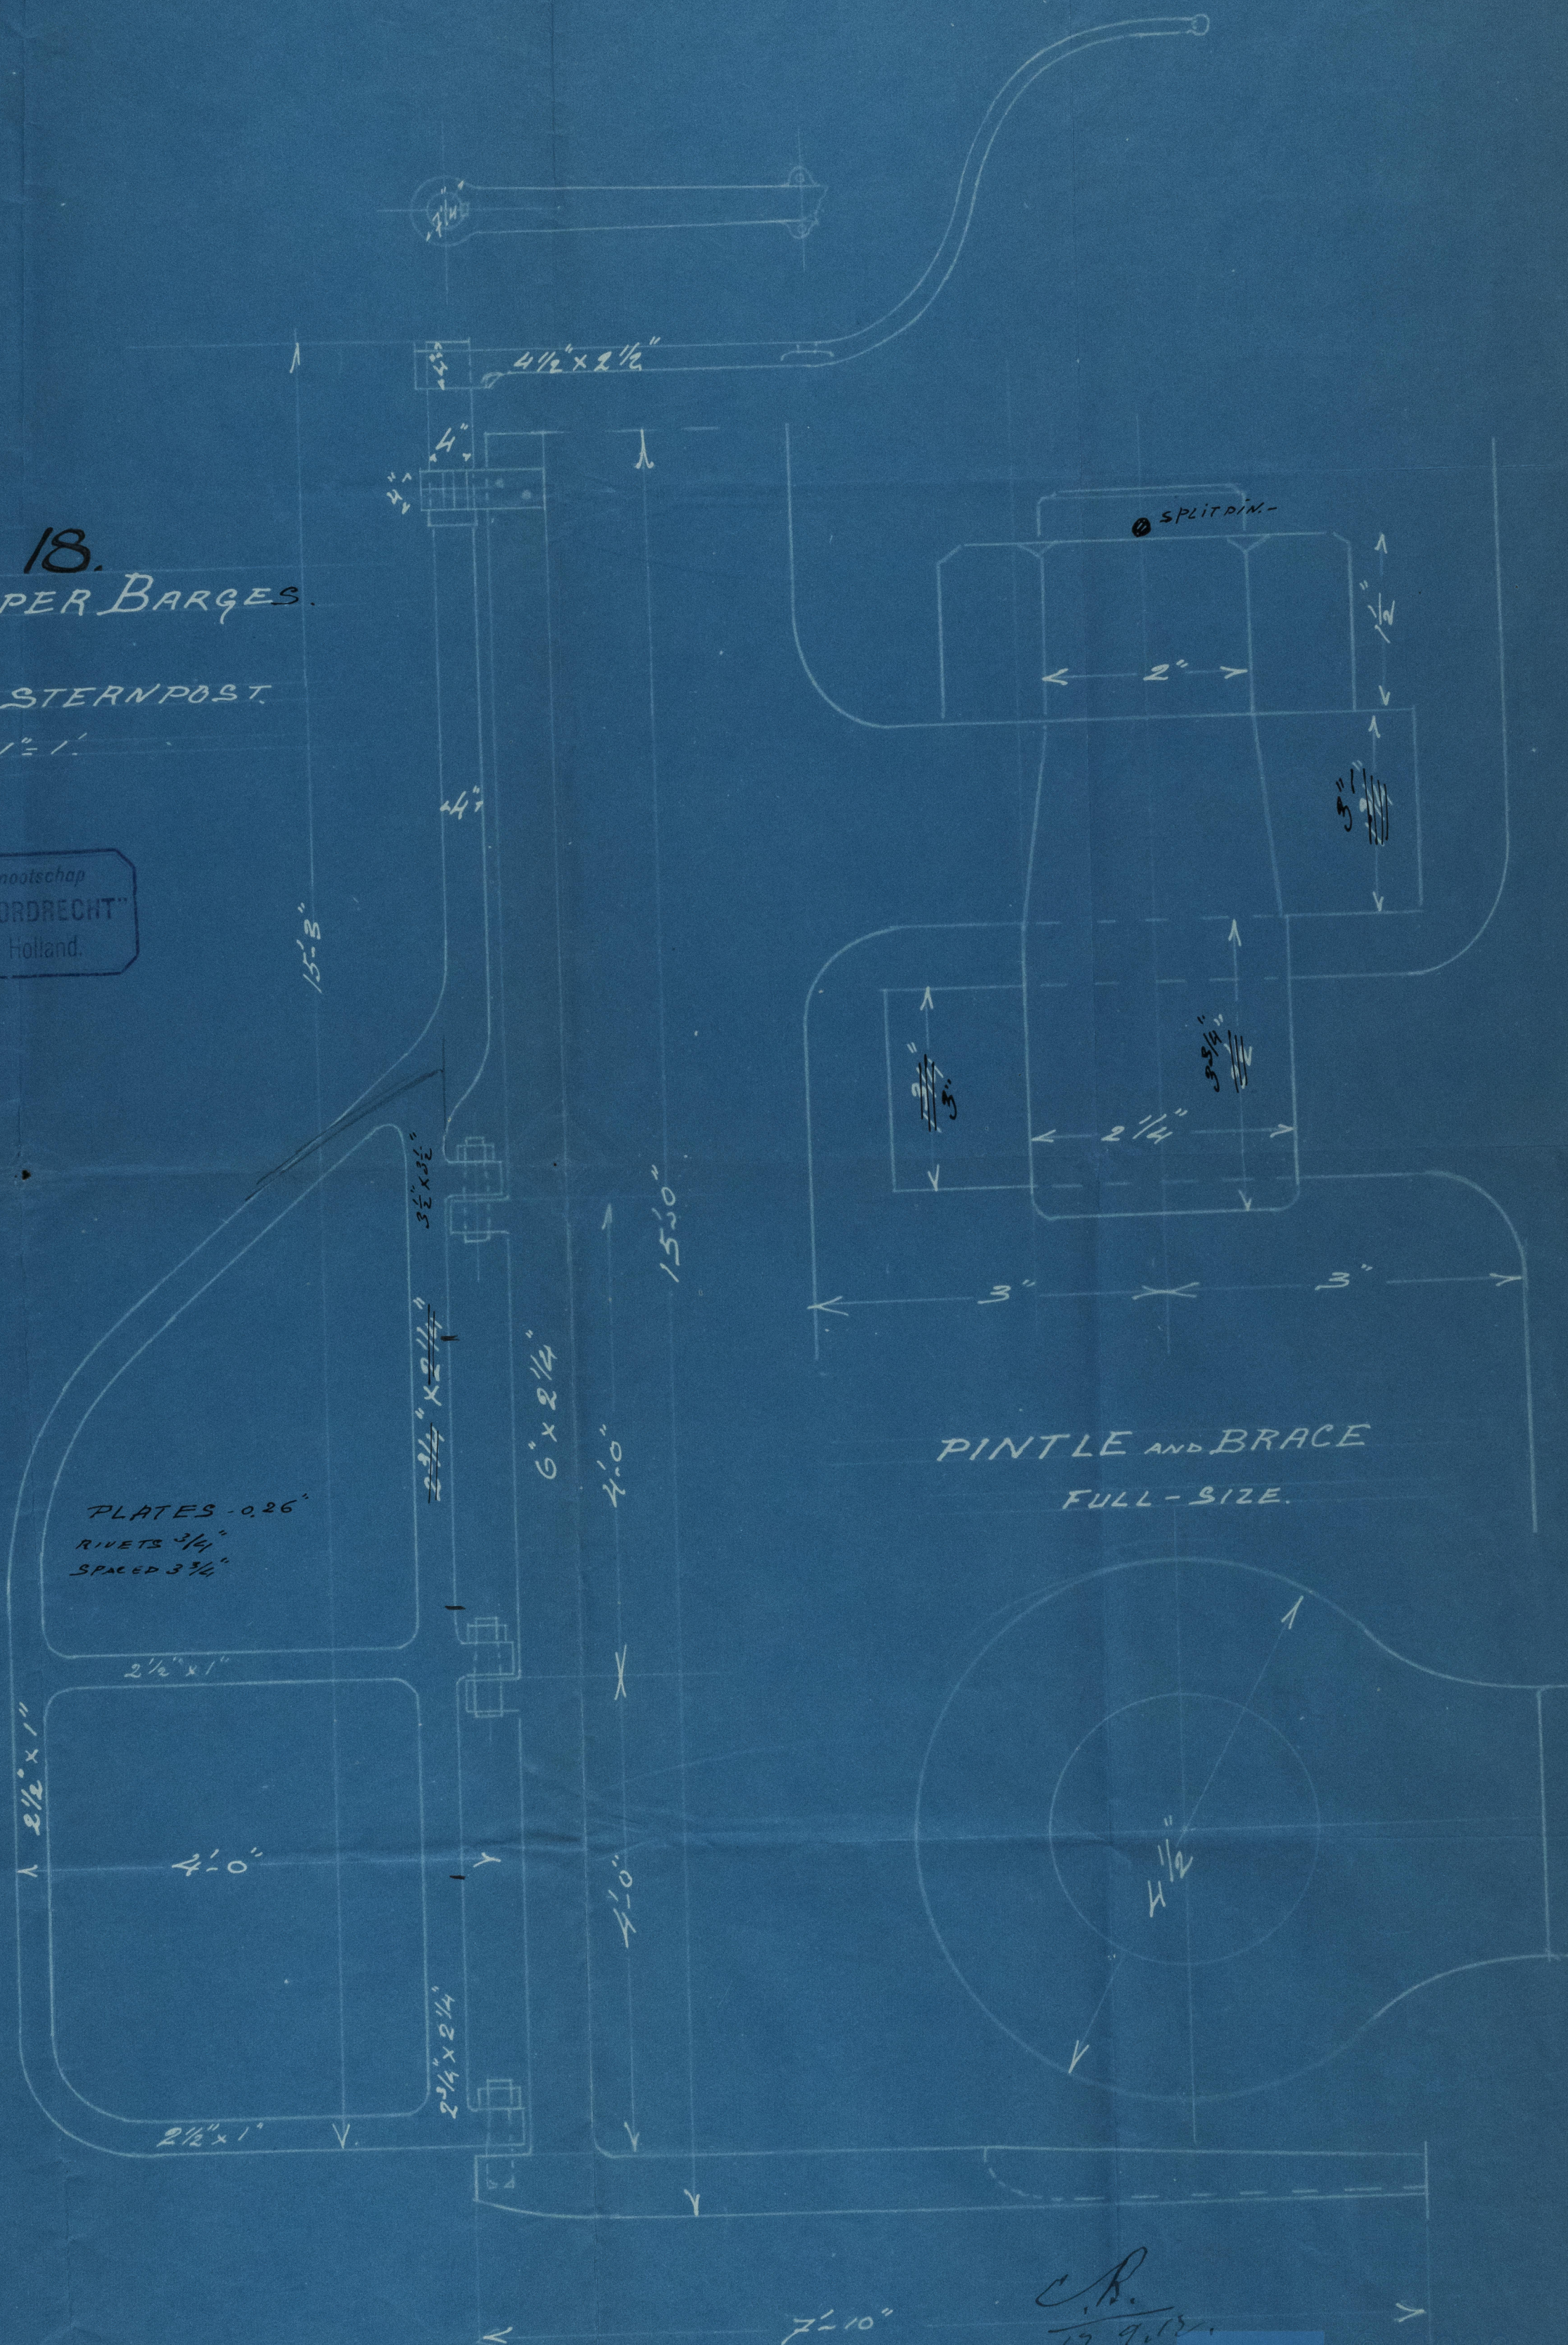

PINTLE AND BRACE
FULL-SIZE.

C.R.
17.9.12.



Lloyd's Register
Foundation
006489-00504-0048



"S.P.I." ^{London} ^{Rockland} / ^{L.B.H.} ^{now names} ^{"Sandbank"}
No. 16. Rotterdam report. No. 8554

Rudder & Stern frame
for barges No's 16 & 17. 4/8



Yard Dordrecht.

No. 14. Rotterdam report 8643. ^{"Sandbank"}
N 10 5 0000. Claysand.

006489-006504-0048

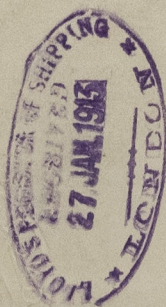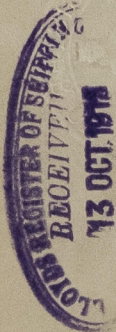

DISCLOSED
SECTION
100

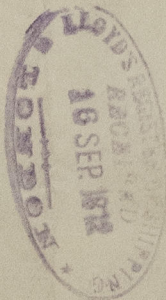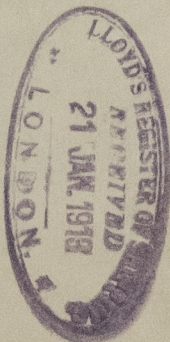

© 2020

Lloyd's Register
Foundation