


DIMENSIONS	
LENGTH OVERALL	ABOUT 439'-10"
LENGTH (LLOYDS)	424'-8 1/2"
BEAM (MLD)	55'-0"
DEPTH (MLD) TO SHELTER DECK	36'-0"
DEPTH (MLD) TO 8'-0" BELOW SHELTER DK	28'-0"

LLOYD'S NUMERALS	
1ST NUMERAL	55 + 28 = 83
2ND NUMERAL	83 x 424.7 = 35250
DEPTH (d) =	15'-10"
PROPORTIONS TO SHELTER DECK	11.8

EQUIPMENT NUMBER	
PLATING NUMBER	35250
DECK HOUSES	416437
SHELTER DECK	2550
EQUIPMENT NUMBER	38216 38237

EQUIPMENT	
2 BOWER ANCHORS	7616" EACH
1 BOWER ANCHOR	6550"
1 STREAM ANCHOR	2660"
1 KEDGE	1120"
270 FATHOMS 2 1/2" STUD LINK CHAIN	CABLE
90 FATHOMS 7" STEEL WIRE	STREAM
120 FATHOMS 5 1/2" STEEL WIRE	TOYLINE
2 HAYSERS	7" MANILA 90 FATHOMS EACH
2 HAYSERS	8" MANILA 90 FATHOMS EACH

NOTE
SEE SEPARATE PLANS FOR PILLARS AND GIRDERS, AND BULKHEADS. } See submitted

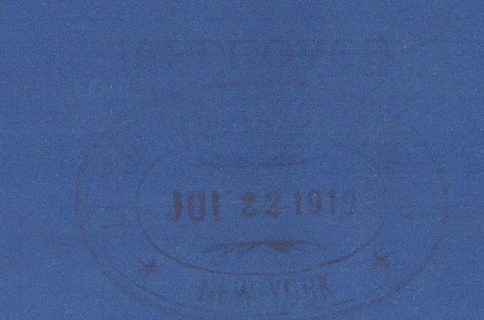

J. French
J.S. ROBIN GOODFELLOW
YARD No 76

TO CLASS 4100A1 SHELTER DECK RULE
with freeboard
7/8 73 74 75 76

SKINNER & EDDY CORPORATION
SEATTLE WASH.
REVISED
MIDSHIP SECTION
LLOYDS

PROPOSED SHELTER DECK CARGO STEAMER
424'-8 1/2" x 55'-0" x 36'-0" MLD. TO SHELTER D.K.

SCALE 1/2" = 1 FT. JULY 9-1919

SHEER FWD 10'-9"
" AFT 5'-3"

15/16
1919