



PLAN OF FORGED RUDDER

T.S.M.V. No 762

SCALE 1" = 1 FOOT

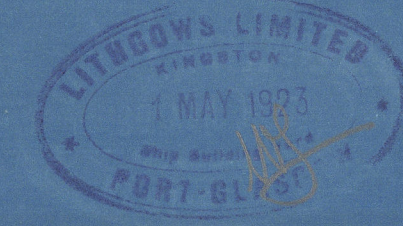

DIMENSIONS - 44'-0" S.P. - 57'-0" MLD - 57'-3" EXT - 38'-0" MLD TO UPPER DECK
 TO CLASS 100 A.I. WITH FREEBOARD AT LLOYD'S SPECIAL SURVEY
 AREA OF RUDDER FROM PURE SIDE OF POST 145.81 SQ. FT. NUMERICAL - 145.81 - 3.71 - 840.08
 CENTRE OF GRAVITY FROM CENTRE LINE OF PINTLE 3.71 FEET
 SPEED UNDER 12 KNOTS
 RUD. ON PINTLE 5" ACROSS PLATE AND 5" DEEP
 ANY EXCESS ON THE GUN SCANTLING WILL NOT BE PAID FOR
 SIZE OF RIVET HOLES MUST NOT BE LESS THAN GIVEN
 GUEZ CANAL RUDDER TO BE SUPPLIED

 

DETAIL SKETCH OF GUDGEON AND PINTLE
 SCALE HALF-SIZE

APPROVED
 LLOYD'S REGISTER
 7.5.70

SKETCH OF RUDDER.

LITHGOW'S LTD TSMV No 762.

"ATAGO MARU"

GRK. RPT. No. 18320.



© 2020

Lloyd's Register
Foundation

006505-006511-0071