

Twin Screw Ferry Steamer N° 691.


Arrangement of Deck over Boiler Space.

Scale $\frac{1}{4}'' = 1 \text{ Foot.}$

28.11.24

Beams $8\frac{1}{2} \times 3\frac{1}{2} \times 45 \text{ B.A.}$

Half Beams & Beams $5\frac{1}{2} \times 3 \times 36 \text{ B.A.}$

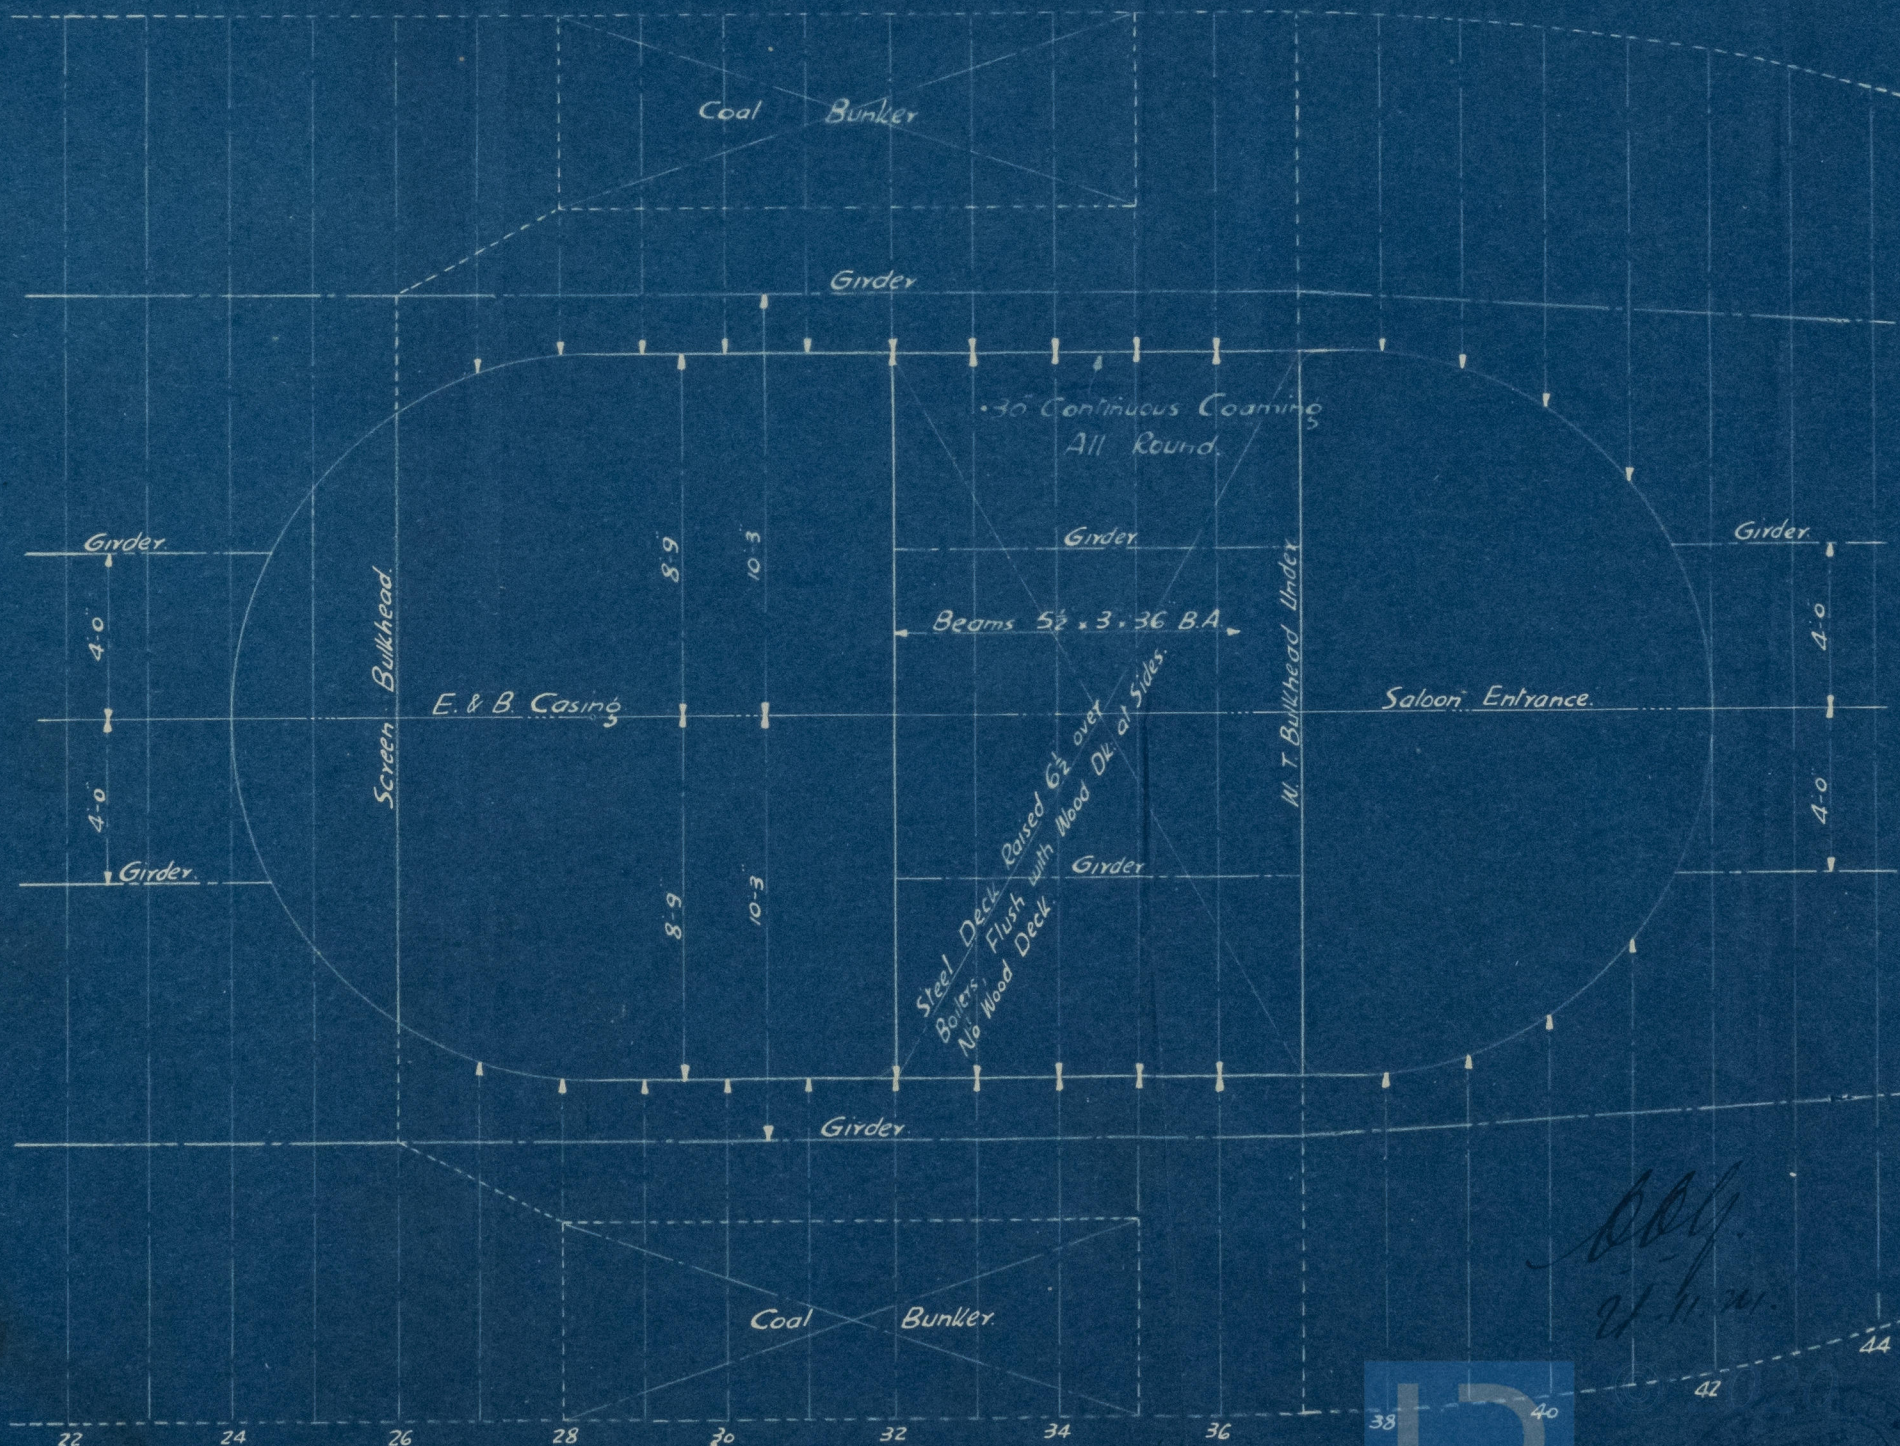


006523-006535-0003

17.11.24

RECEIVED
JAN 11 1900
LLOYD'S REGISTER

Girdle Under beam

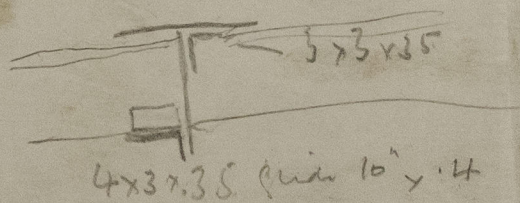

© 2020

Lloyd's Register
Foundation

6523-006535-0003