


DIMENSIONS 512.0 x 58.0 x 38.2 MOULDED

SCALE  $\frac{1}{8}$  = ONE FOOT.

NOTE: ALL SLIDING W.T. DOORS GEARED FROM BULKHEAD OF UPPER L  
WITH INDICATING DECK PLATES

ALL LIGHTS BELOW MAIN DECK TO HAVE HEXAGONAL NUT FASTENINGS  
 & TO BE FITTED WITH WT COVERS, ABOVE MAIN & UNDECK DECKS 25%  
 OF AUGS ~~SUPPLY~~ PLACED ONLY TO BE PROVIDED, AS REQ S.S. ORDN<sup>ANCE</sup> (B of P Letter 22)  
 FOR SCANTLING OF BULKHEADS SEE TYPICAL SKETCH OF BULKHEADS

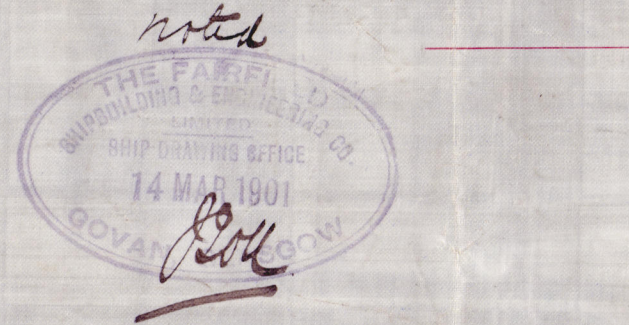

2.3.01  
9.3.01  
2.4.01  
16.6.01  
24.8.01  
3.9.01

frames, eleven frames cut at barrel  
top -

139 to 189 DOUBLE CHANNEL BEAMS  $8 \times 5 \frac{1}{2} \times 5 \frac{1}{2} \times 9 \frac{1}{2}$   
 FROM 189 to 190 CHANNEL BEAMS  $4 \times 5 \frac{1}{2} \times 5 \frac{1}{2} \times 9 \frac{1}{2}$  MAY BE FITTED ON EVERY FRAMES AT LOWER & ORLOF DECK (AT OWNERS OPTION)  
 KNEES SAME DEPTH AS SHOWN ON MIDSHIP SECTION

9/3/07




Profile

The Fairfield  
spot 6: N. 418

4/5 "Arontos"

Sketch no 00017.

 

© 2020

Lloyd's Register  
Foundation