


2.9.13.2.2000  
871.00

ELEVATION


PROPOSED 60 TON FLOATING CRANE BARGE

DIMENSIONS: 160'0" B.P. x 50'0" x 14'0" TO CLASS. A.I. FOR HARBOUR SERVICE


SCALE 1/8" = 1 FOOT

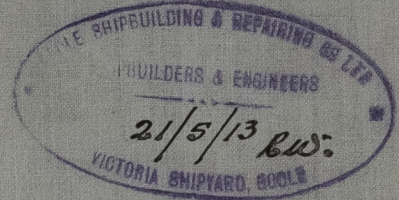

23.5.13.  
29.8.13  
6.10.13.

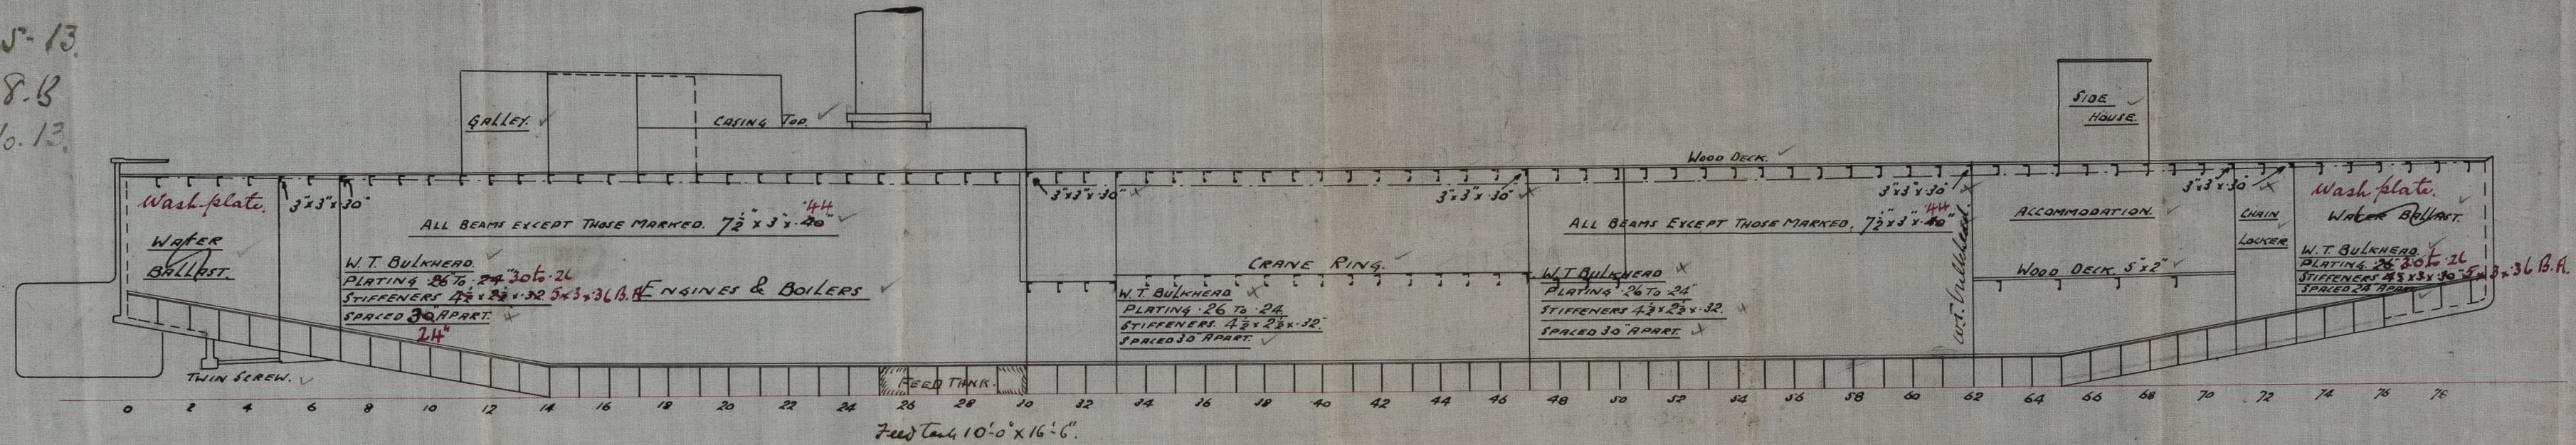

Pillaring throughout to Surveyors satisfaction.

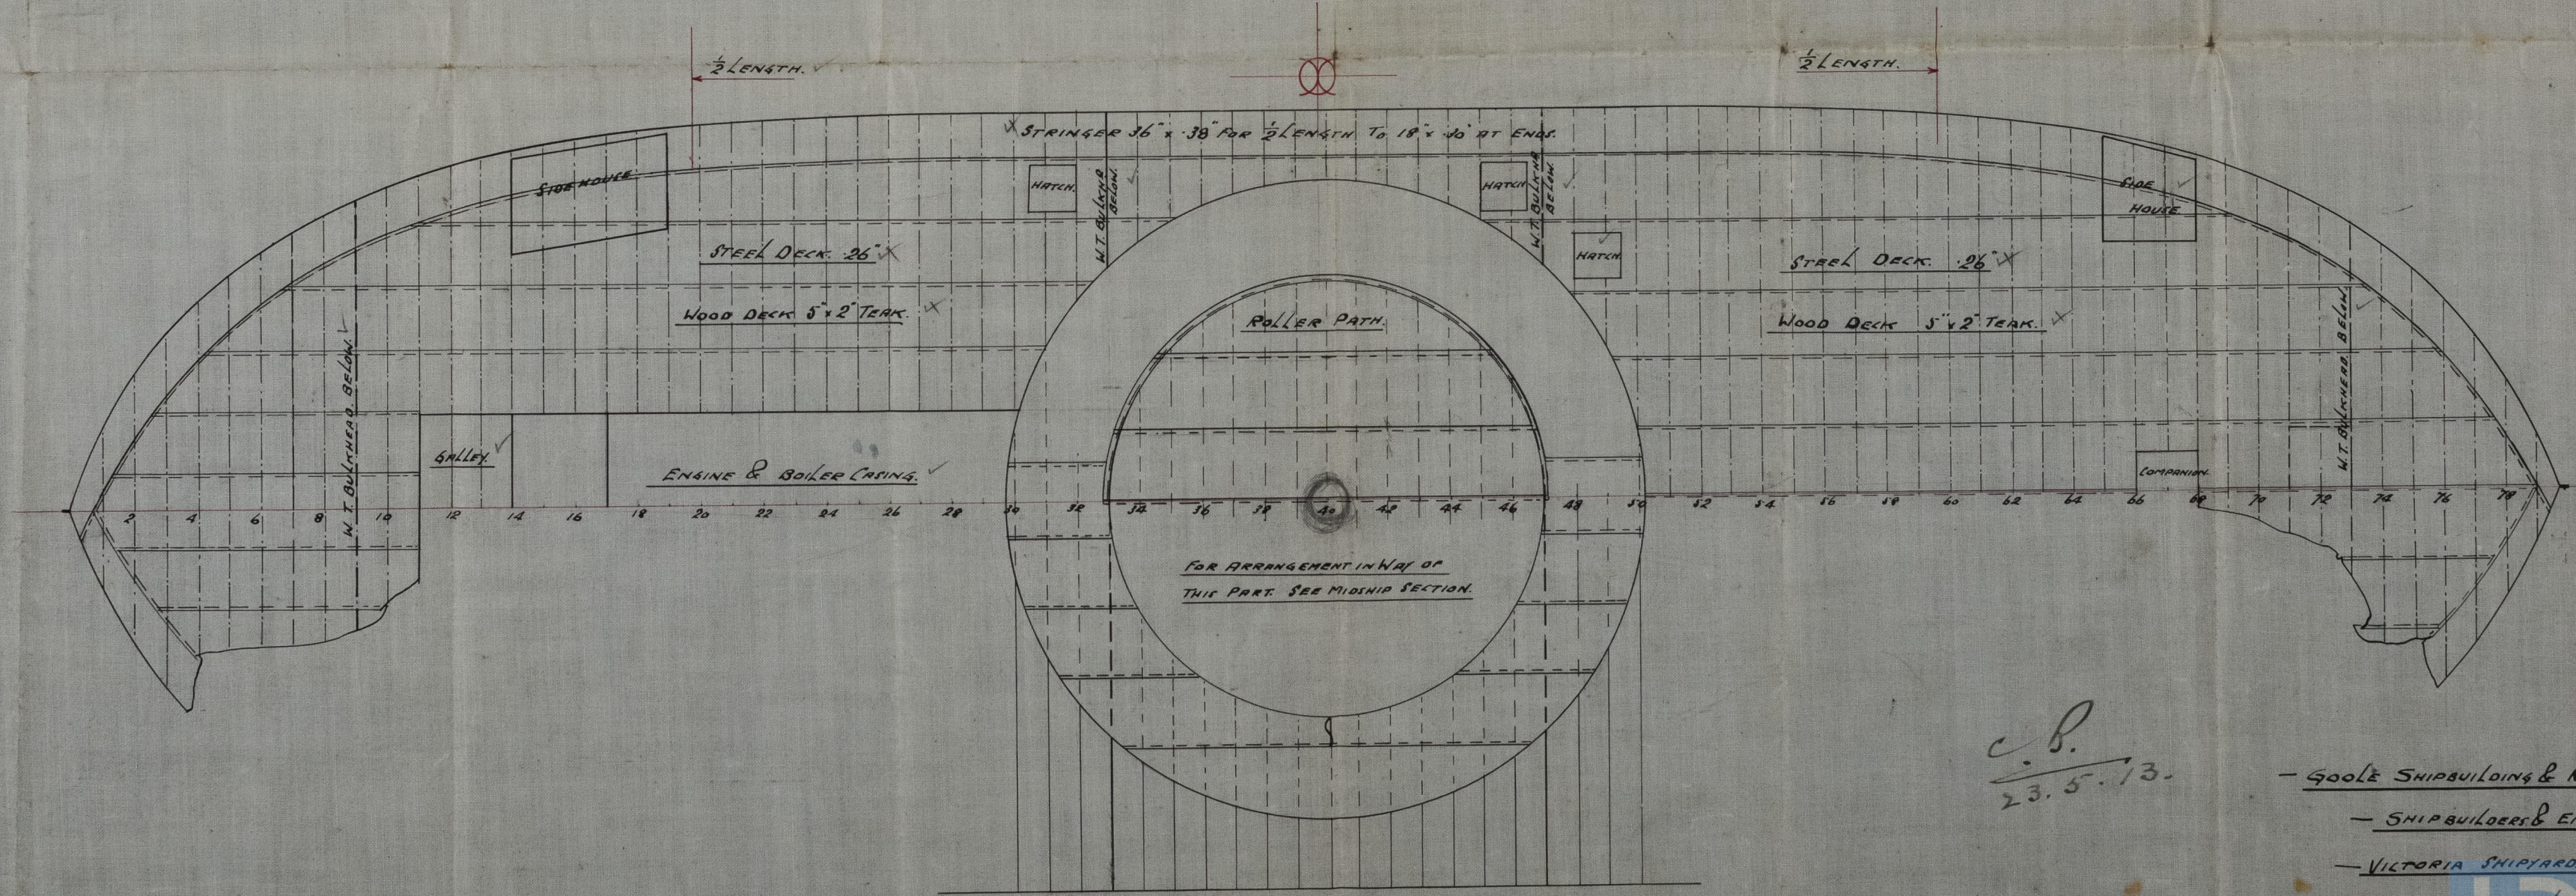


- No 158 -

G.B.  
23.5.13.

- GOOLE SHIPBUILDING & REPAIRING CO. LD. -  
- SHIPBUILDERS & ENGINEERS -  
- VICTORIA SHIPYARD GOOLE -

21/5/13 R.W.

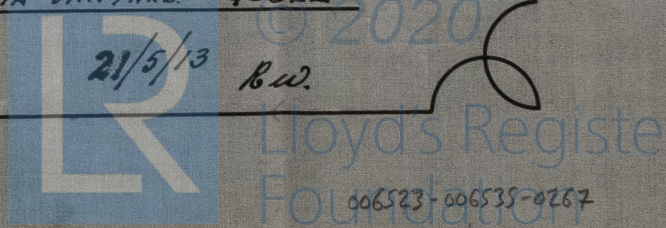



Goole S. B. & R. Co.

No. 158

Hull Rph. No. 24554

Profile of Deck

Crane Barge "Sandow."

M/M

6534

"SARUS"

© 2020

Lloyd's Register  
Foundation

006523-006535-0267