


B = 53'-0" D = 29'-4" L = 380'-8"

LLOYD'S NUMERALS 52-33
 TRANSVERSE NO. (B+D)
 LONGITUDINAL NO. L (B+D) 31305-98
 $\frac{1}{2}B = 10-05 \frac{1}{2}D = 12-95 D = 18-0"$
 STEM 10" x 23"
 STERN FRAME: PROPELLER POST 11" x 7 1/2"
 RUDDER POST 11" x 7 1/2"
 POOP SIDE PLATING .38
 FORECASTLE SIDE PLATING .40
 POOP AND FORECASTLE BEAMS 7" x 3.31" x .313 B
 TO EVERY FRAME 20" x .40 BRACKETS ON POOP BEAMS
 FORECASTLE BEAM BRACKETS 22" x .42
 STRINGER ANGLES 3 1/2" x 3 1/2" x .315 STRINGER PLATE 34" x .34
 DECK PLATING .30
 RIVETING .45 PER LLOYD'S RULES

EQUIPMENT
 EQUIPMENT NUMERAL 32642
 1. BOWER ANCHOR - STOCKLESS 5656 LBS.
 2. BOWER 5770
 1. STREAM 5620
 1. MIDGE 5730
 BOWER CHAINS, STOCKLESS, 290 FRMS 2 7/16"
 STREAM CHAINS 30 1 1/2"
 TOW LINES, STEEL WIRE 180 2 1/2"
 HAWKERS AND WARDENERS 30 IN EACH
 2 - 8 INCHES, C. TUNCHED

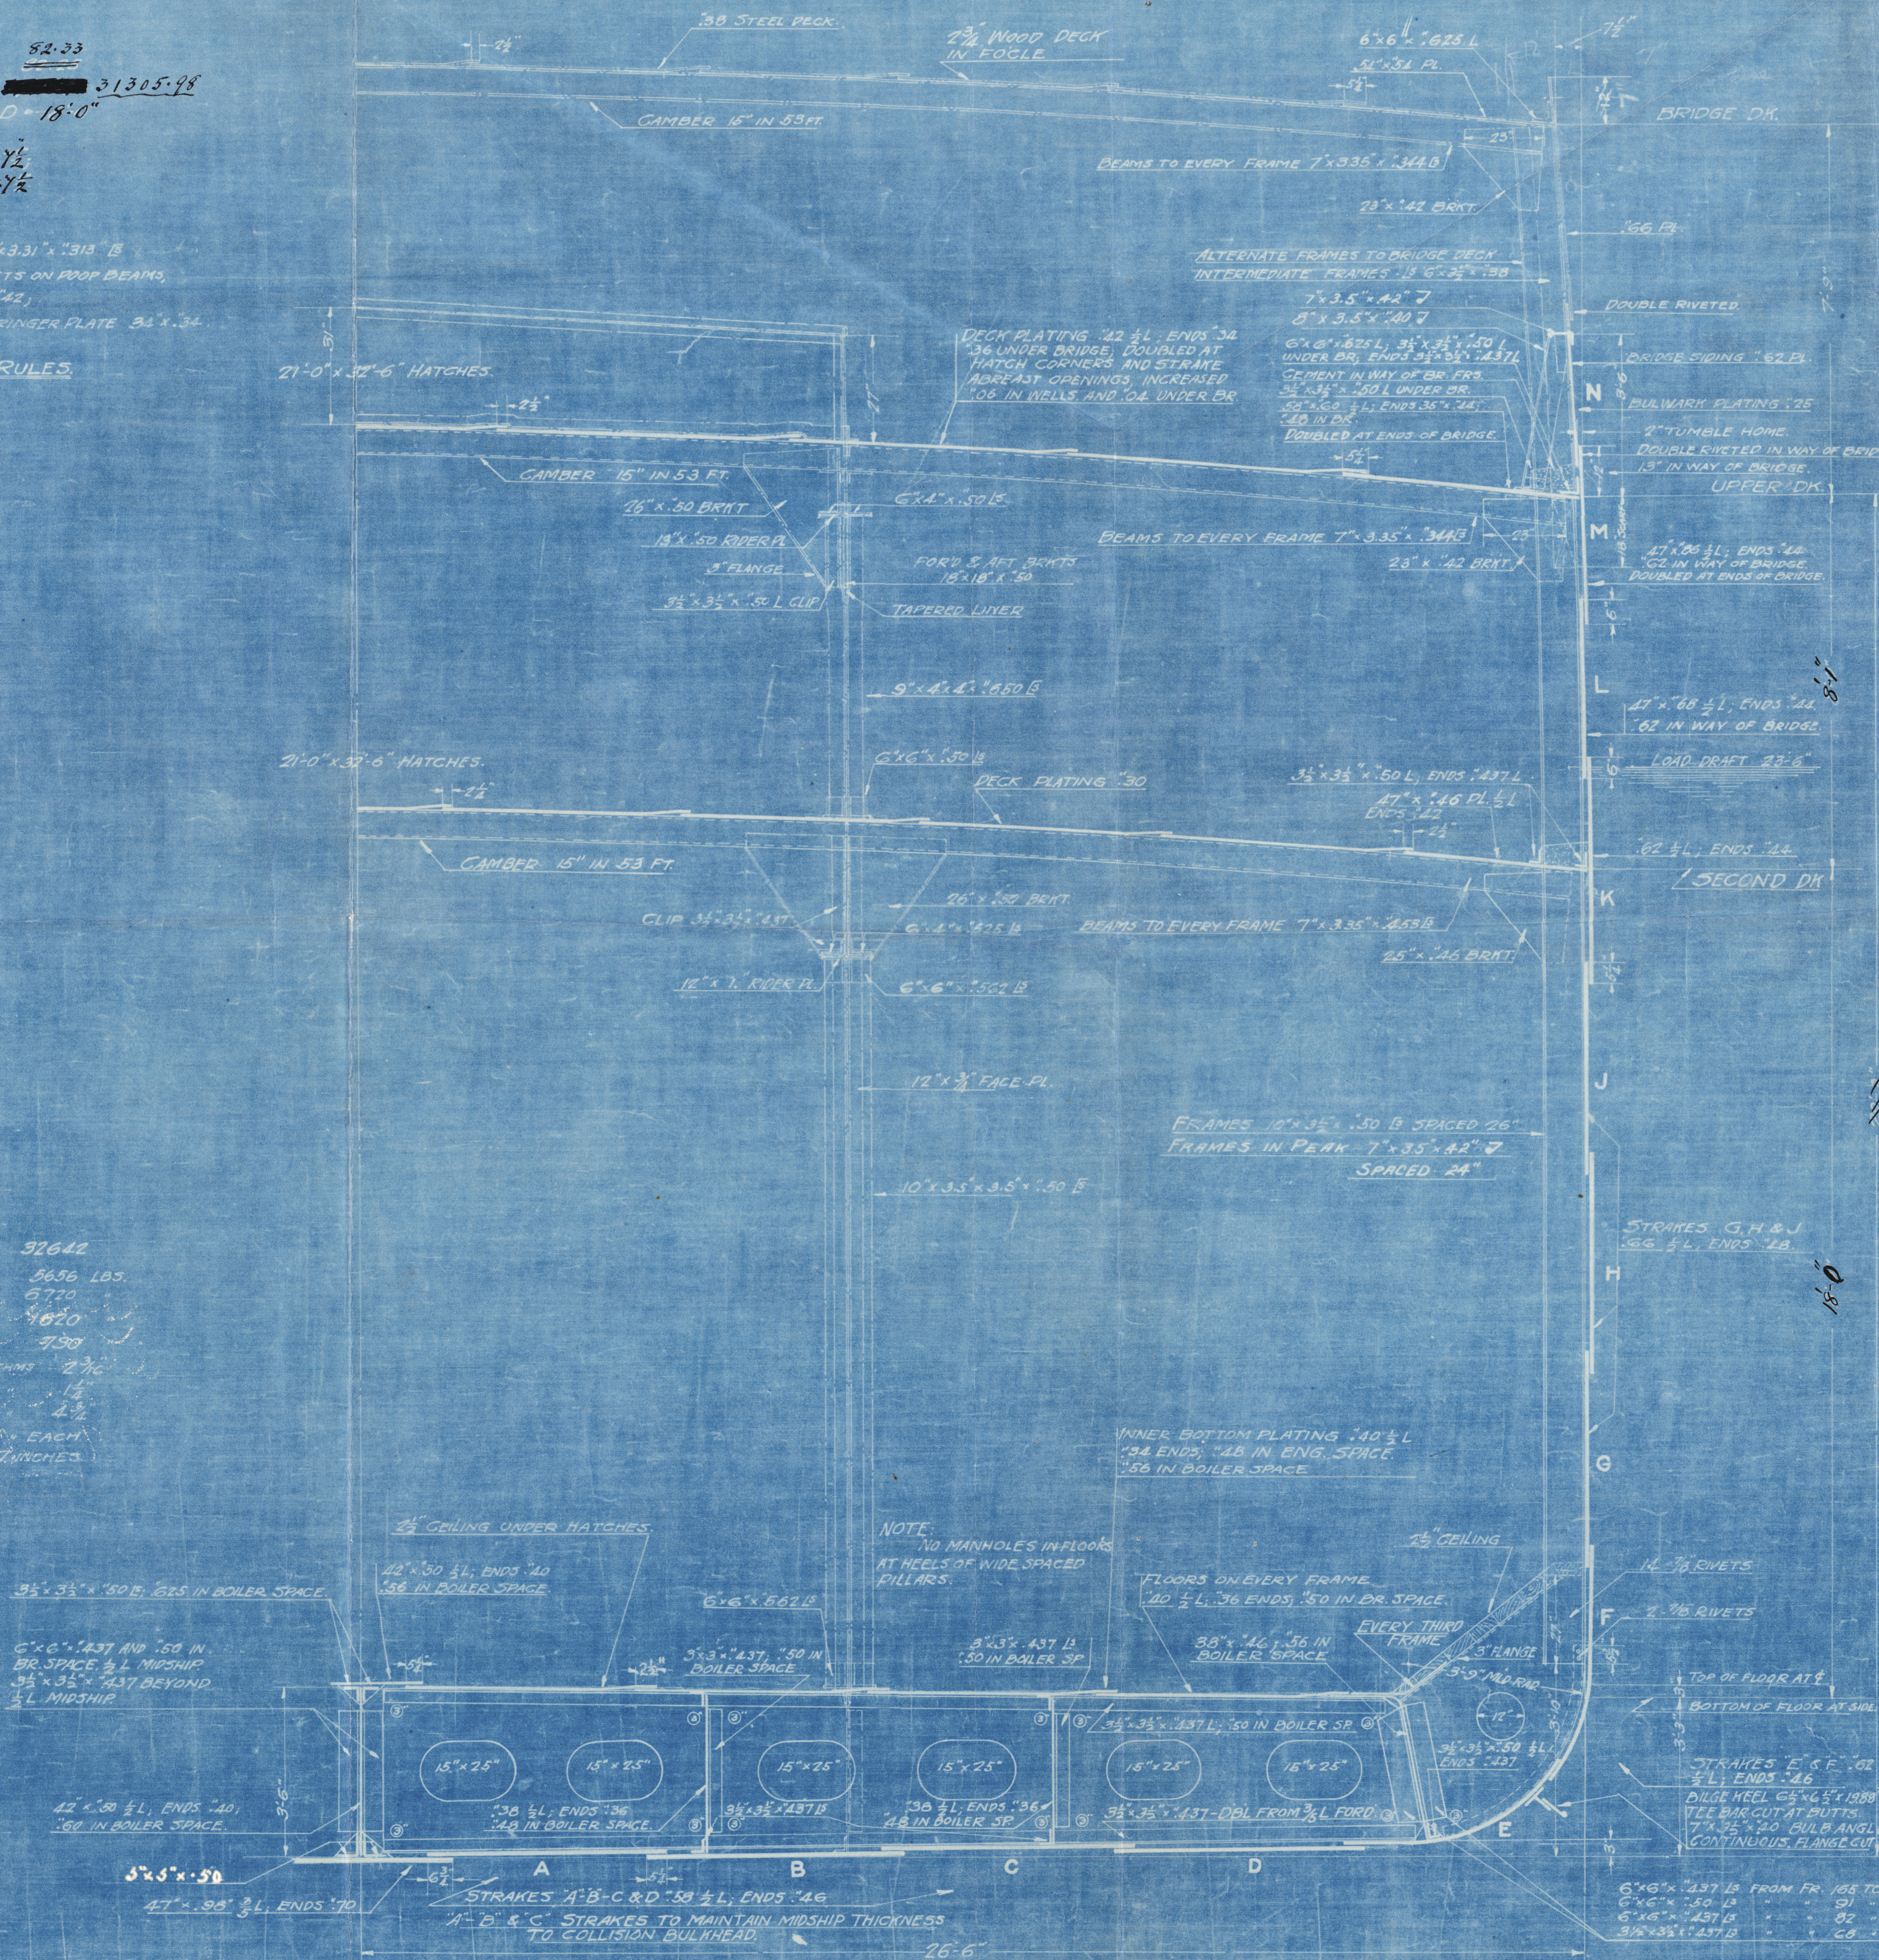

2 prints Office
 DUPLICATE FOR THE SHIP
 DUPLICATE FOR THE
 DUPLICATE FOR THE
 DUPLICATE FOR THE
 Vessel No 92
 S.S. "Sacramento"
 MIDSHIP SECTION
 OF
 FREIGHT STEAMER
 LENGTH OVER ALL 380'-8"
 LENGTH LLOYD'S 380'-3"
 LENGTH BTW PERP'S 380'-0"
 BREADTH MOULDED 53'-0"
 DEPTH MOULDED TO UPPER DECK (P) 29'-4"
 DEPTH MOULDED TO 2ND DK 21'-3"
 LOAD DRAFT 23'-6"
 SEATTLE CONSTRUCTION & DRY DOCK CO.
 SHIPBUILDERS & ENGINEERS
 SEATTLE, WASH.
 SCALE 1/2" = 1'-0" MAR. 5-1917

DR. No 92-2

*High
2/2/2002*

006536-006551-0002



© 2021

Lloyd's Register
Foundation

Seattle Const. & Dry Dock Co.

Vessel No: 92 S. S. Sacramento
Midship's Section

Seattle Rpt. No. 572

