




18.12.03 No 10517

10/12/03

No 714

CAST STEEL STEM PIECE.

SCALE $\frac{3}{4} = 1$ FOOT.

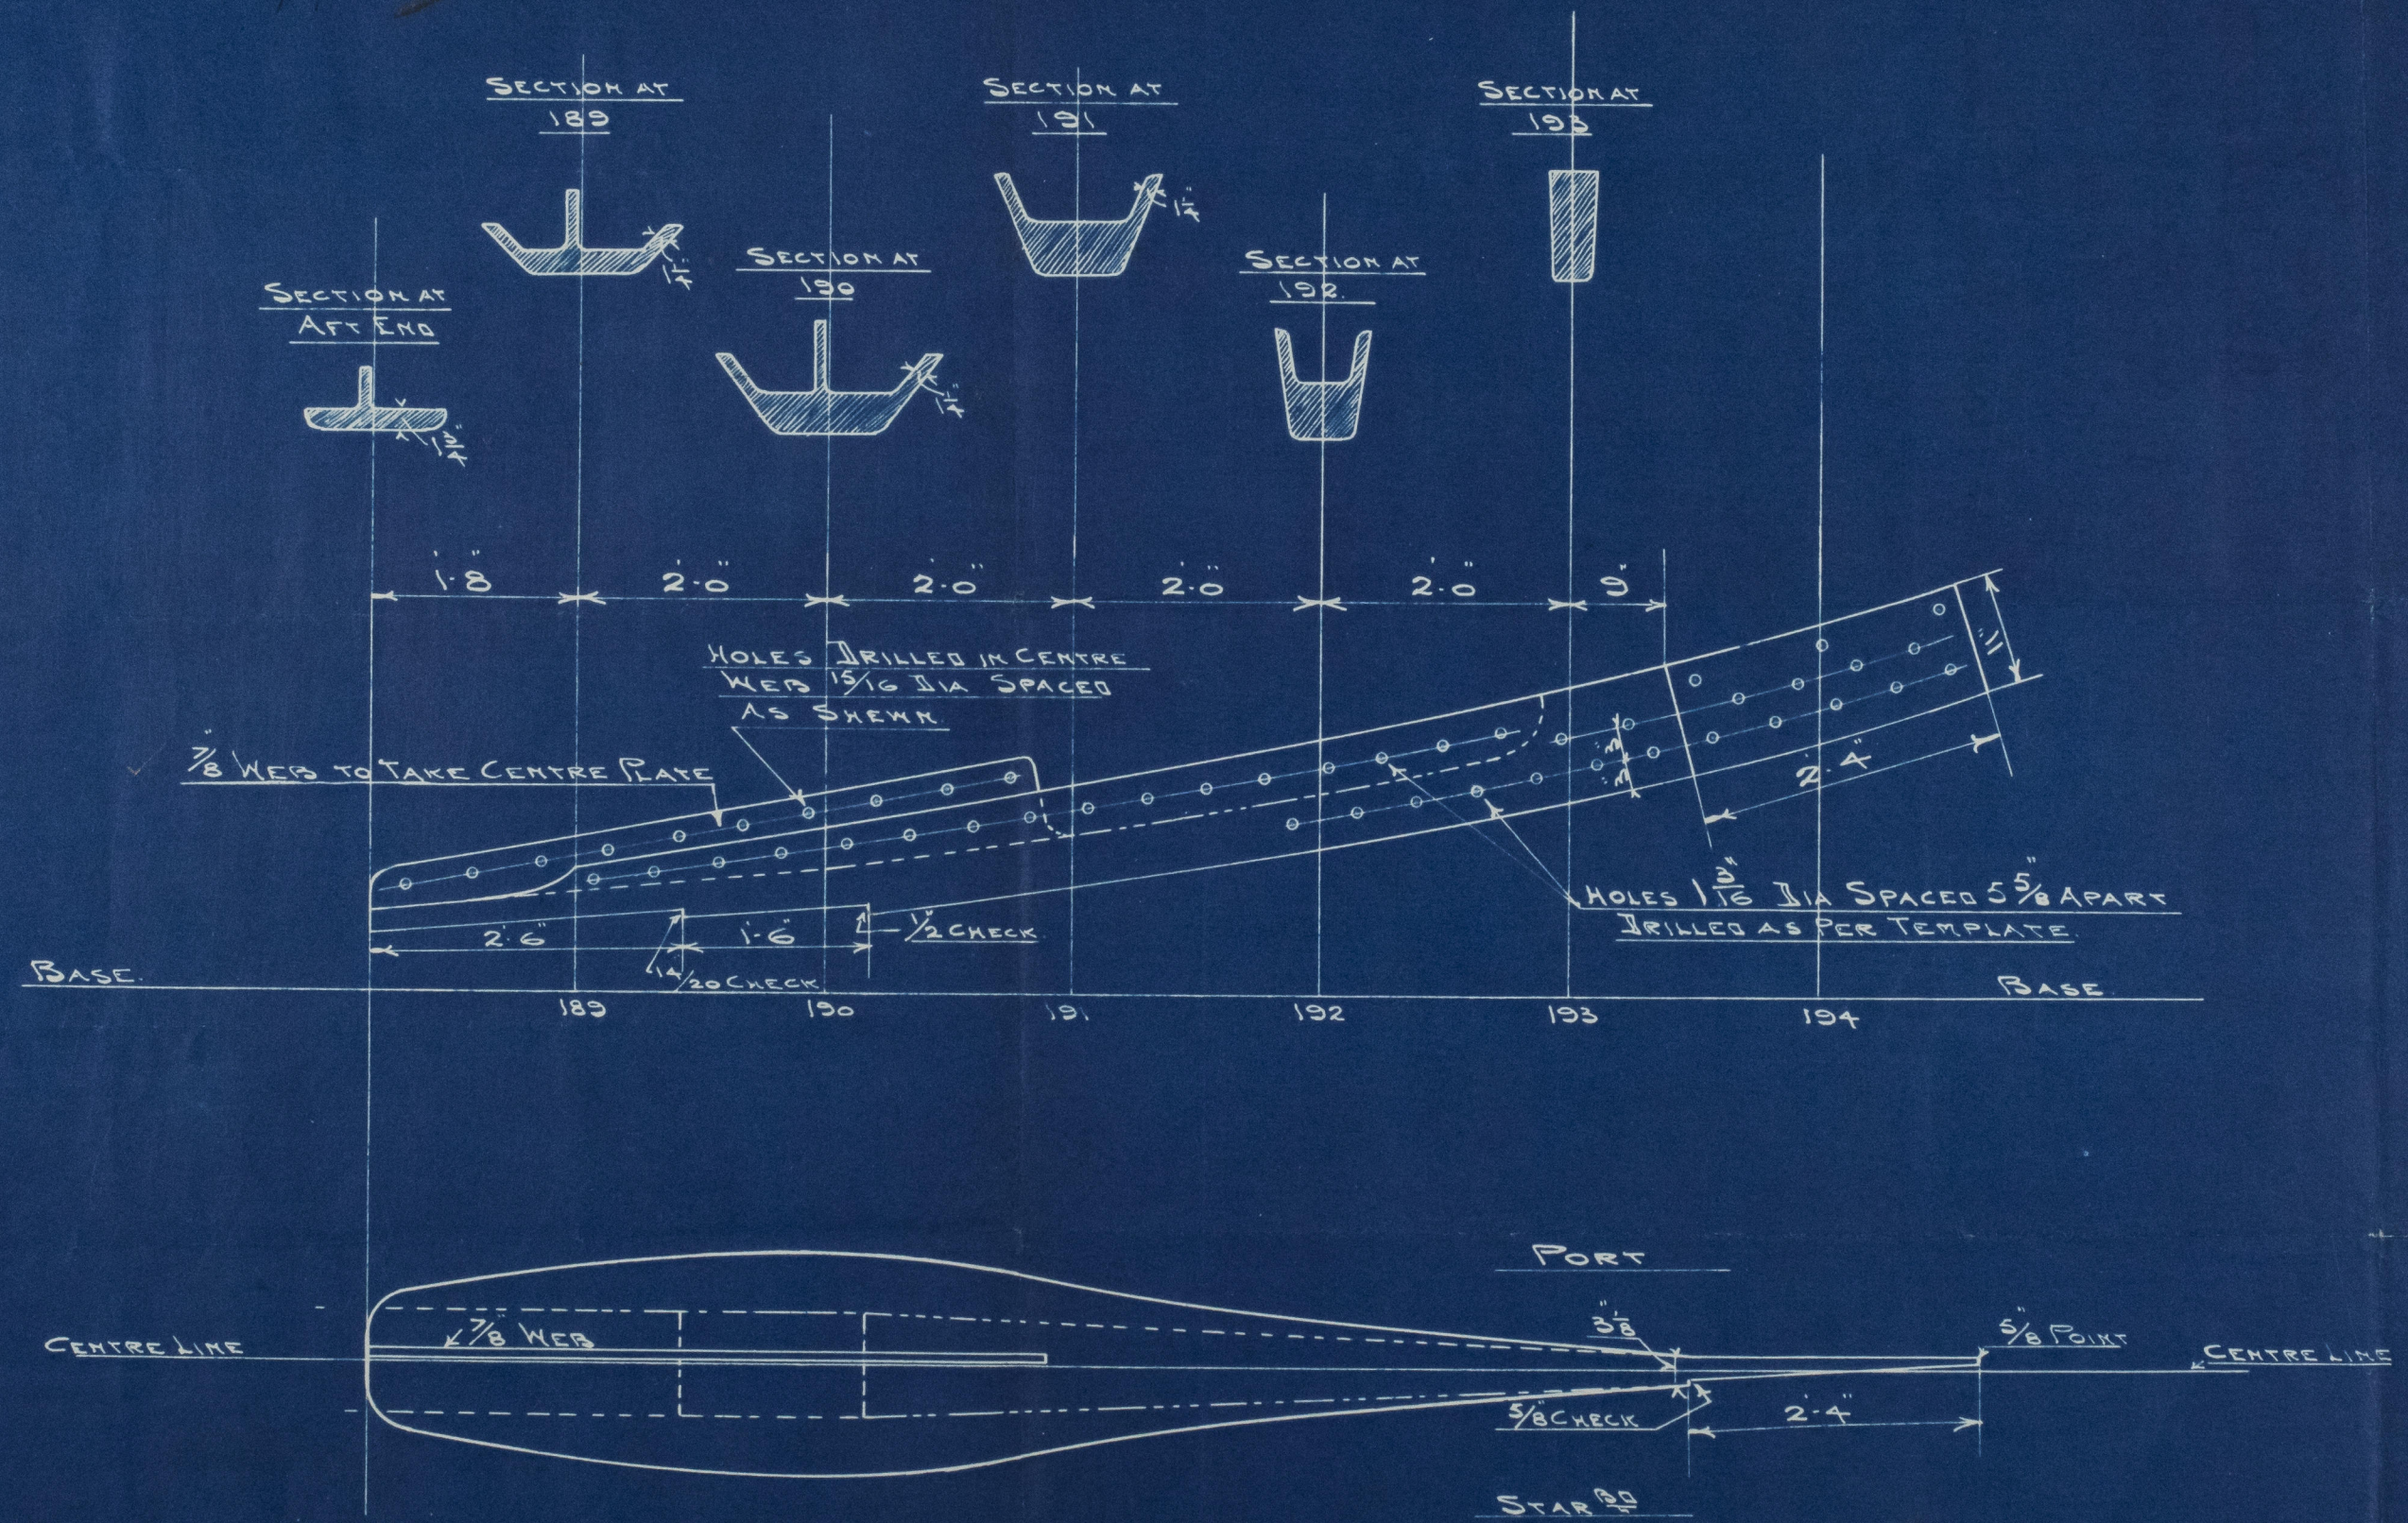

Lloyd's Register Foundation

Newcastle-on-Tyne
Messrs. Swan, Hunter
& Wigham-Richardson
No. 714

Cast Steel Stem Piece



J. S. Cristofels
Newcastle Report
No. 44346

006552-006563-0151



© 2021

Lloyd's Register
Foundation