

# S.S. WEST GALETA

Approved  
Chas. E. Davis  
May 12/17

SCALE  $\frac{1}{2}'' = 1'$

CASE 14 SHEET 66

## MIDSHIP SECTION STEEL FREIGHT STEAMER

423'-9" OVER ALL 410'-5 1/2"-54' BEAM 29'-9" DEPTH.

### LLOYD'S NUMERALS

1 <sup>ST</sup> NUMERAL	54 + 29.75	= 83.75
2 <sup>ND</sup> "	83.75 x 410.45	= 34375.0
DEPTH (d)		= 18'-0"
PROPORTIONS	TO BRIDGE DK = 10.73	
	TO UPPER DK. = 13.79	

### EQUIPMENT NUMBER


PLATING NUMBER	54375
FORECASTLE	41 x 8 x 3/4 = 246
BRIDGE	110 x 8 x 3/4 = 660
POOP	55 x 8 x 3/4 = 330
DECK HOUSES	52 x 8 x 1/2 = 208
EQUIPMENT No	35819

### EQUIPMENT

2 BOWER ANCHORS	7150 LBS. EACH
1 " "	6160 "
1 STREAM "	2450 "
1 KEDGE "	1050 "
(ALL STOCKLESS ANCHORS)	
270 FTMS 2 1/4" STUD CHAIN CABLE	
90 " 4 1/4" STEEL WIRE - (STREAM)	
120 " 5 " " (TOWLINE)	
HAWSEERS 2-8" AND 2-7" - 90 FTMS. EACH.	

### TRANSVERSE BULKHEADS.

PLATING	AS PER RULE
STIFFENERS	
COLLISION BND. HOLD	12" x 4" x 4" x 40' L SPACED
24' BKT ATTACHMENT	TWEEN DECK 5" x 3" x 9.8"
ANGLE SPACED 24'	NO LUG ATTACHMENT
REMAINDER OF BND.	AS PER RULE SPACED
30' LUG ATTACHMENT	TWEEN DECK 5" x 3" x 9.8"
ANGLE SPACED 30'	NO LUG ATTACHMENT
BOUNDARY BARS	
CONNECTION TO TANK TOP AND SHELL BELOW	24' BELOW TOP OF BULKHEAD 5" x 5" x 18.1" SINGLE
ANGLE CONNECTION TO SHELL ABOVE 24' BELOW	TOP OF BULKHEAD 3 1/2" x 3 1/2" x 9.8" SINGLE ANGLE
CONNECTION TO DECK	3" x 3" x 7.2" SINGLE ANGLE

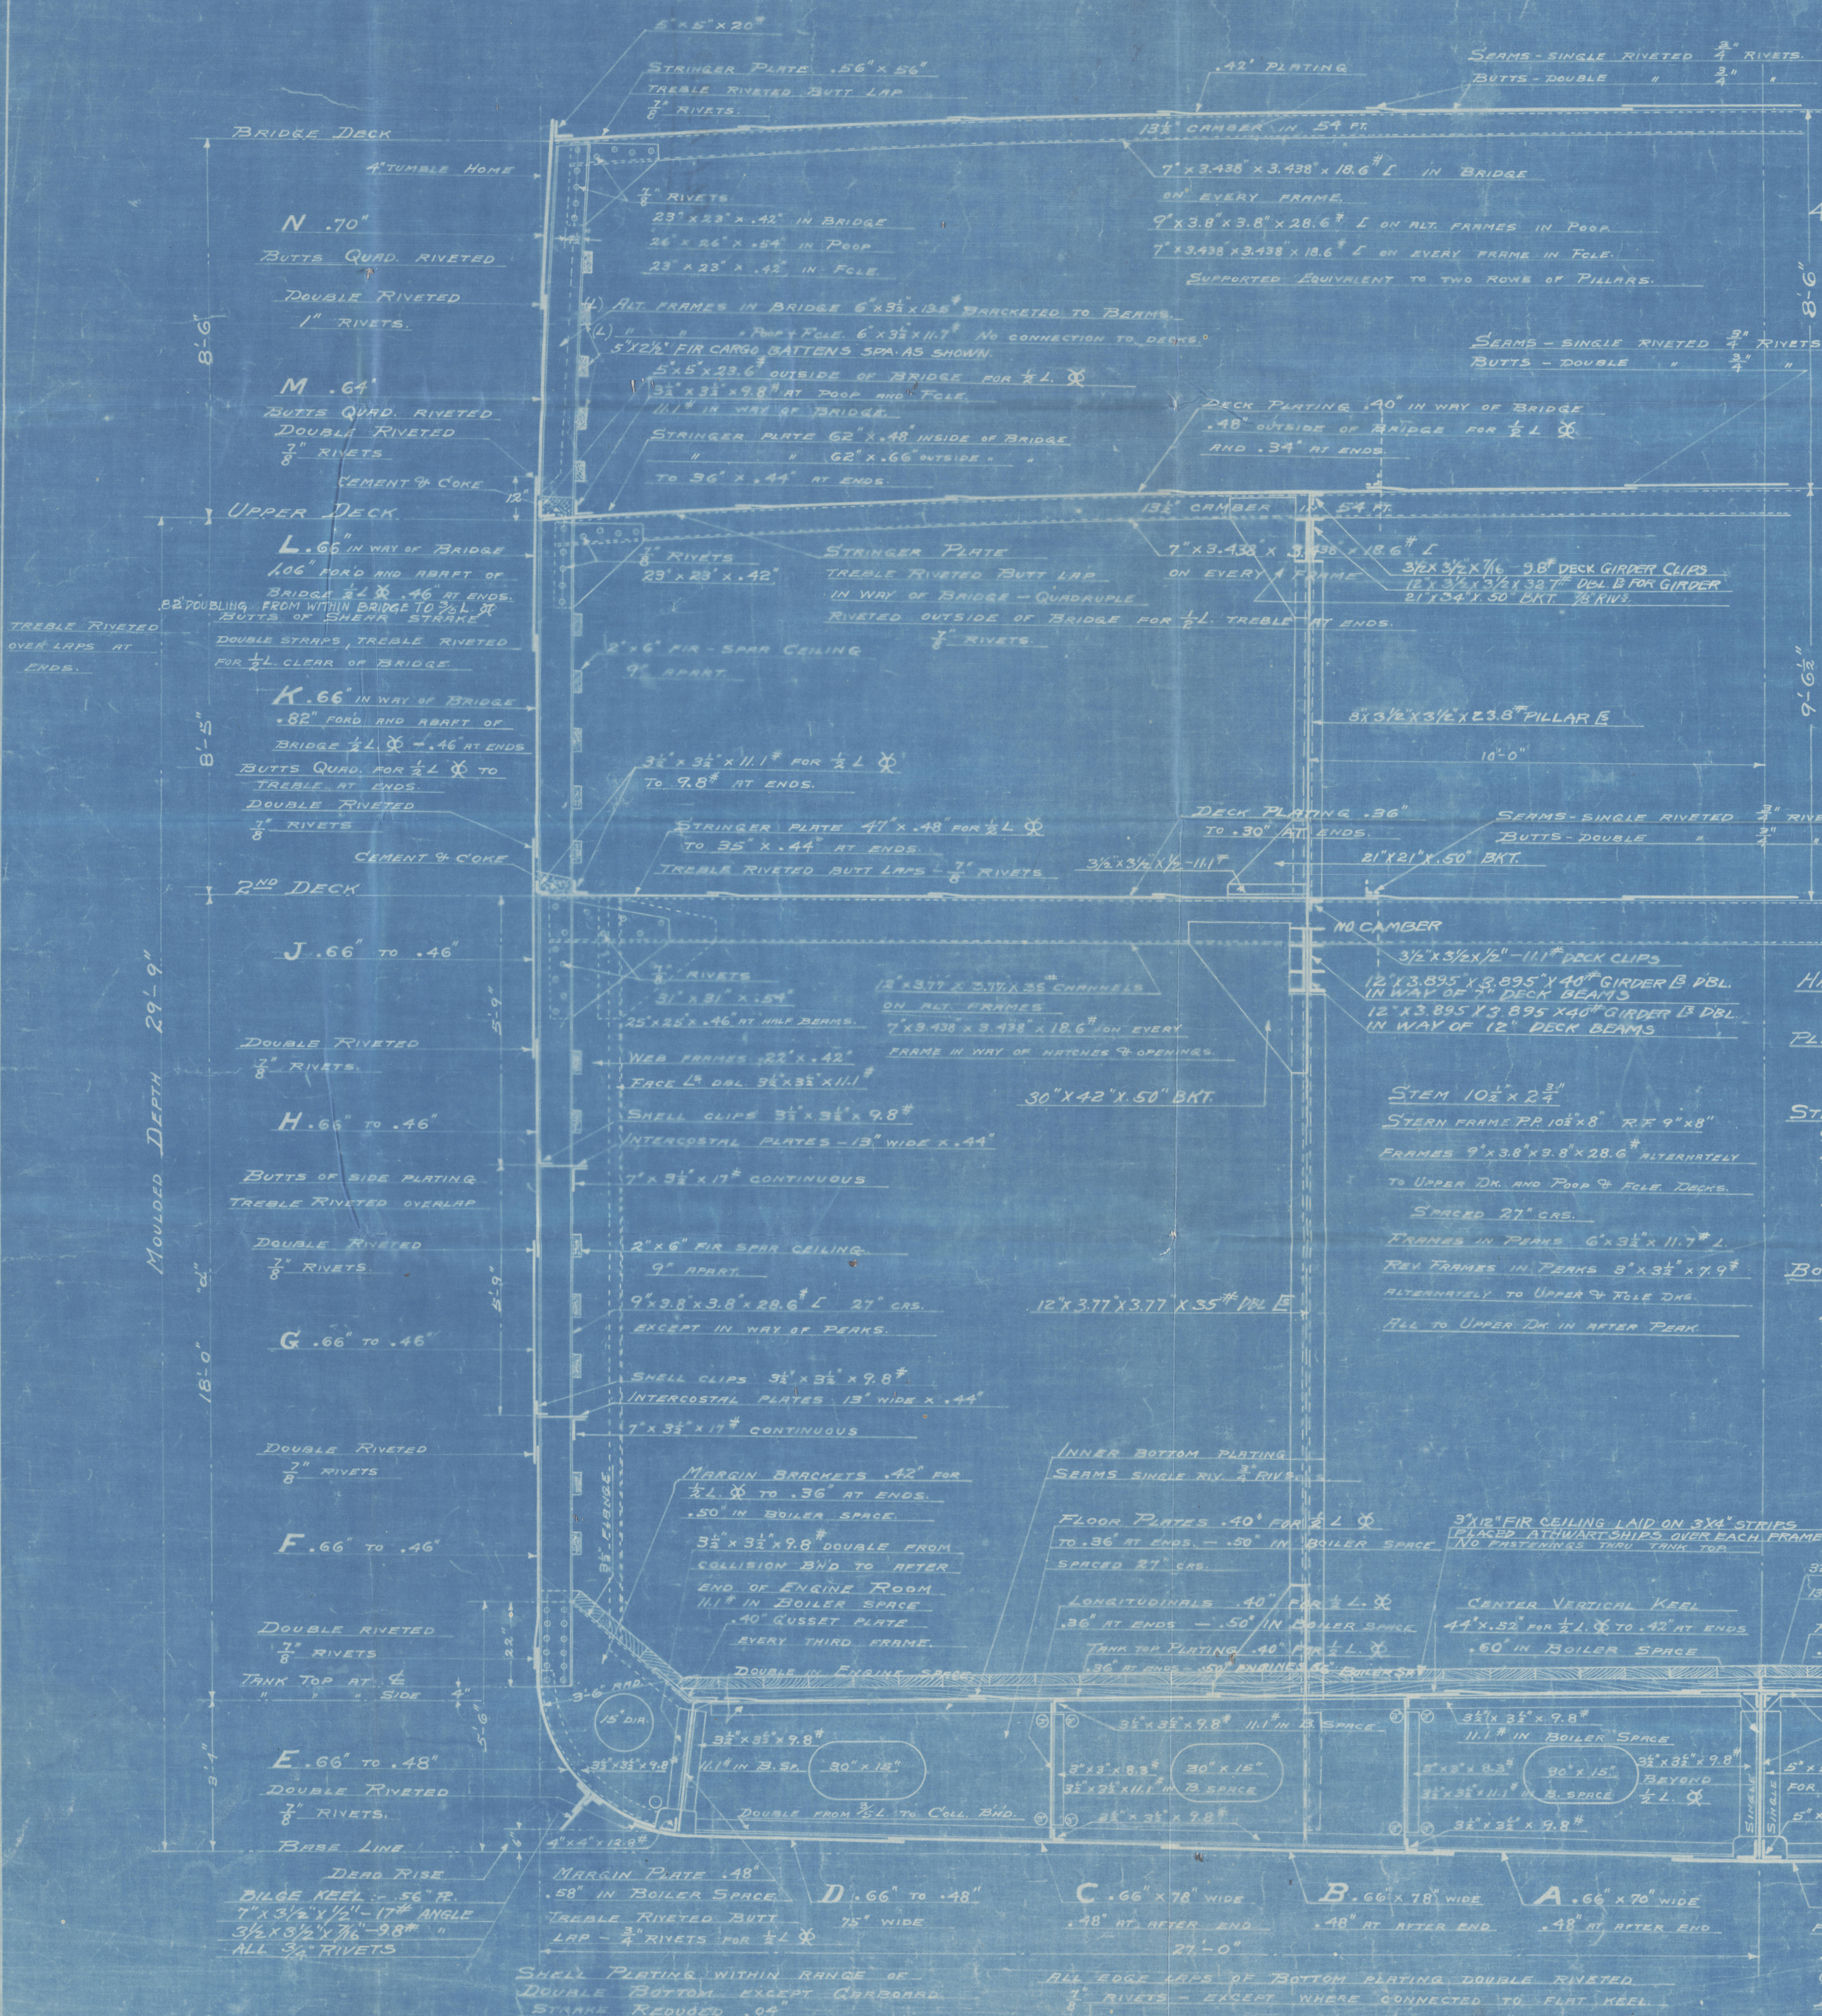


3 1/2" x 3 1/2" x 12.4"	
13.6" IN BOILER SPACE	
RIDER PLATE 44" x 52" FOR 1/2 L	
.42" AT ENDS - .56" IN BOILER SPACE	
DOUBLE RIVETED EDGE LAP	
7" RIVETS	
RIDER PLATE AND	
CENTER VERTICAL KEEL	
TREBLE RIVETED BUTT LAPS	
1 1/2" RIVETS	
KEEL PLATE 47" x 1.02"	
FOR 1/2 L TO .72" AT ENDS	
BUTTS - OVERLAPPED	
QUADRUPLE RIVETED - 18" RIVETS	
DOUBLE RIVETED EDGE LAP	



Mr. Bennett

0288

S.S. "WEST GALETA"  
Midship Section  
of vessel as built  
— Hull No 6 —  
Los Angeles S.B. District  
San Pedro  
Cal.  
(Port of Los Angeles Cal.)  
S-70 Rpt No 2823

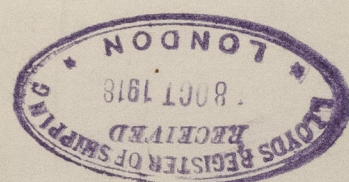

006552- 006563 - 0288



© 2021  
Lloyd's Register  
Foundation



OFFICE COPY

BLUE PRINT DEPT.  
ISSUED  
JUL 19 1988

8820



© 2021

Lloyd's Register  
Foundation