
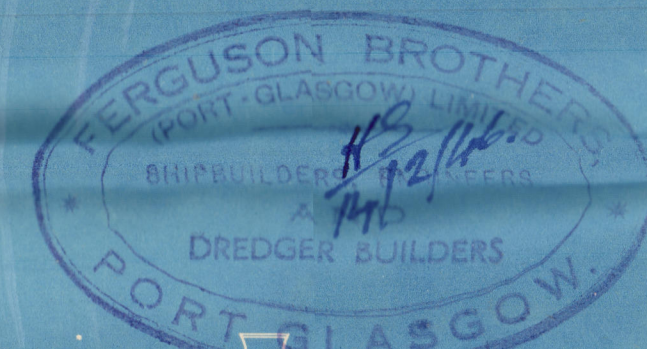


"EMPIRE FRIEDA."

TO CLASS + 100 AL. FOR TOWING SERVICES.

SCALE: $\frac{1}{4}$ INCH = 1 FOOT.

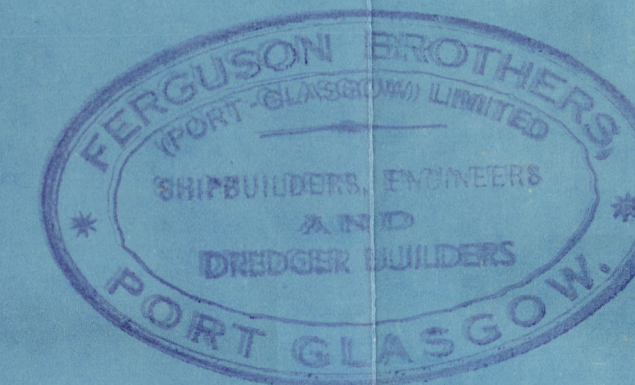

Gorguson Bros (P. S.) Ltd

Land No. 377

Empire Frieda



Profite & Duck
as fitted

(2)



© 2020

Lloyd's Register
Foundation

006564-006572-0084