


FERGUSON BROTHERS (PORT GLASGOW) LTD

SHIP NOS 377 AND 378 FABRICATED RUDDER AND STERNFRAME

8 FEB 1941

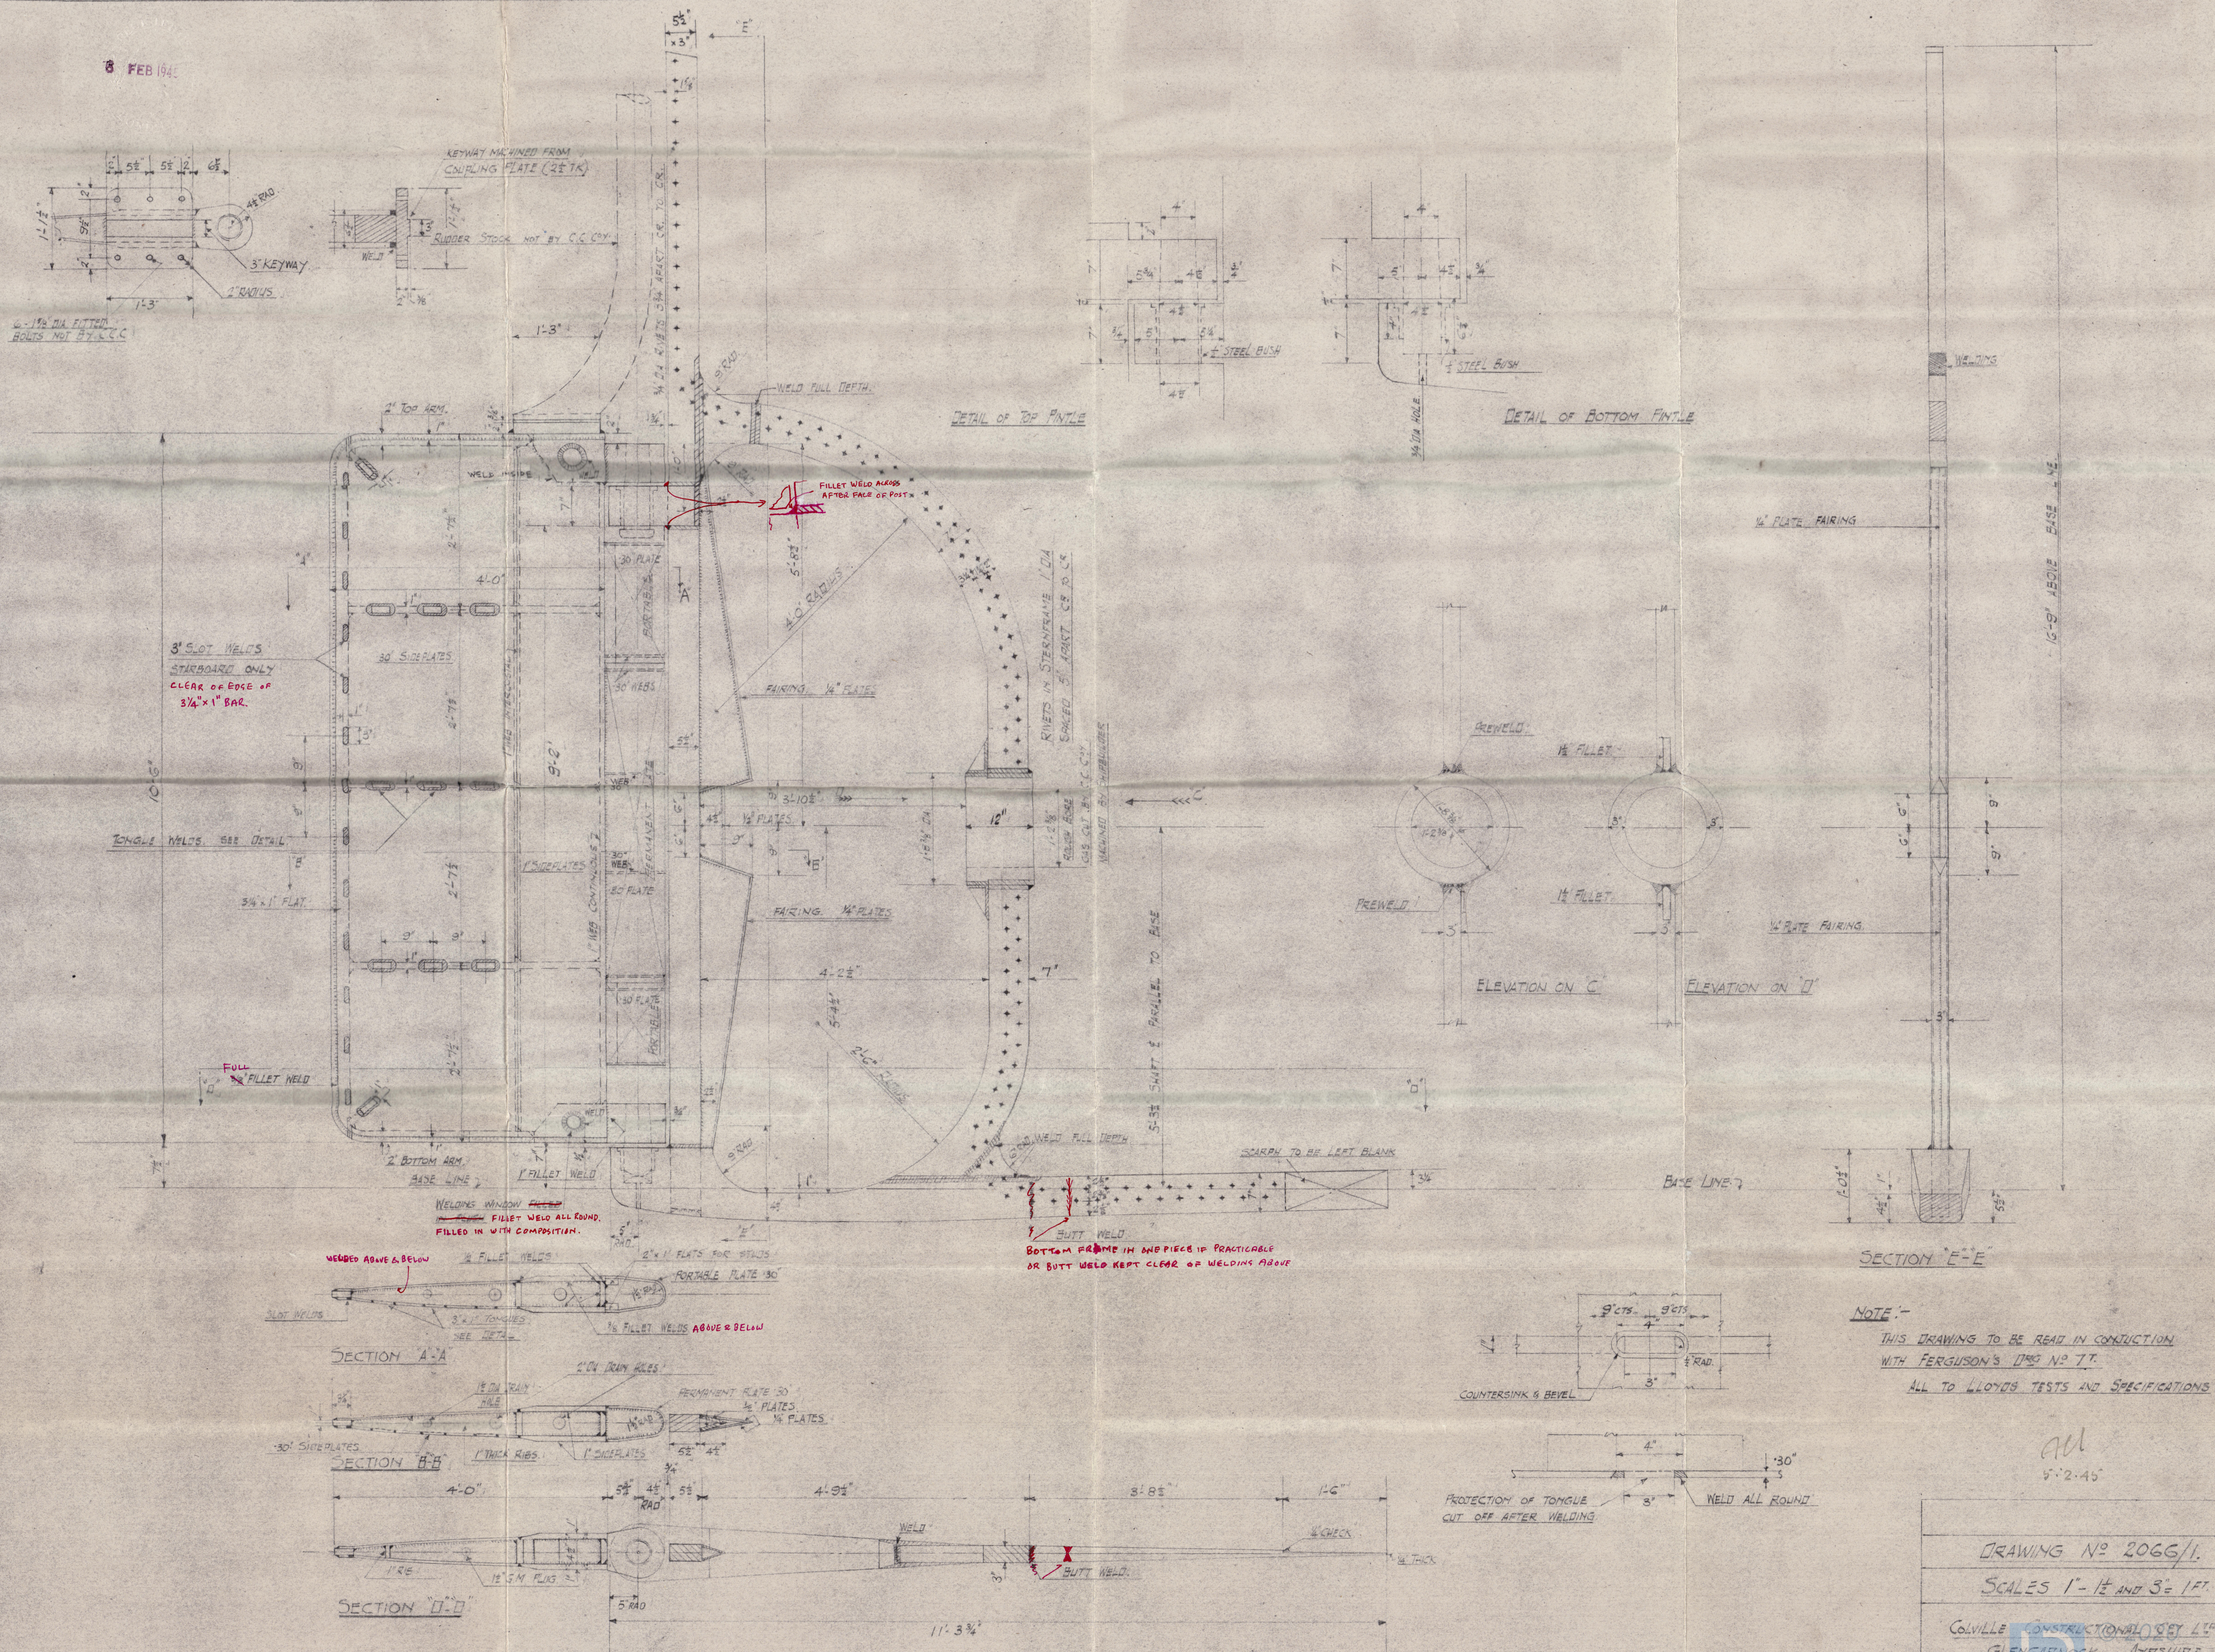



Lerguson Bros.

Land No. 377-S.




Rudder & Sternframe

377

"EMPIRE FRIEDA"



GRK. F.E. RPT. No. 23237

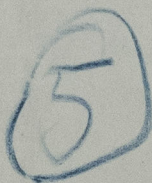

© 2020

Lloyd's Register  
Foundation

006564-006572-0087