

Amended Copy
affixed 1/11/14
J. H. Thompson



HULL No 134 SHELL EXPANSION.		
Great Lakes Engineering Works.		
Drawn by A.W.S.	DETROIT, MICH. HULL DEPT.	Checked by
Traced by A.W.S.	Scale 1/8" = 1' Feet	Date JAN. 8-1914.

Great Lakes No 134

Shell Expansion



Wagon



© 2020

Lloyd's Register
Foundation

006573-006588-0015

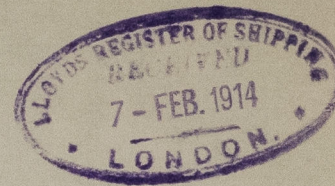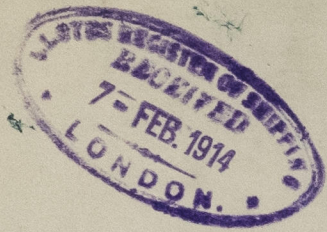

© 2020

Lloyd's Register
Foundation