

16.4.08

N^o 478.

SAND PUMP HOPPER DREDGER.

TO BE CLASSED AT LLOYDS - A.I. STEEL DREDGER SPECIAL SURVEY.

SCALE $\frac{1}{8}$ " = ONE FOOT.

W. SIMONS & CO., LTD
LONDON & WORKS,
RENFREW.

14/4/08.

LLOYDS NUMERALS.

$\frac{1}{2}$ GIRTH = 20.29.

$\frac{1}{2}$ BREADTH = 11.50.

DEPTH = 10.23

42.02 1ST NUMERAL.


LENGTH = 122.00

8.404

8.404

4.202

5126.44 2ND NUMERAL.

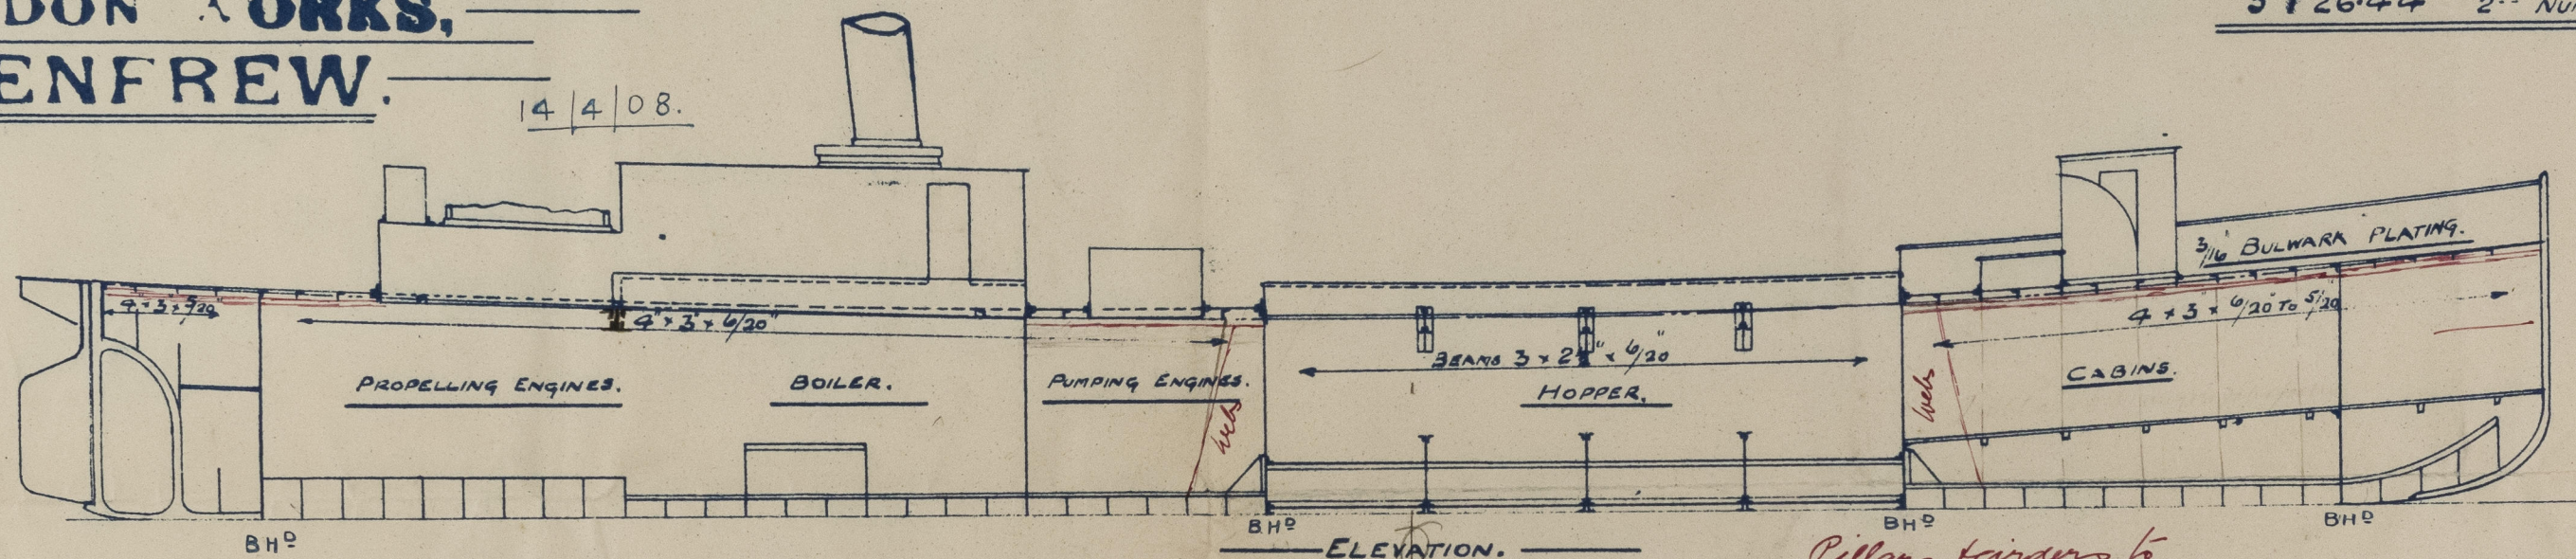

DIMENSIONS.

LENGTH BETWEEN PERPS. 123'-0".

BREADTH ML^o. 23'-0".


DEPTH D^o. 9'-9".

Pillars to girder to
Surveyor satisfaction.

PROPORTIONS.

$\frac{L}{B}$ = 5.30.

$\frac{L}{D}$ = 11.92.

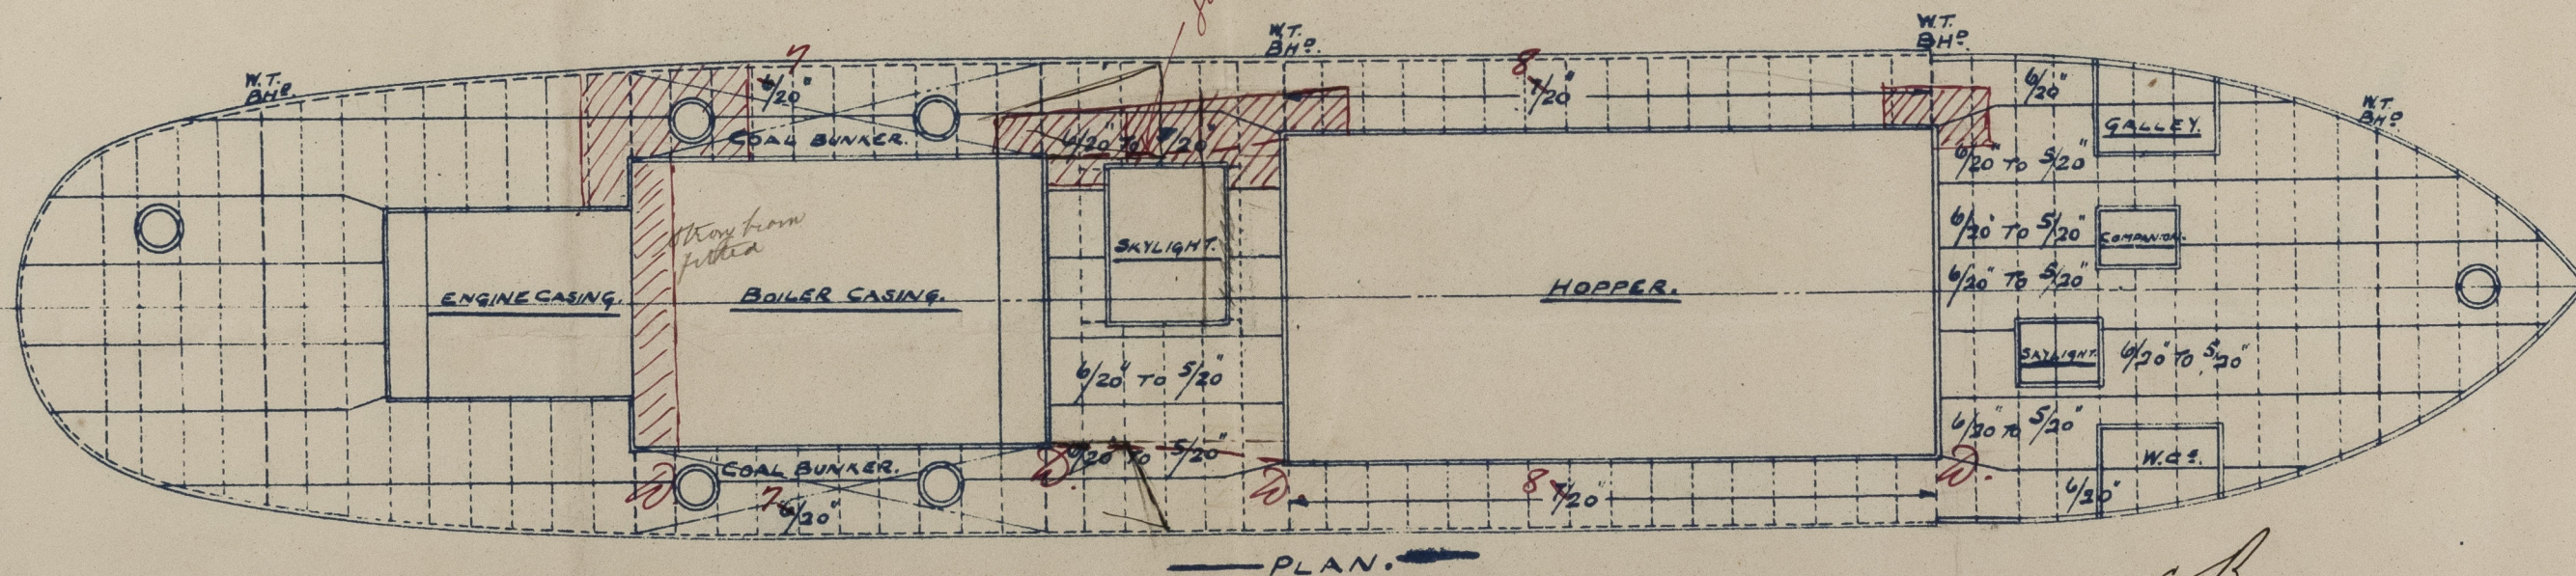


C.B.
16.4.08.

Messrs W. Arncliffe & Co

No 478

Profile & DR Plan

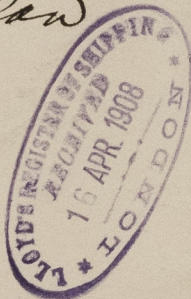

"Macquarie"

GLASGOW Report No. 27148.



© 2020

Lloyd's Register
Foundation