

17/3/10

S.S. Nos 133 & 4.

MIDSHIP SECTION.


STEEL SCREW FLEETERS.

22-3-10.

NUMERALS	
1/2 BREADTH	10.75
DEPTH	13.42
1/2 GIRTH	19.52
1 <sup>ST</sup> NO	43.69
LENGTH	108.875
2 <sup>ND</sup> NO	4756.748

DIMS: 110'-0" BP x 21'-6" x 12'-11" MLD  
 SCALE 1/2" = 1 FT.  
 TO CLASS 100 A.1. AT LLOYDS.

EQUIPMENT N° = 4756.		
1 ANCHOR	5 1/4 CWTs	EX STOCK
1 "	4 1/2 "	"
1 "	2 1/2 "	"
90 FT HWS	1 1/2 " STUD LINK CHAIN.	
60 "	5 1/2 " HAWSER	
60 "	4 " WARP.	

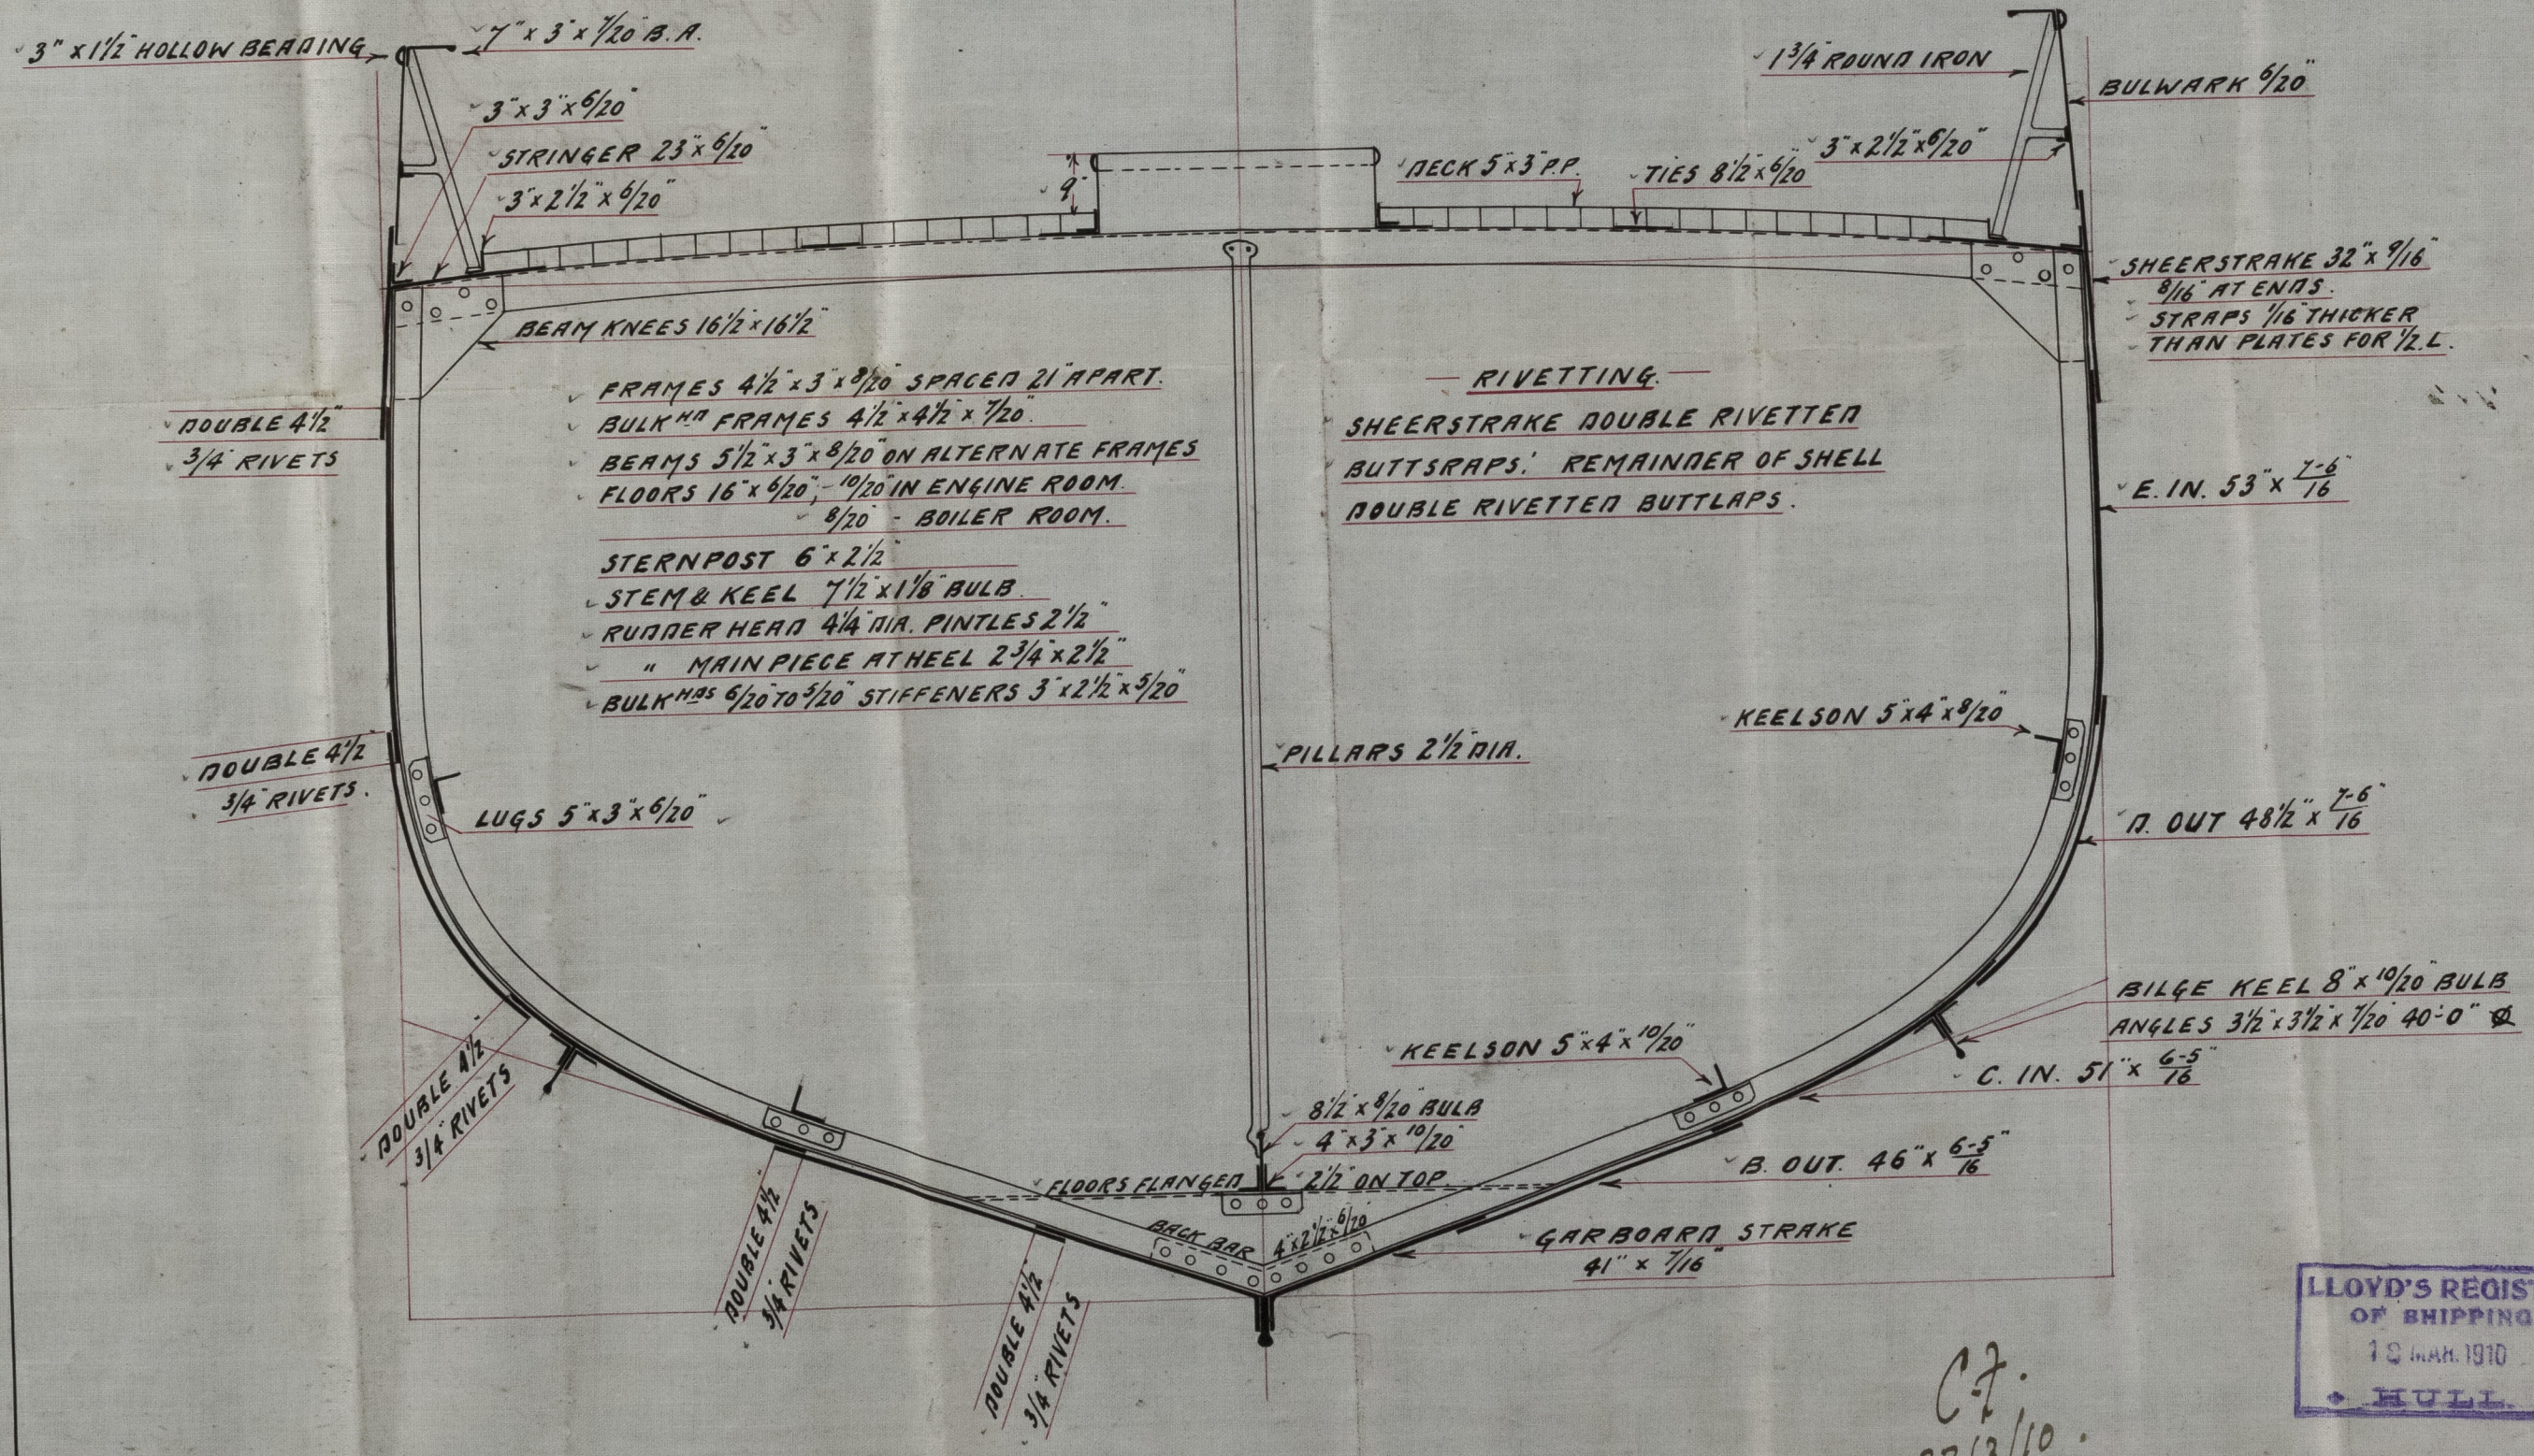

LLOYD'S REGISTER  
 OF SHIPPING.  
 19 MAR. 1910  
 HULL.

C7.  
 22/3/10.



-Mudshp Section-  
Goole S. & Co's

Nos 133 + 134

*W*

*3/4 "Grosbeak"*

Hull Report No. 22884

*3/4 Tanager*

Hull Rpt. No. 22977



© 2020

Lloyd's Register  
Foundation

006573-006588-0115