



22/1/18  
3.6.19

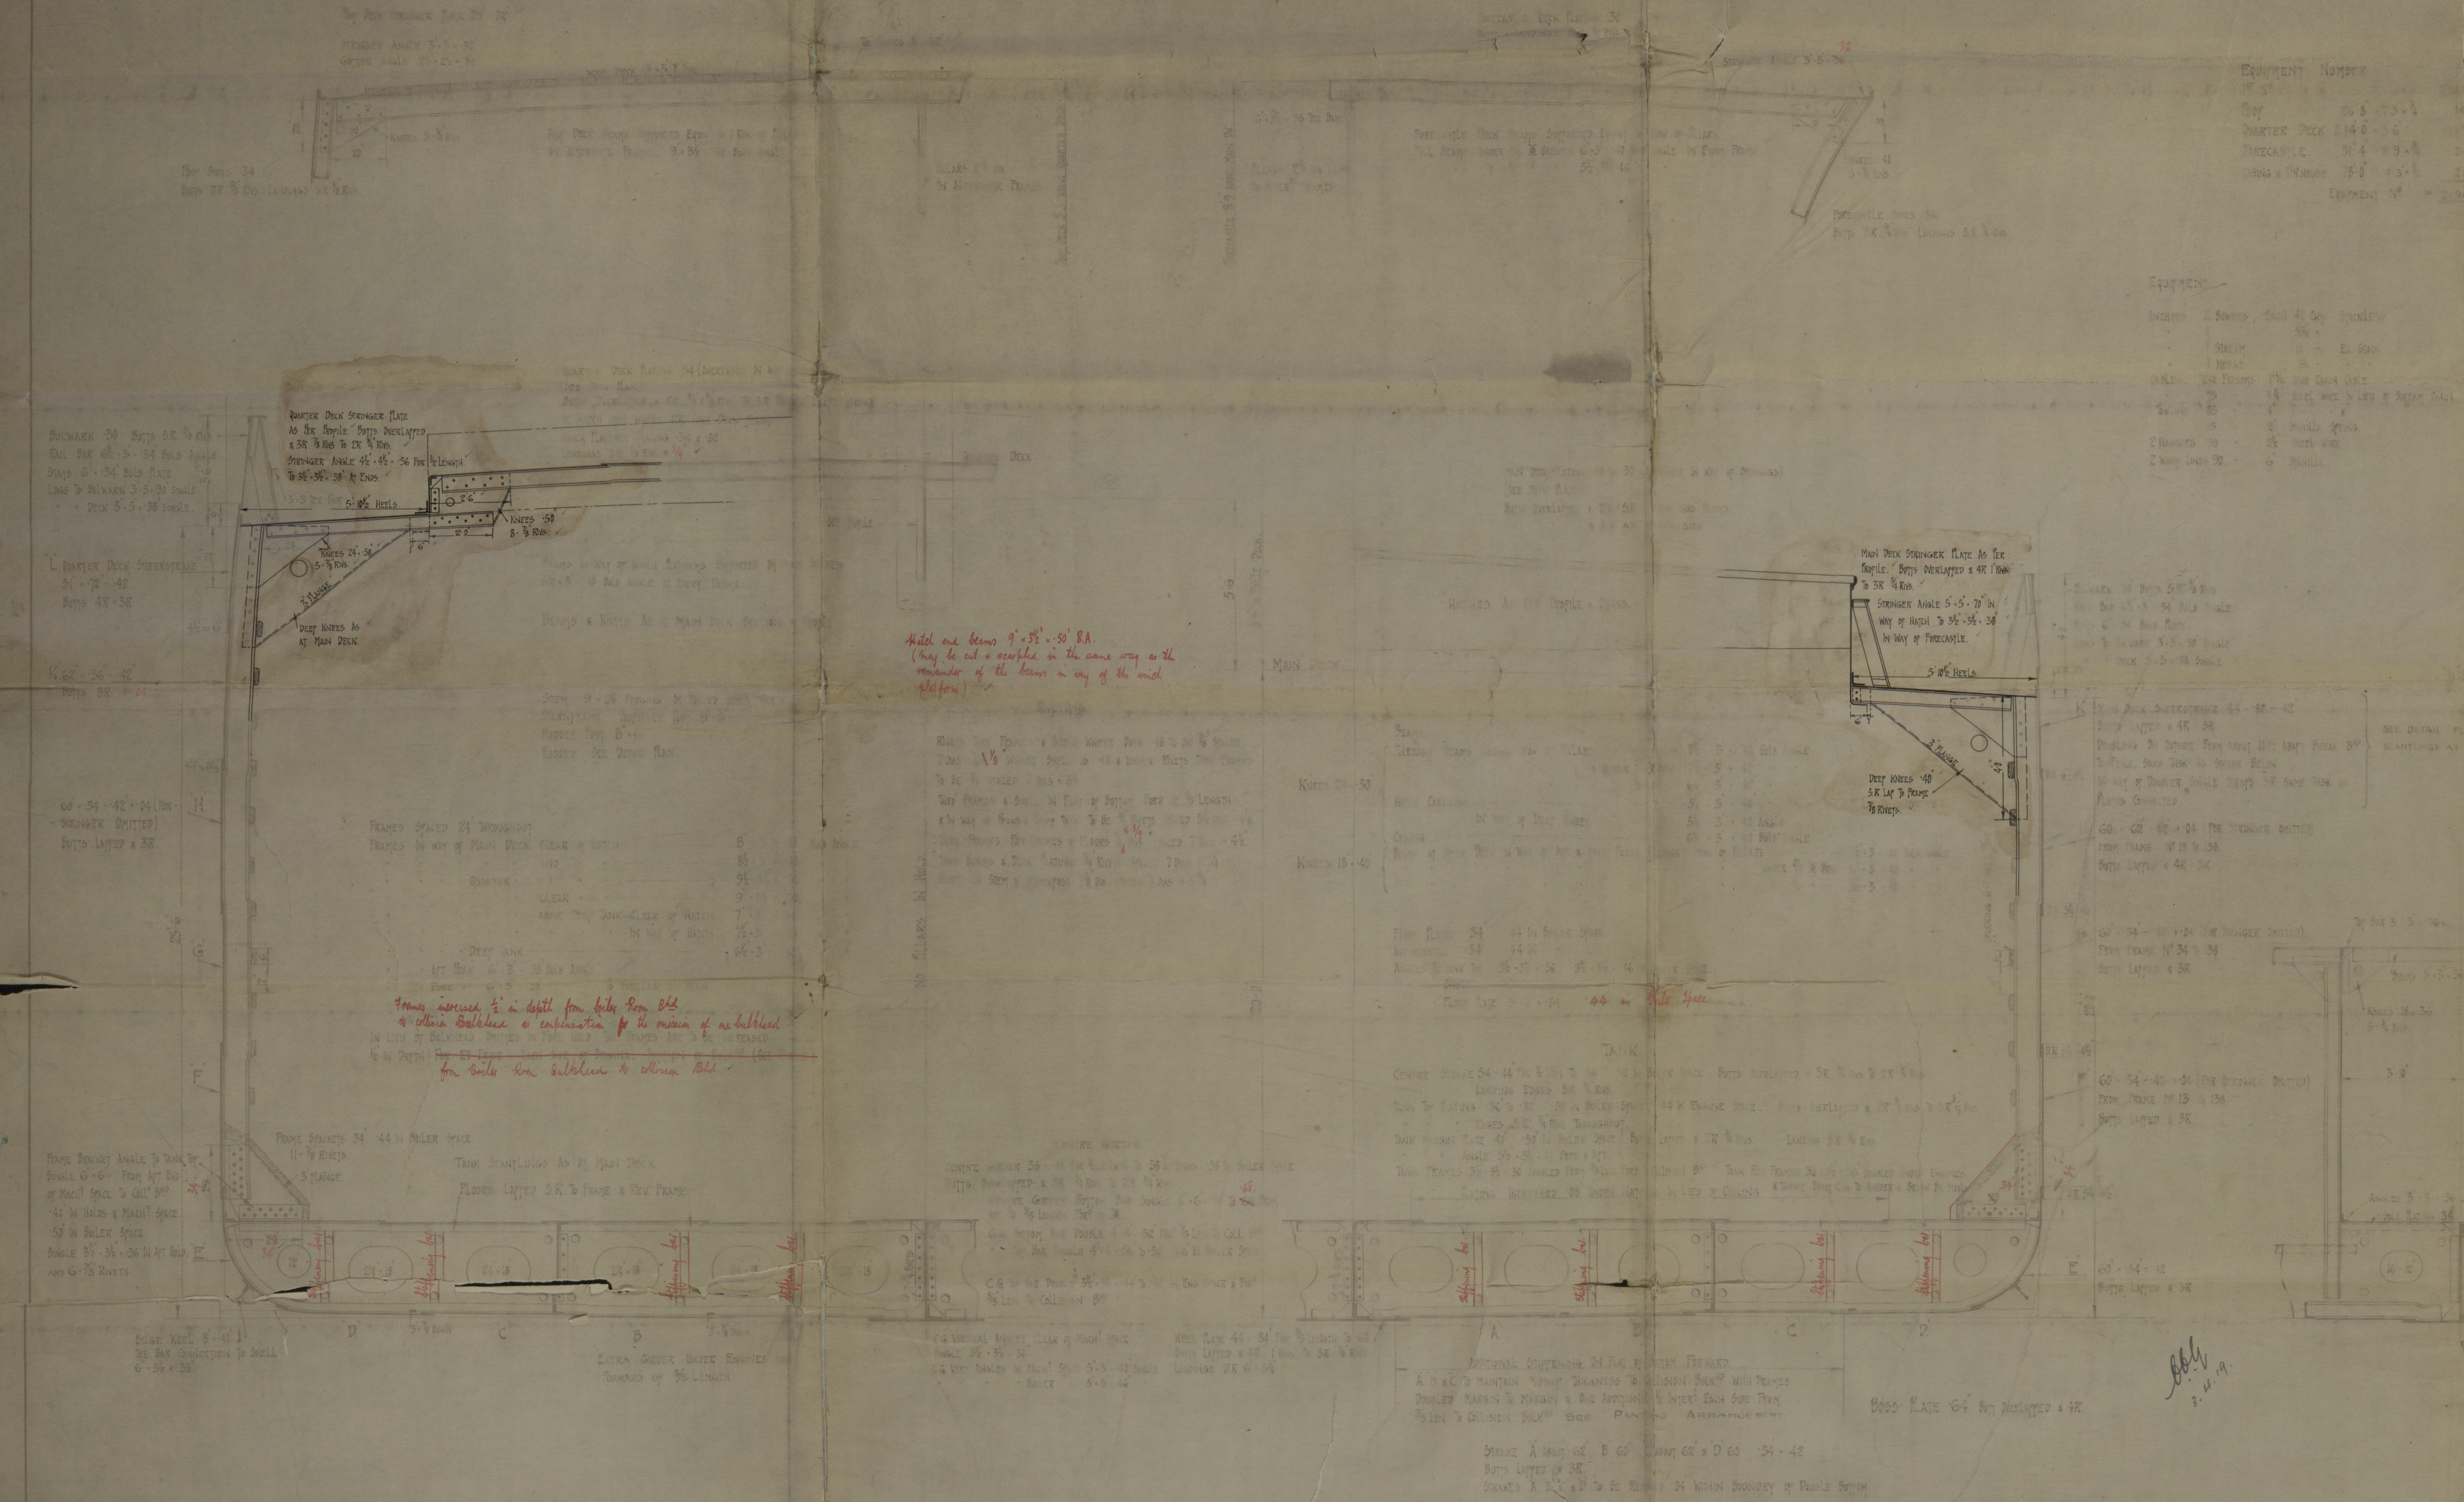

# S.S. N° 291. AMENDED MIDSHIP SECTION.

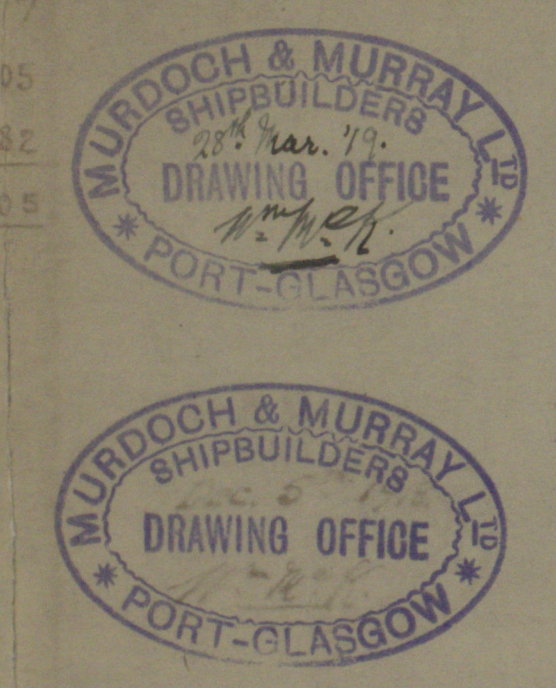


Dimensions 314'0" x 44'0" x 20'0" 25'6" in Quarter Deck  
B. CLASS +100 at L.L. 100  
RATED QUARTER DECK 5'6" COP 7'5" FORECASTLE 8'3"

LLOYD'S NOMINALS

TRANSVERSE	11'	64
LONGITUDINAL	11'	64
1st W. of Main Deck	16'0"	
2nd W. of Main Deck	22'4"	AMENDED 25'6"
3rd W. of Main Deck	27'8"	

NOTE: SCANTLING TO BE THE MINIMUM TO OBTAIN THE CLASS

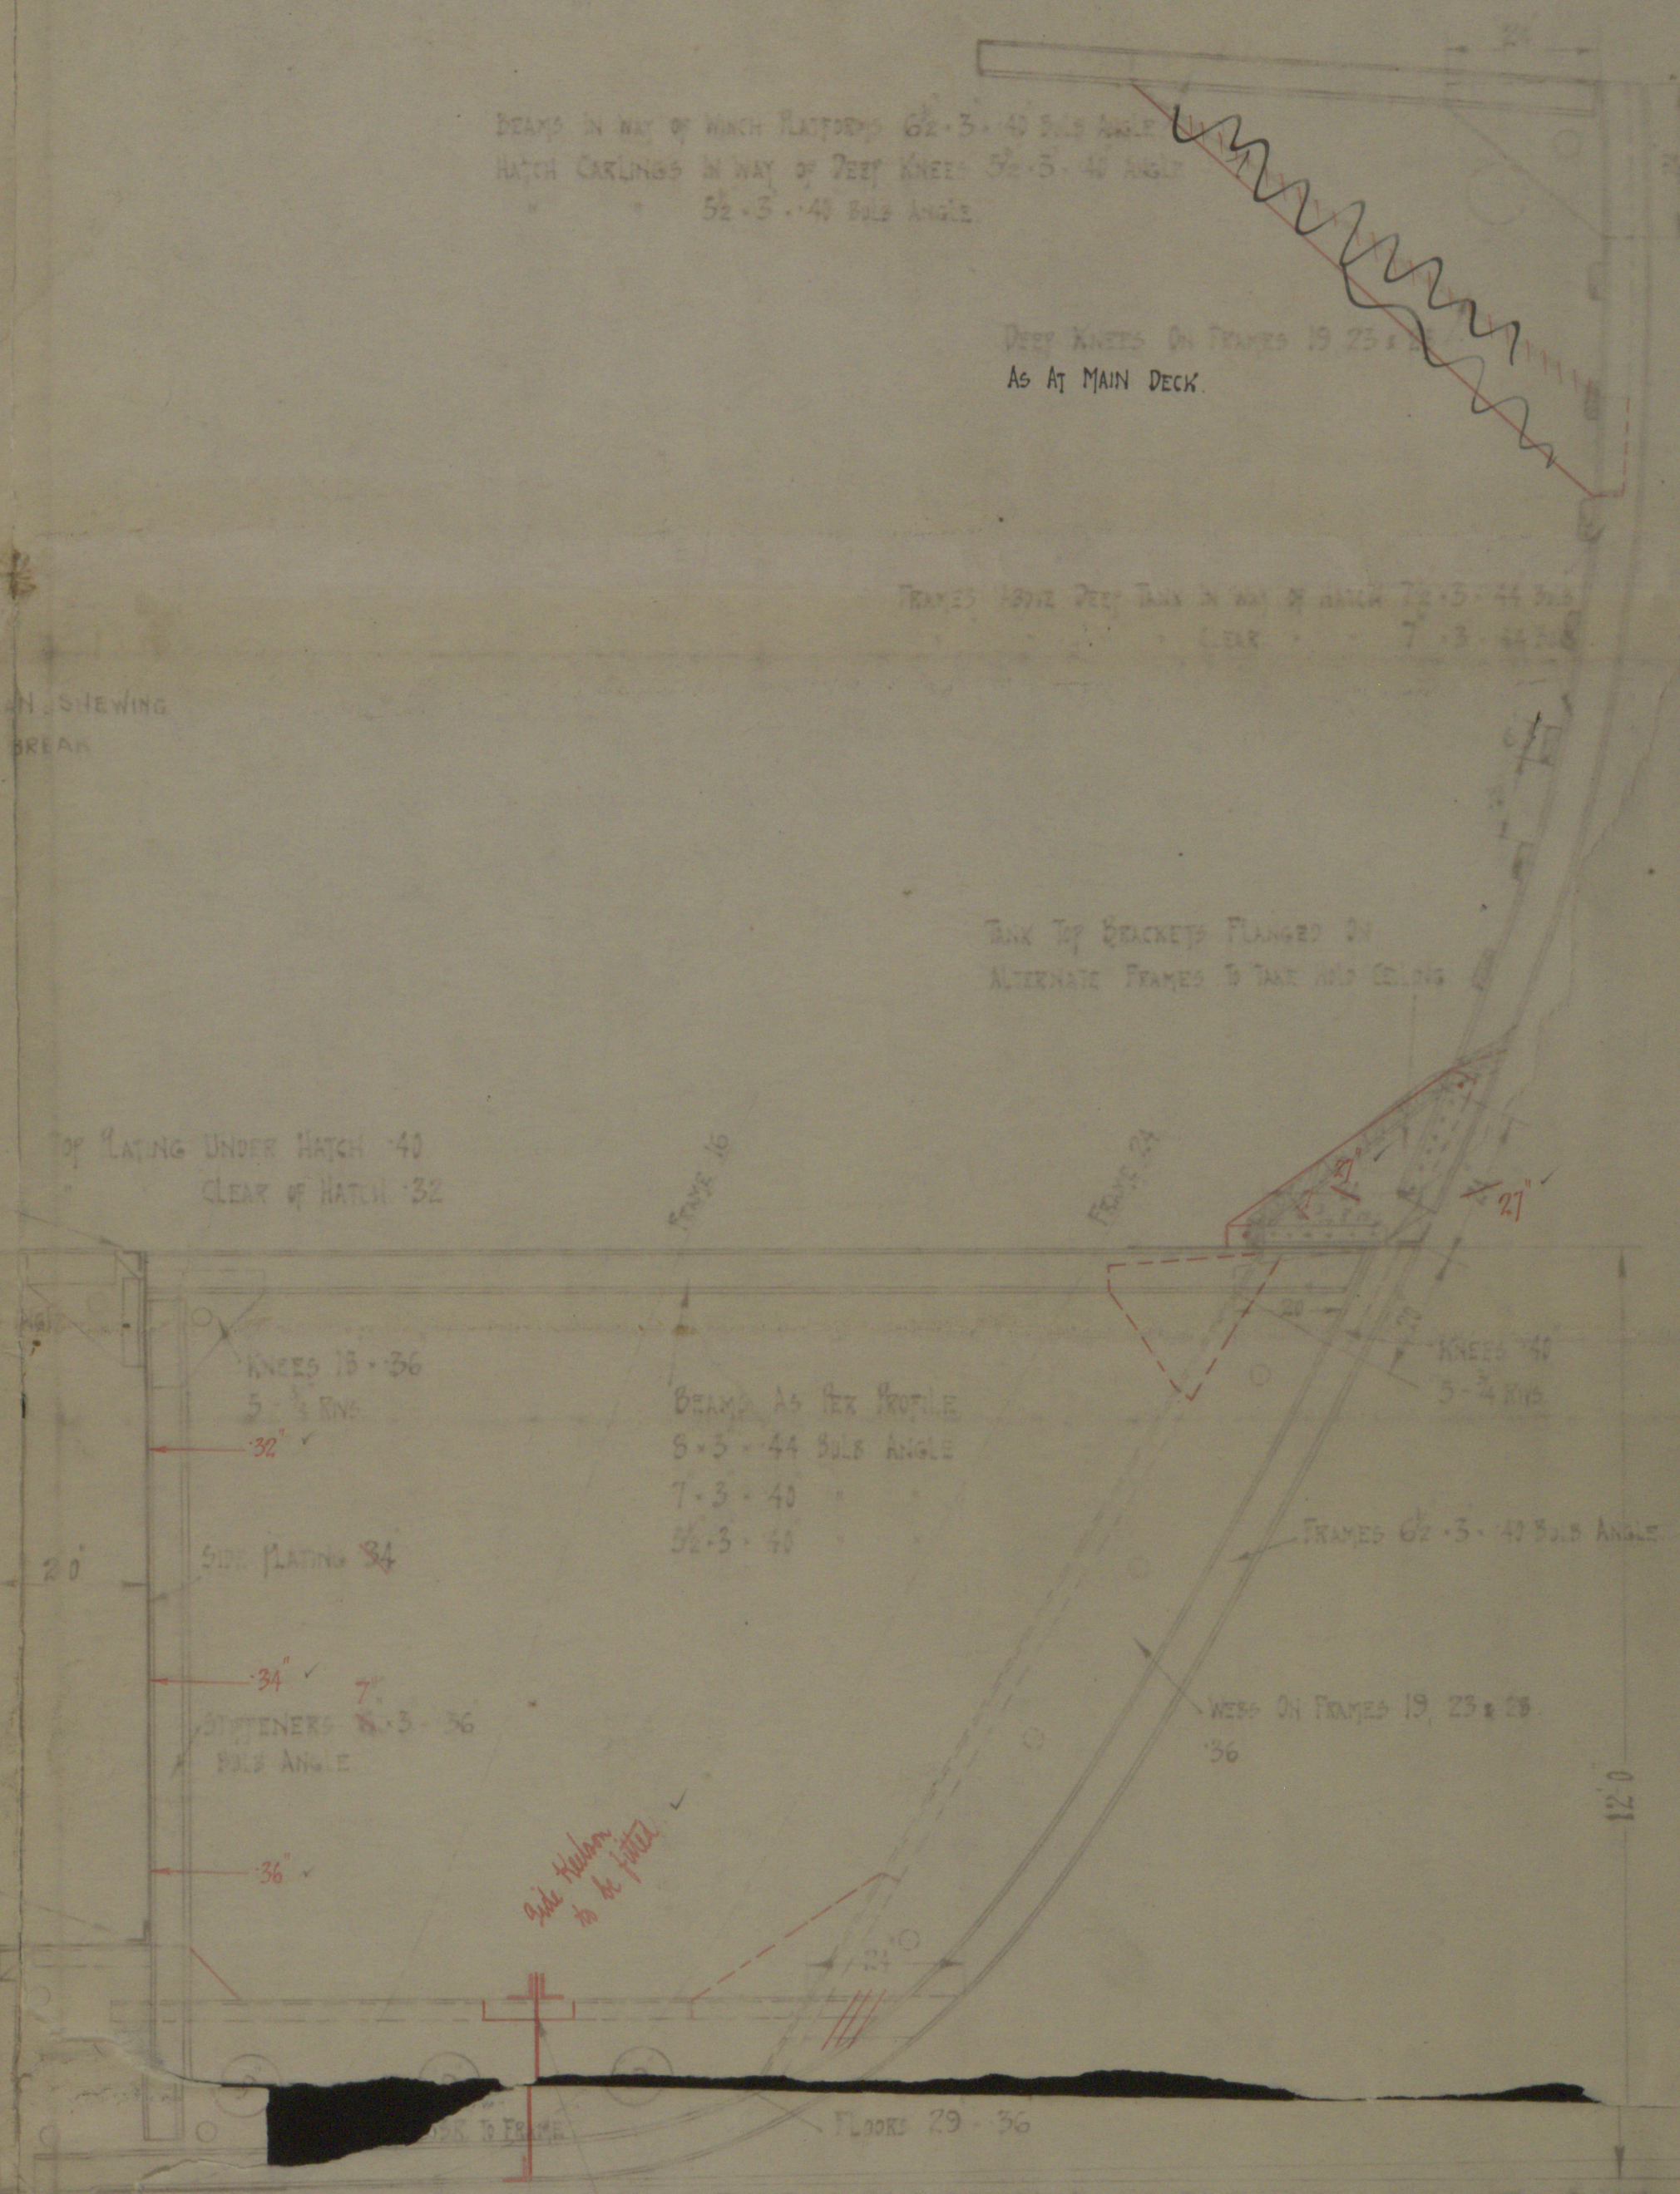

bbg  
24-12-18



Murdoch & Murray Ltd

No 291.

Amended Indship Section.

Shewing alterations in  
way of Extra wide hatches.

S. S. Moto

Grk Rep No 14635.