


Longitudinal Drift & Sailing Log & Butt of Blum
No. 150.

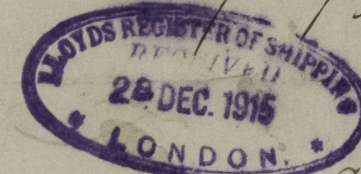

"Lip-Log" see Morris Adlesar

Cleveland Rept. 57

006641-006653-0098



© 2020

Lloyd's Register
Foundation

GREAT LAKES ENGINEERING
WORKS
JUN 28 1915
HULL DEPARTMENT

006641-006653-0098

LONGITUDINAL

150

Cleveland Surveyors

006641-006653-0098



© 2020

Lloyd's Register
Foundation