

Cochrane & Sons


No. 457.

Amended

Profile & Decks

5/s Variations

Hull Rpt. No. 22074

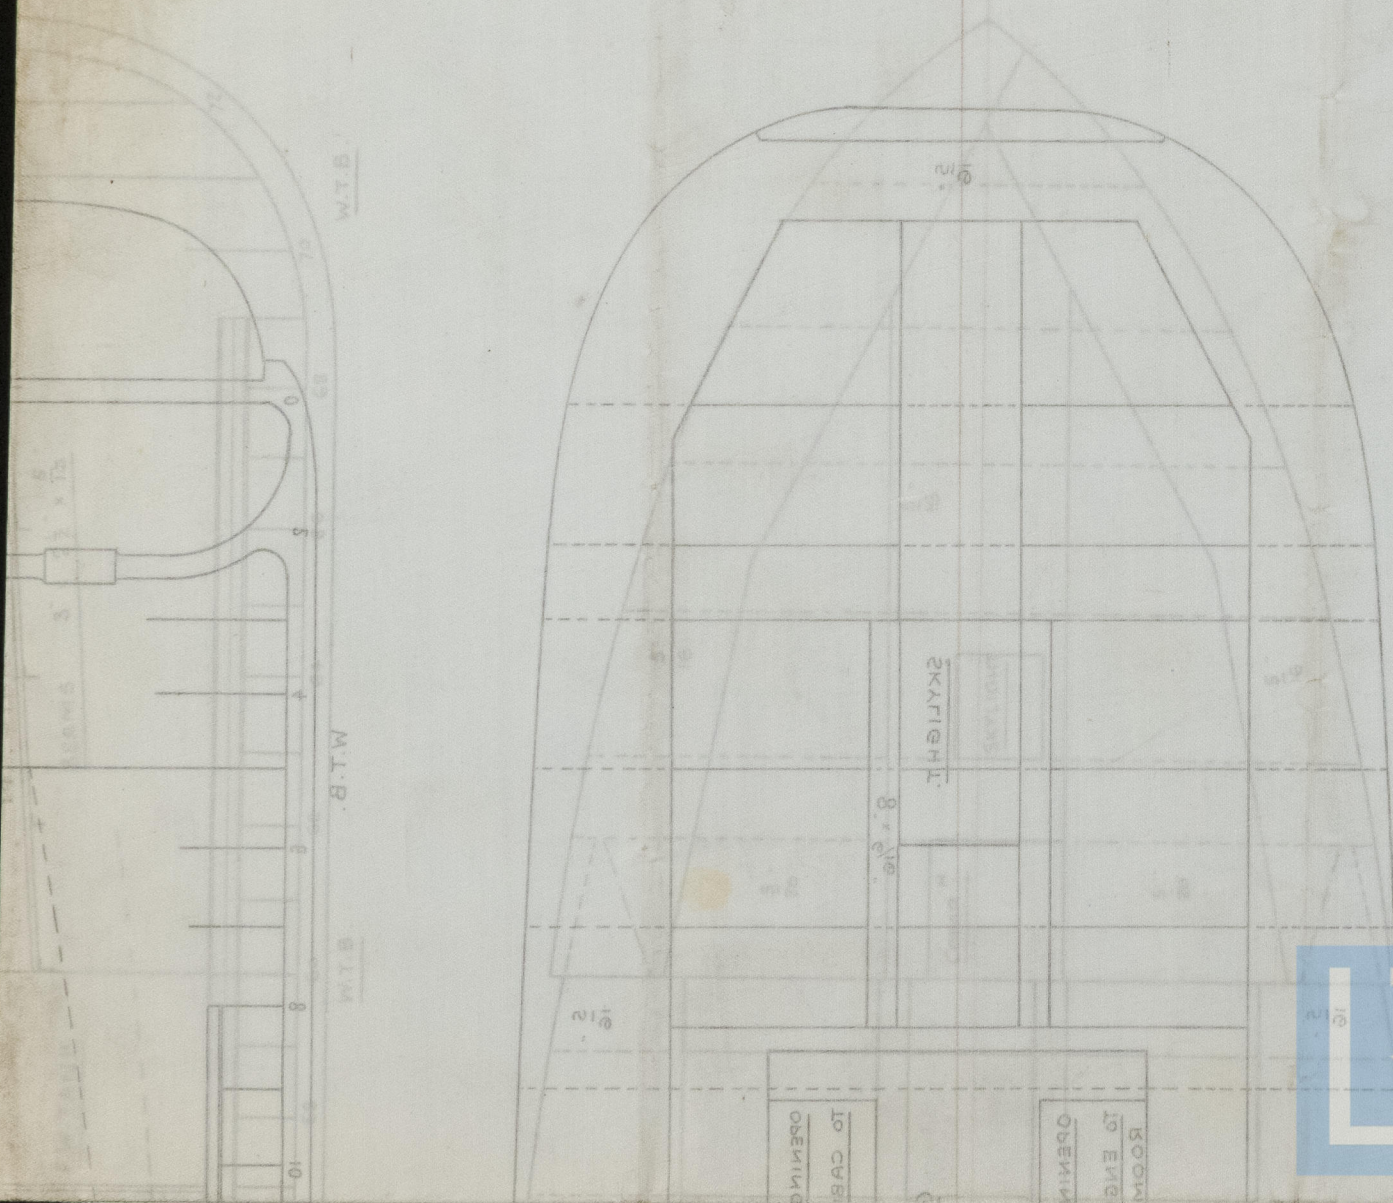

© 2020

Lloyd's Register
Foundation