

22.9.09

MIDSHIP SECTION

N^o 457

STEEL SCREW TRAWLER

DIM^s - 123'-4" B.P. x 21'-6" EX x 13'-4" MLD.

SCALE 1/2" = 1 FOOT.

PLAN No. 280h
FOR ENCLOSURE TO
Lloyds Surveyors
Hull FROM
COCHRANE & SONS.
SHIPBUILDERS, SELBY.
DATE 17/9/09 RK

TO CLASS 100 A.I. STEAM TRAWLER.
ENGINE & BOILER CASING AS PREVIOUSLY APPROVED.

DECK PLATED OVER IN WAY OF MACHINERY SPACE.

NUMERALS

1/2 BREADTH	✓ 10.7
1/2 GIRTH	✓ 20.42
DEPTH	✓ 13.79
	✓ 44.91 1 ST NO.
LENGTH AS PER RULE	✓ 122.21
	✓ 5488.45 2 ND NO.

PROPORTIONS


DEPTH TO LENGTH	8.8 ✓
BREADTH TO LENGTH	5.6 ✓

EQUIPMENT

✓ 1 ST BOWER ANCHOR	5 1/2 CWT. EX STOCK
✓ 2 ND " "	5 " " "
✓ 3 RD " "	2 3/4 " " "
✓ 105 FATHOMS	1 1/6" CABLE
✓ 60 " "	6" HAWSER
✓ 60 " "	4 1/2" WARP

RIVETING

BUTTS OF SHELL PLATING LAPPED & DOUBLE RIVETED, EXCEPT GARBOARD & SHEER STRAKE, WHICH ARE TO BE STRAPPED. ALL LANDING EDGES TO BE DOUBLE RIVETED, EXCEPT TOP EDGE OF SHEER STRAKE WHICH IS TO BE SINGLE RIVETED. BUTTS OF STRINGER & TIE PLATES OVERLAPPED & DOUBLE RIVETED.

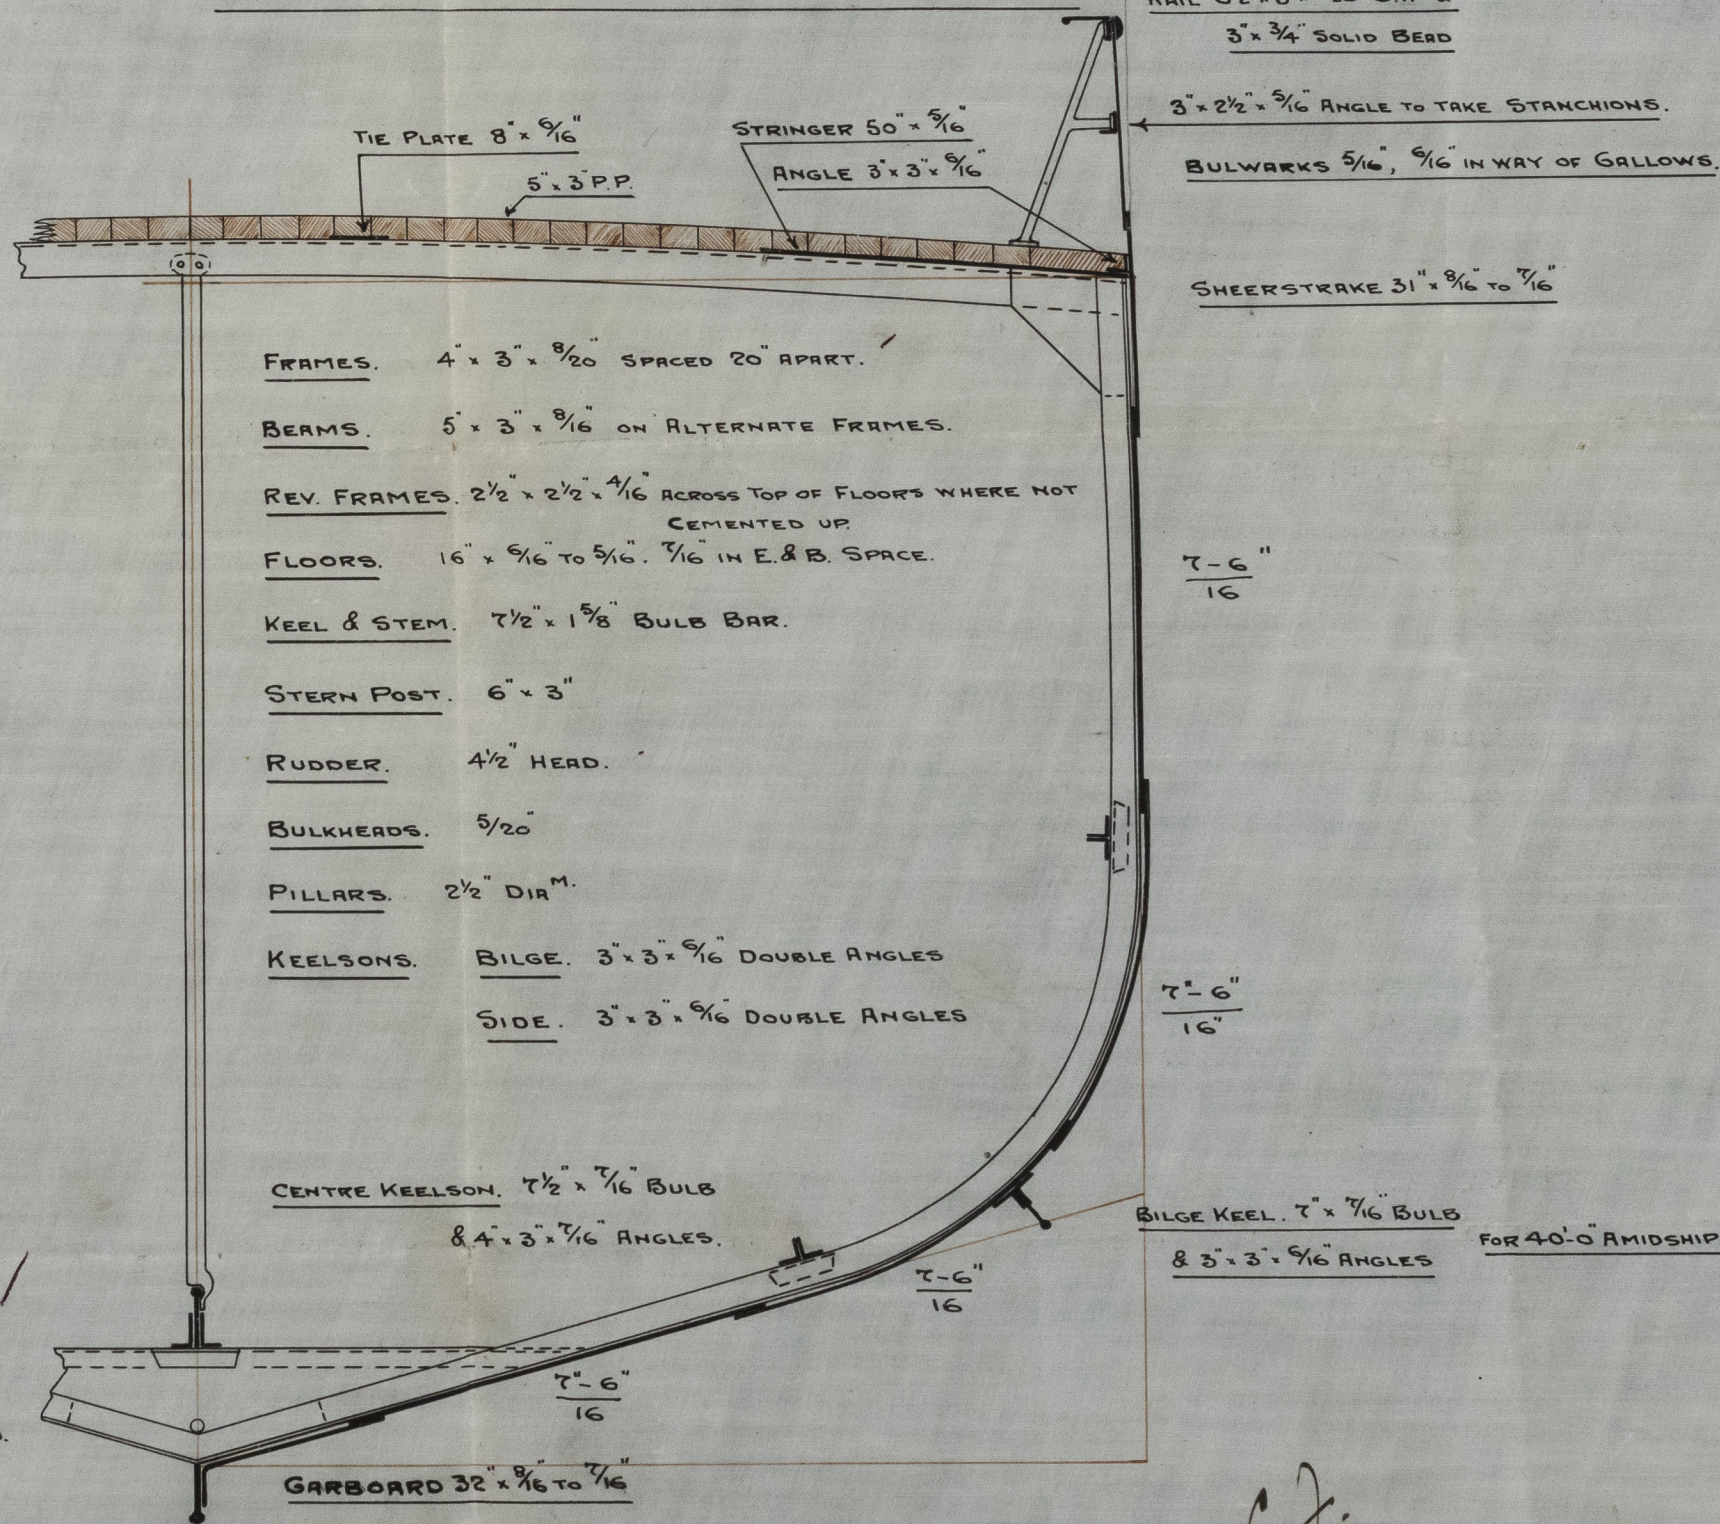

No 457
Cochrane & Sons

Handwritten:
C.F.
22/9/09

Cochran & Sons


No 457.

Amended.

Midship Section.

s/s Varanis

Hull Rph No: 22074

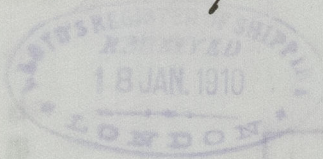





© 2020

Lloyd's Register
Foundation