

PLAN No. 670
 FOR ENCLOSURE TO
 Messrs Lloyd's Surveyors
 Hull
 FROM
 COCHRANE & SONS,
 SHIPBUILDERS, SEELY.
 DATE Sept 11/11 *RR*

MIDSHIP SECTION


STEEL SCREW TRAWLERS

NOS 489-90-1
 DIM^{NS} LEN 131'-8" x 23'-0" EX. x 12'-9" DEPTH MOULDED
 SCALE 2" = ONE FOOT

10072
 Messrs Lloyd's Surveyors
 Hull

15/2/11 *RR*

TO CLASS 100-A1 FOR FISHING PURPOSES. DECK PLATED OVER IN WAY OF
 MACHINERY SPACE. ENGINE & BOILER CASING AS PREVIOUSLY APPROVED

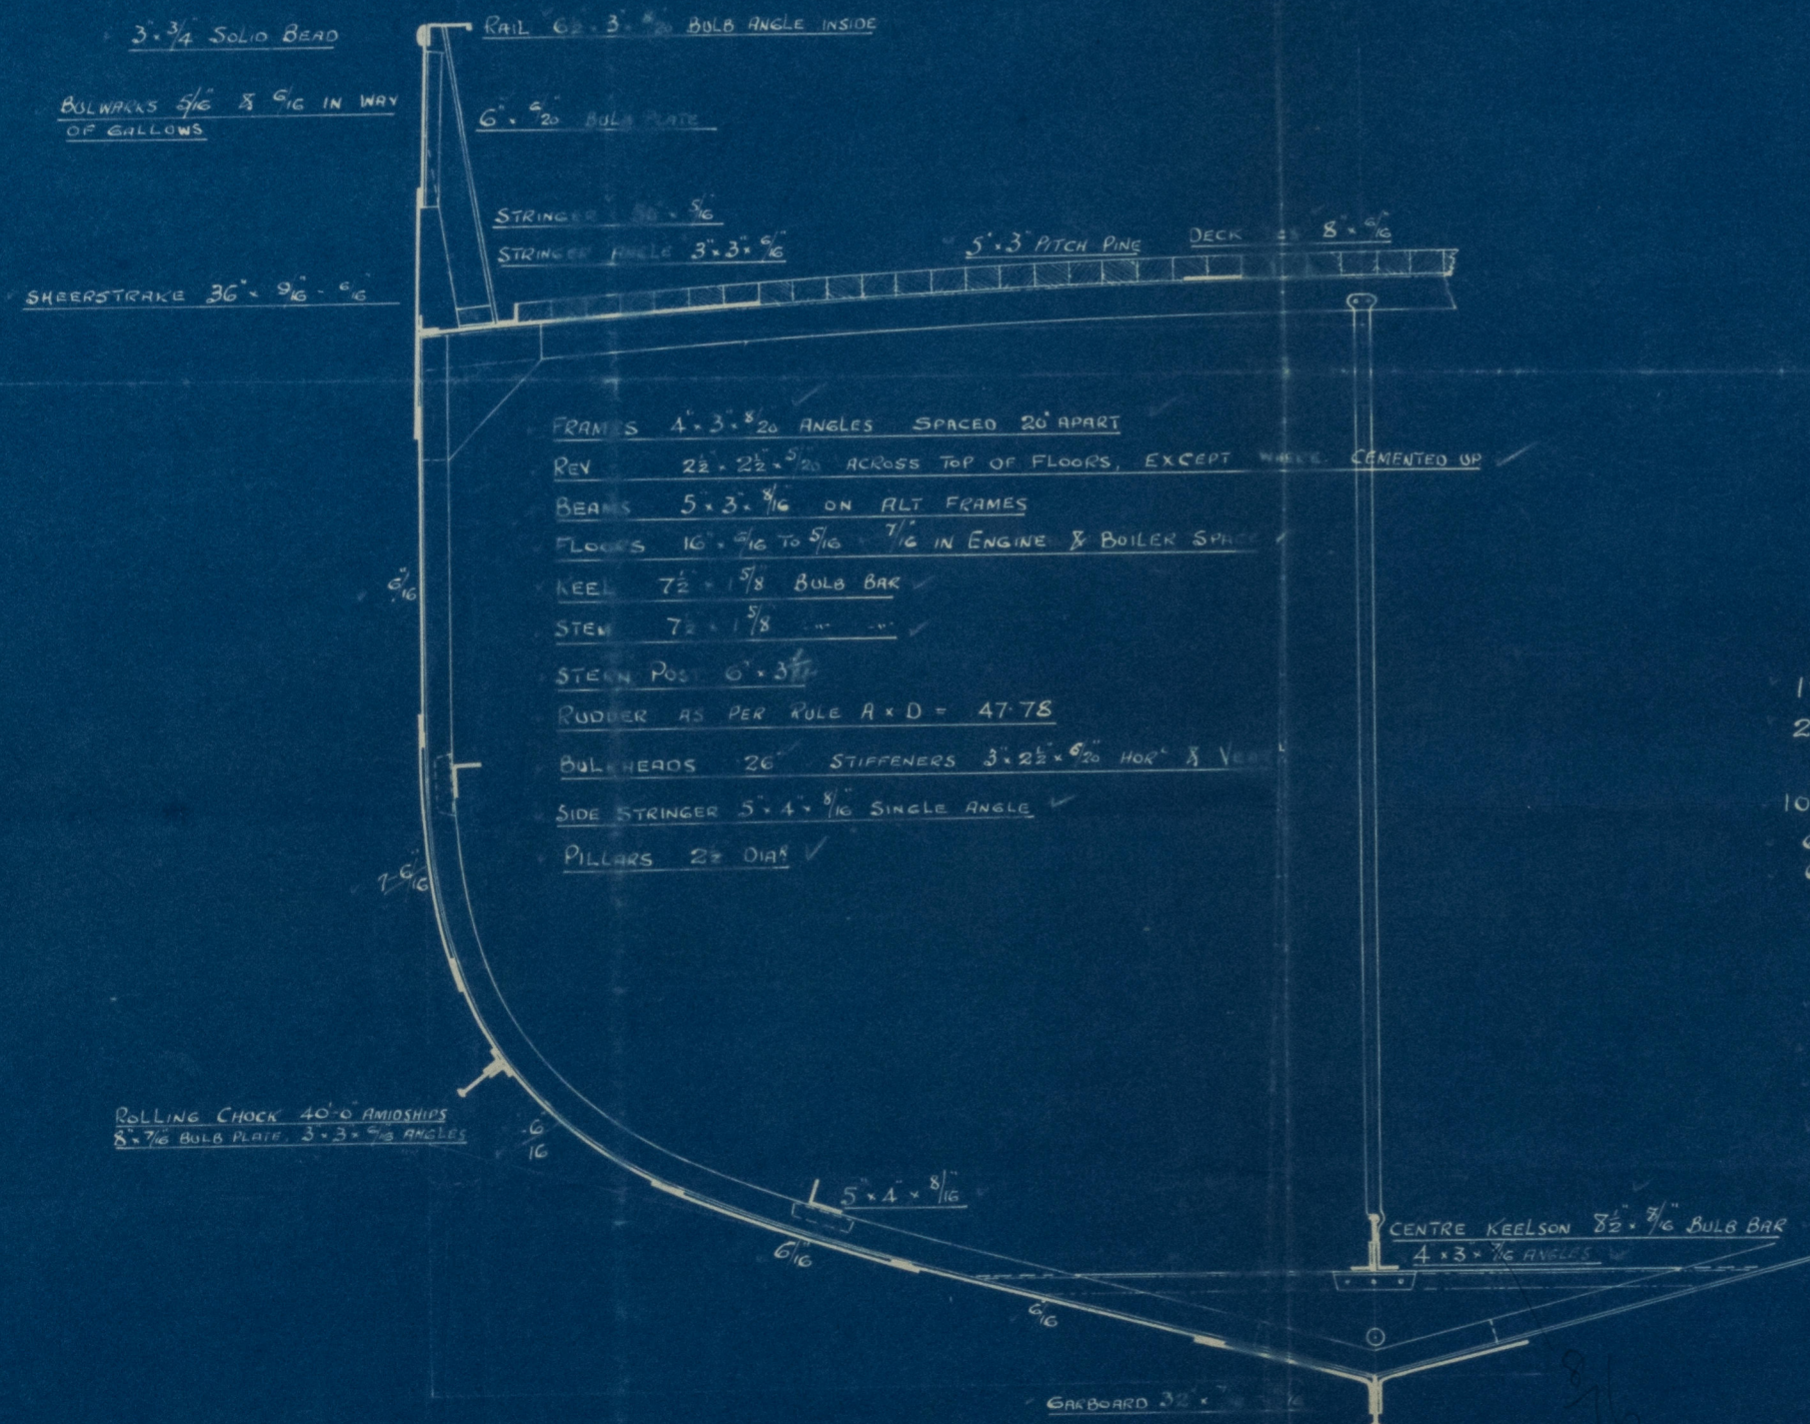

NUMERALS

B+D	=	35.63
L x (B+D)	=	4691.70
	=	4750.54

PROPORTIONS

L/B	=	10.33	10.45
	=	5.75	5.82

EQUIPMENT

1 ST BOWT ANCHOR	5 3/4 CWTs EX STOCK	✓
2 ND " "	5 1/4 " " " "	✓
KEDGE " "	3 " " " "	✓
105 FATHOMS	1 1/2" CABLE	✓
60 " "	6" HAWSER	✓
60 " "	5" WARP	✓

RIVETING

BUTTS OF SHELL PLATING LAPPED & DOUBLE RIVETED.
 EXCEPT GASKBOARD & SHEERSTRAKE WHICH ARE TO BE
 STRAPPED & DOUBLE RIVETED. LANDINGS DOUBLE RIVETED
 BULWARKS SINGLE RIVETED

Cochrane & Sons.

N^o 489. 490. 491.

Duplicate

Midship Section.

Lord Salisbury Hull Rpt No. 24208

Michael Angelo . . . 24222

Lord Knollys . . . 24266

5/17



© 2021

Lloyd's Register
Foundation

006654-006665-0162