
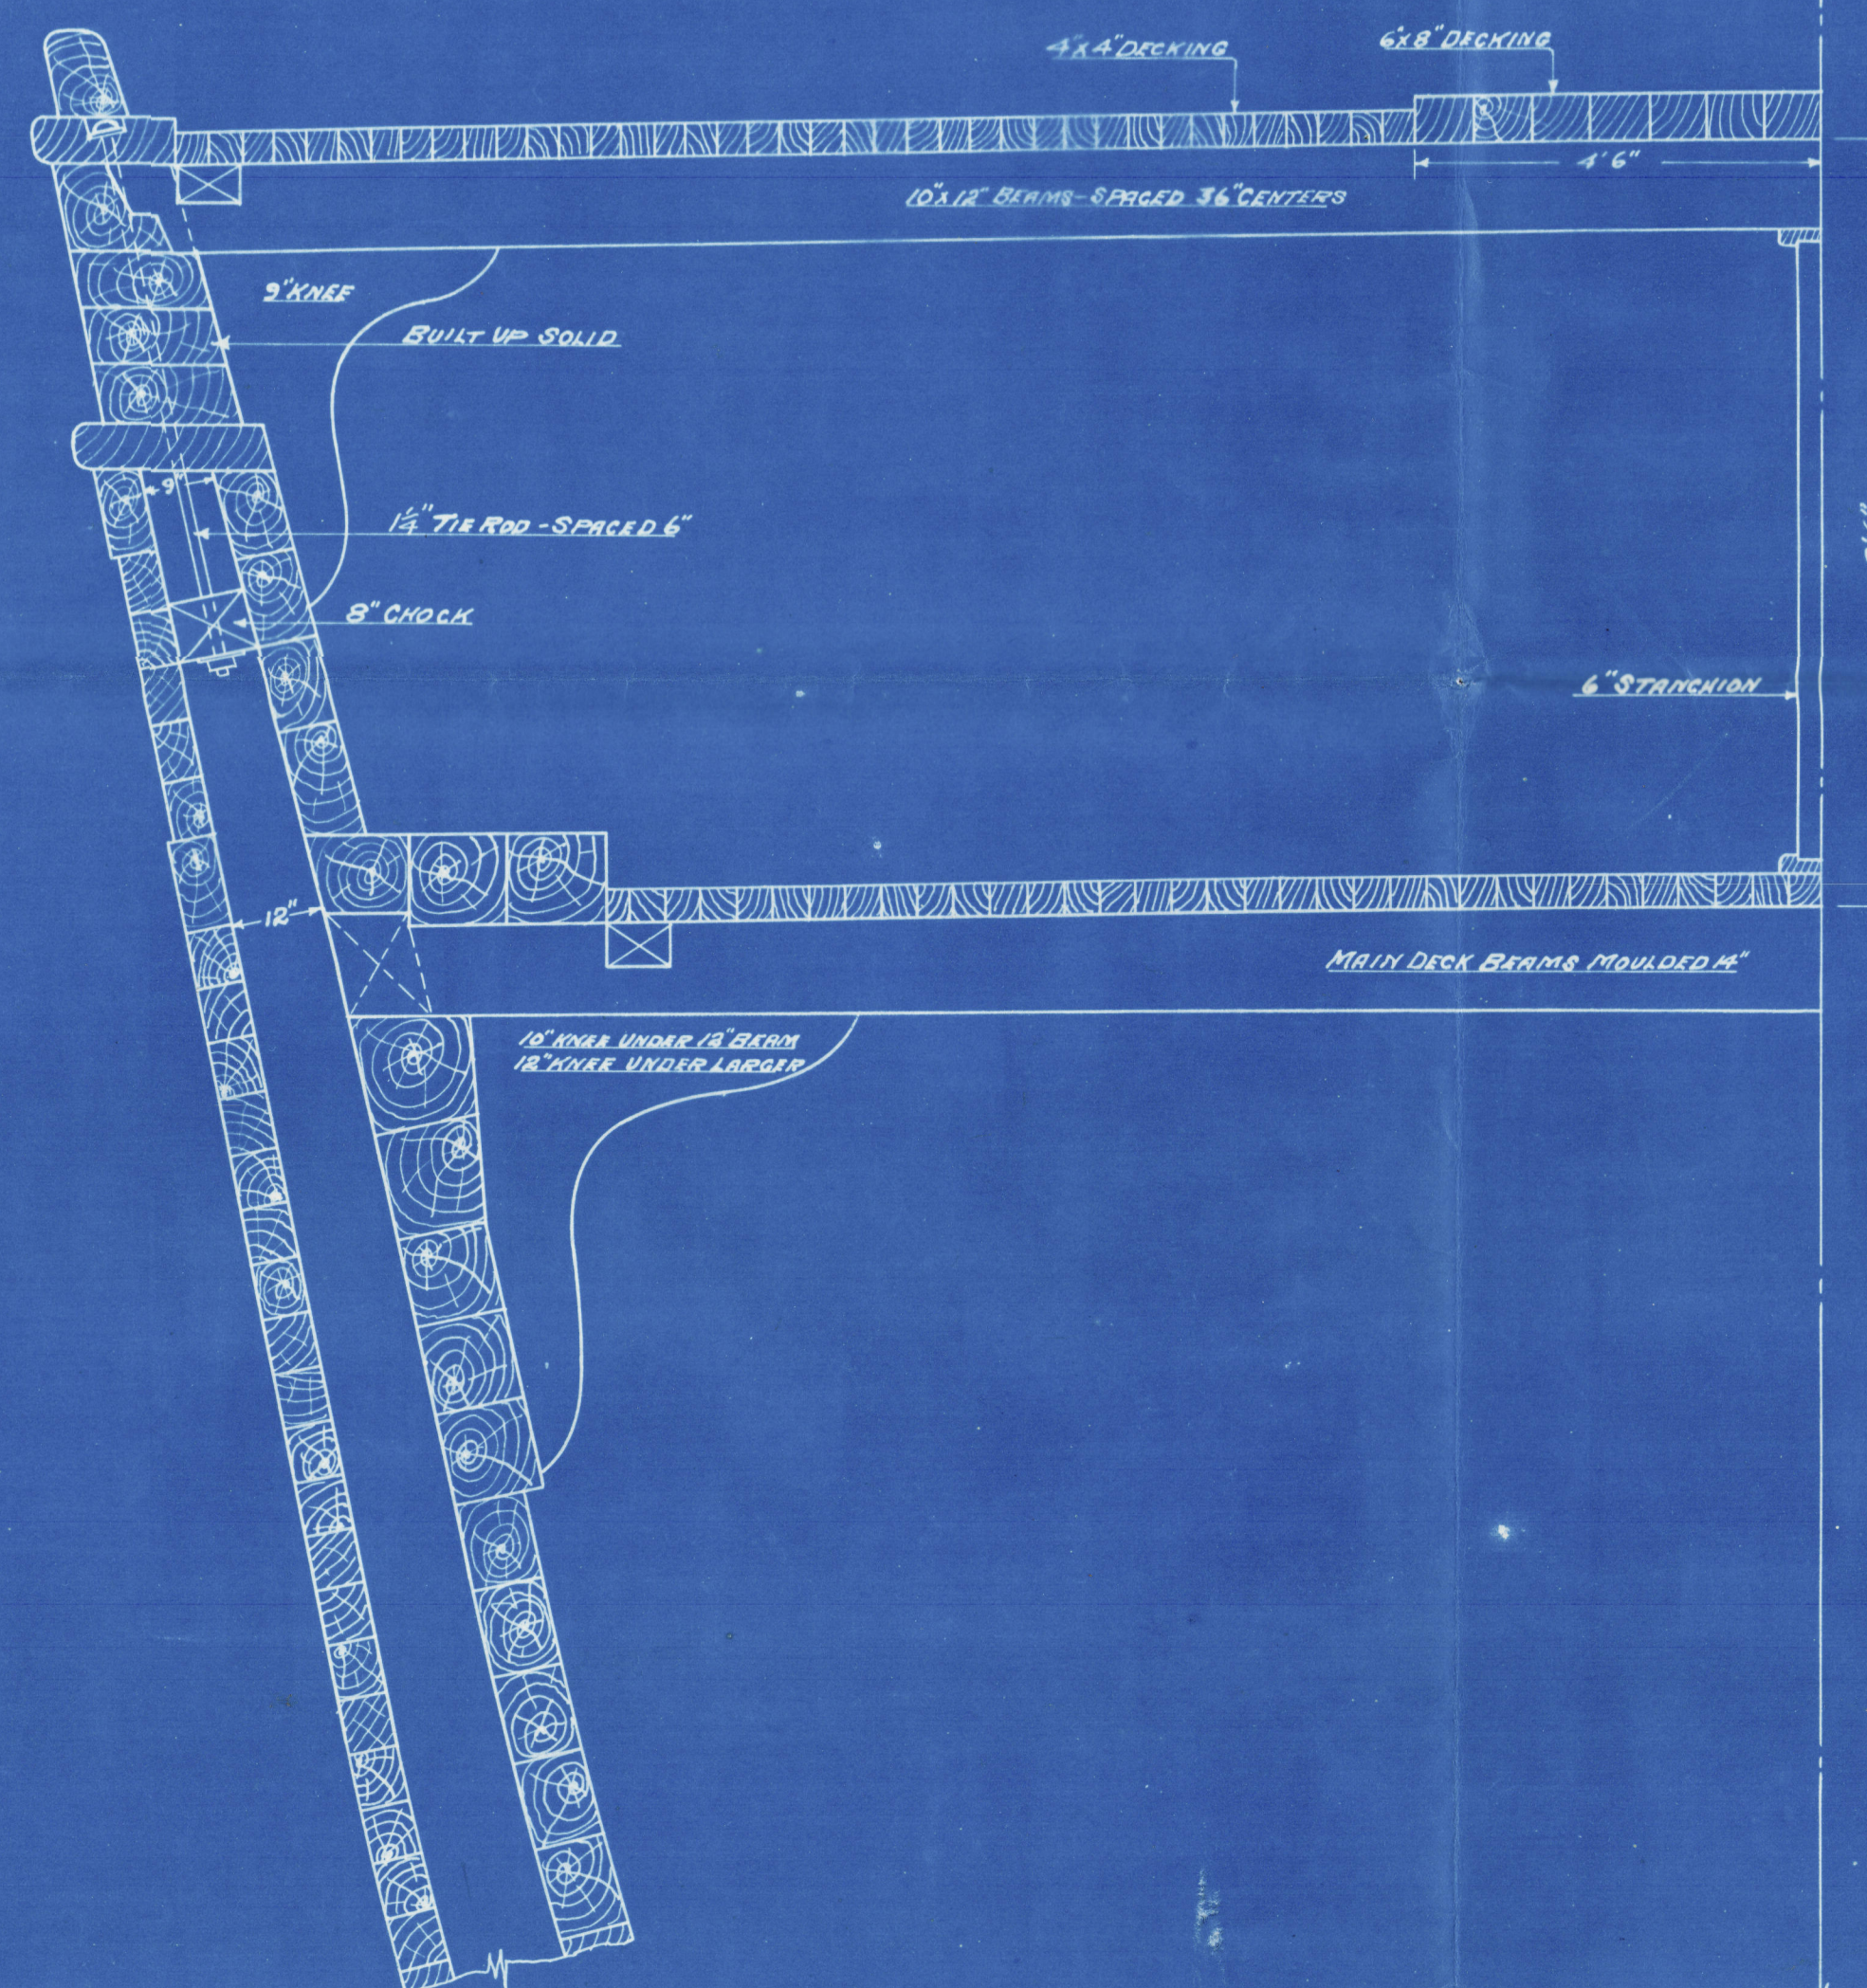


DETAIL OF STEEL REINFORCING FOR FRAME AT TURN OF BARGE
SCALE 3" = 1 FOOT.

Equipment

Manoro (Manila)	1 of 90	"	10"	"
Harp	1	" 90	"	6" "

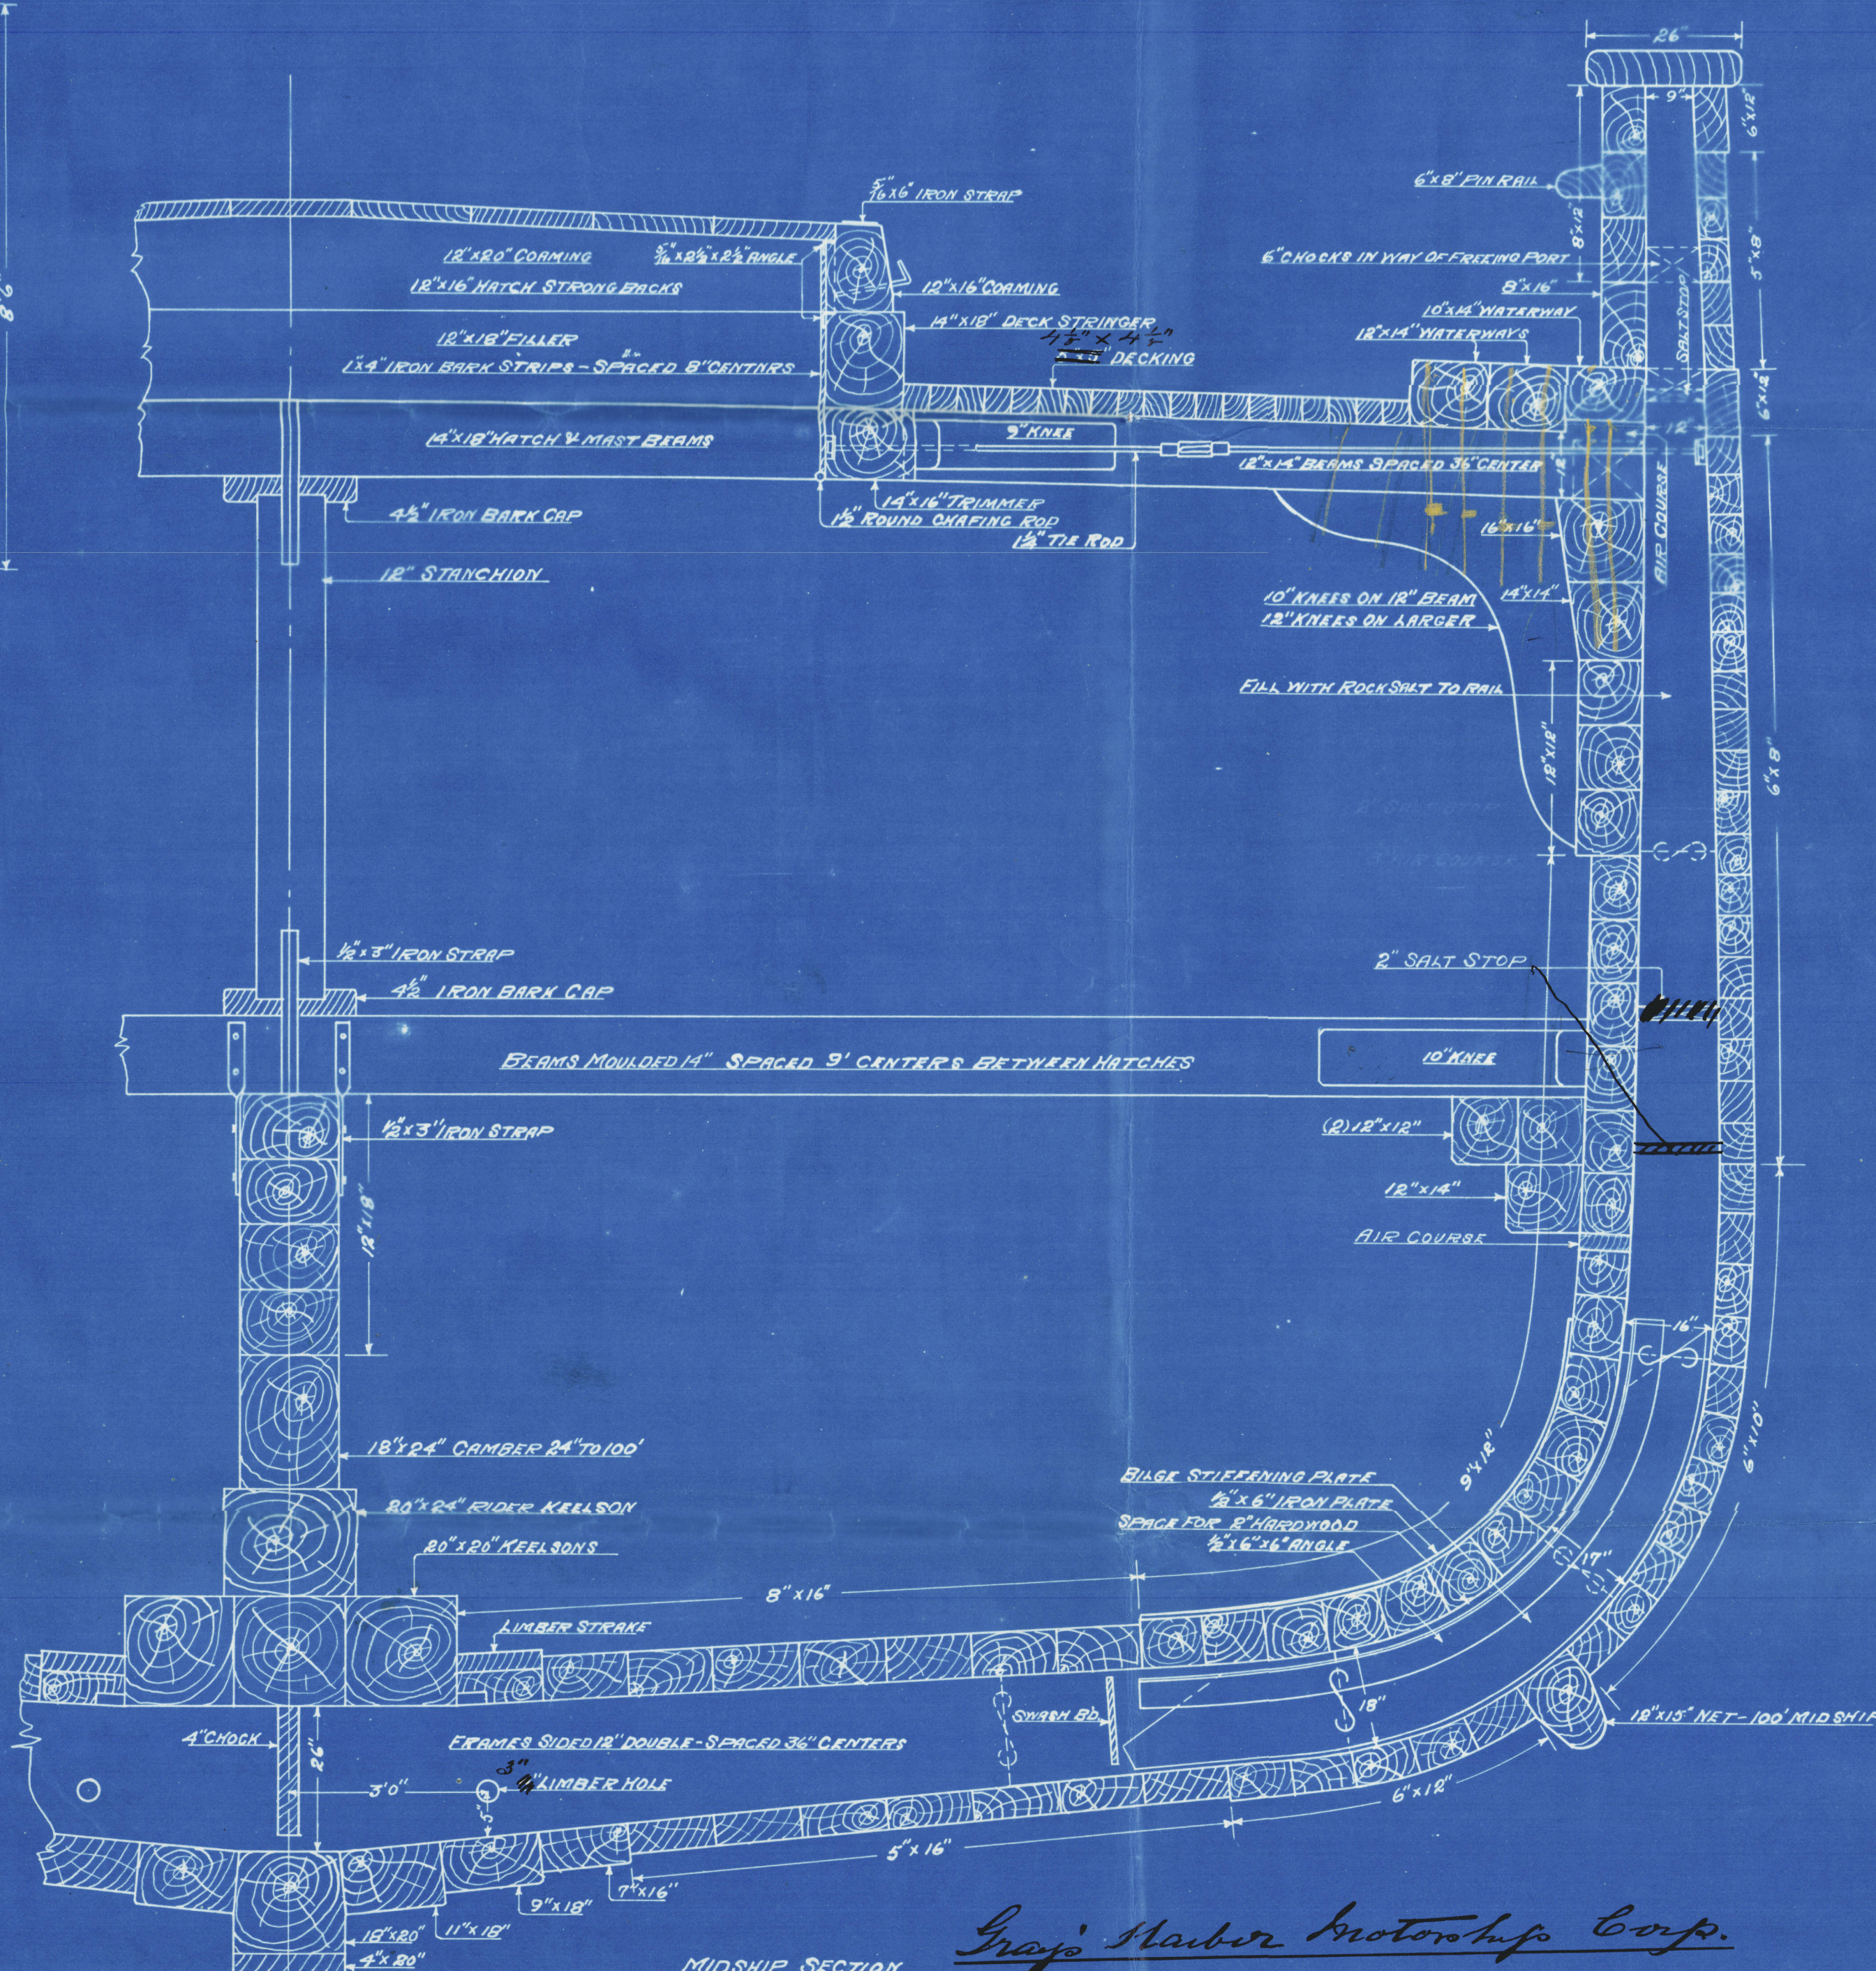

Gray's Harbor Motorship Corp.

"5 masted sailing barkentine
Forest Friend" Ind no. 29

Dmitriyev

LxL 239' 6" x 44' 0" tot. x 21' 6 1/2" Md.

240FT. 5 MAST BARKENTINE
CAP. 1300M. FT. FIR LUMBER

MIDSHIP & FORECASTLE

* SECTIONS

LENGTH OVERALL _____ 260' 0"
LENGTH BETWEEN PERAPS. _____ 240' 0"
BEAM EXTREME _____ 44' 0"
DEPTH MOULDED _____ 21' 6"

DRAWN BY T.B.S. DR.# 3063.E
JUNE 14TH 1919. SCALE $\frac{1}{2}$ " = 1 FOOT.

GRAYS HARBOR
MOTORSHIP CORPORATION
ABERDEEN YAKMA

Gray's Harbor Motorship Corporation

5 masted barkentine "FOREST FRIEND"
Yard No 29

L.H.L. 239' 6" x 44' 0" net. x 31' 6 1/2" Md.

Midship Section



© 2021

Lloyd's Register
Foundation

006654-006665-0177