

— B TYPE. —  
MIDSHIP SECTION. No 310  
— STANDARD STEAMER. —  
LENGTH B.P. 400'-0."  
BREADTH M<sup>LD</sup> 52'-0". EX 52'-3".  
DEPTH M<sup>LD</sup> UPPER DS 31'-0."  
DEPTH IN HOLD CB. 28'-5½". TO UPPER DS  
— SCALE ½" = ONE FOOT —  
— CLASS 100A1 2 DECKS —



R. Thompson & Sons

Nº 310

Mild. Section


Standard A

Converted to B.

<sup>66.</sup> S. Barraeco. <sup>90</sup>

SUNDERLAND RPT. NO. 27688

S/S KUSUYAMA MARU<sup>h</sup>

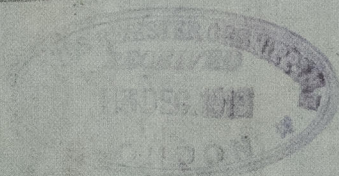

© 2021

Lloyd's Register  
Foundation

006666-006679-0064