




13.2.19

— "B" TYPE No 310 —
STANDARD STEAMER.
PROFILE & DECK PLANS
400'-0" B.P. x 52'-0" MLD x 31'-0" MLD
SCALE 1/8" = 1'-0"
TO CLASS 100 A1-2 DECK

CONVERTED FROM A TO B TYPE
AFTER PARTLY CONSTRUCTED.

 

Build Pillar to be fitted at hatch ends under upper deck firmly connected at heads & heels

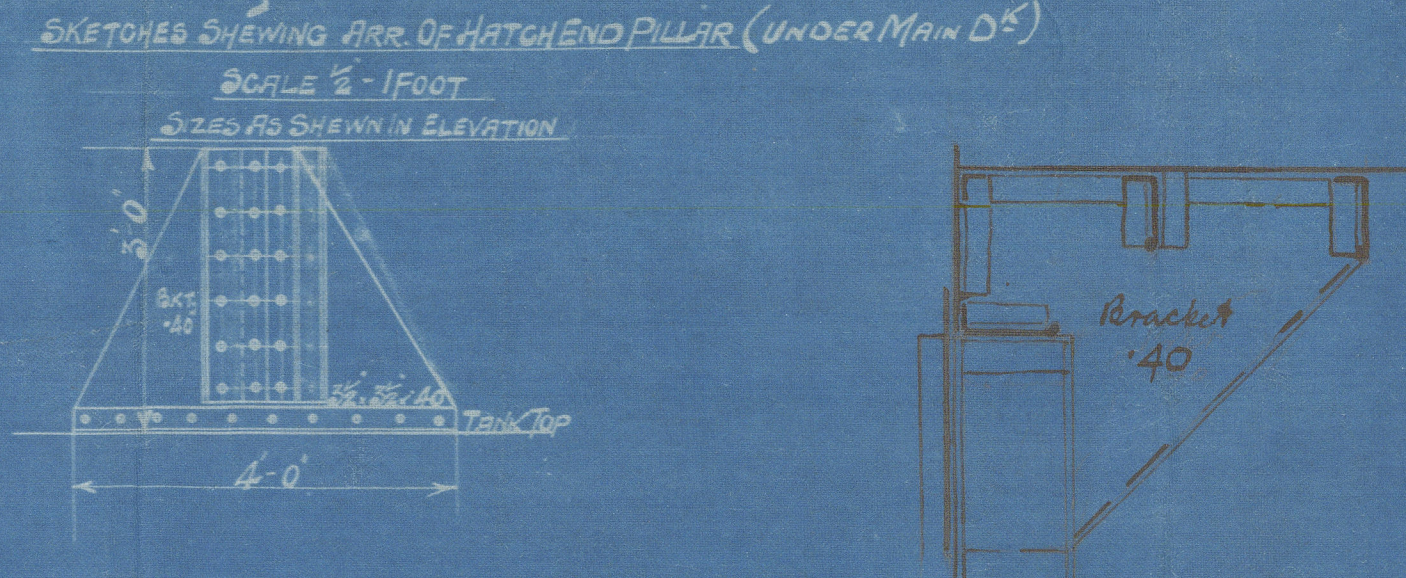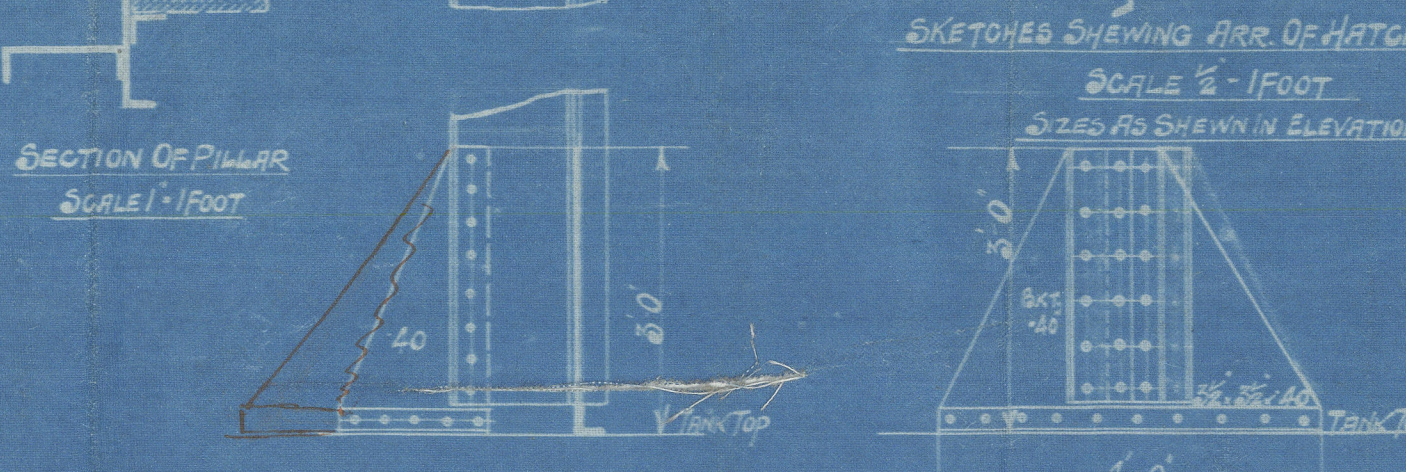

— BRIDGE DECK —

— UPPER DECK —

R. Thompson & Sons

Profile & Decks


S.S. No 310

Standard A


Converted to B type

S.S. "Barracoo"

SUNDERLAND RPT. NO. 27688

 

S/S. "KUSUYAMA MARU"

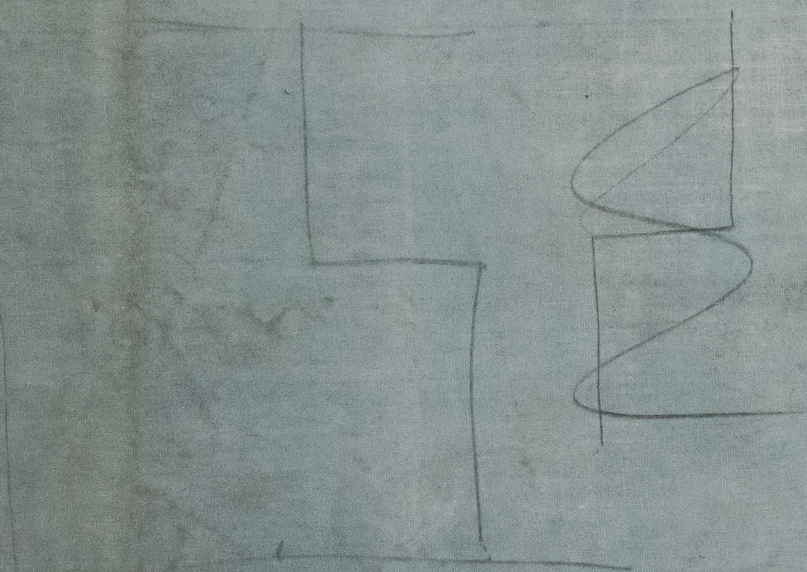

006666 - 006679 - 0065



© 2021

Lloyd's Register
Foundation