


Nº 191-2
GENERAL ARRANGEMENT.

SCALE $\frac{1}{16}$ " = ONE FT.
450'-0" x 60'-0" x 37'-0"
MOULDED LOAD DRAUGHT 26'-4"

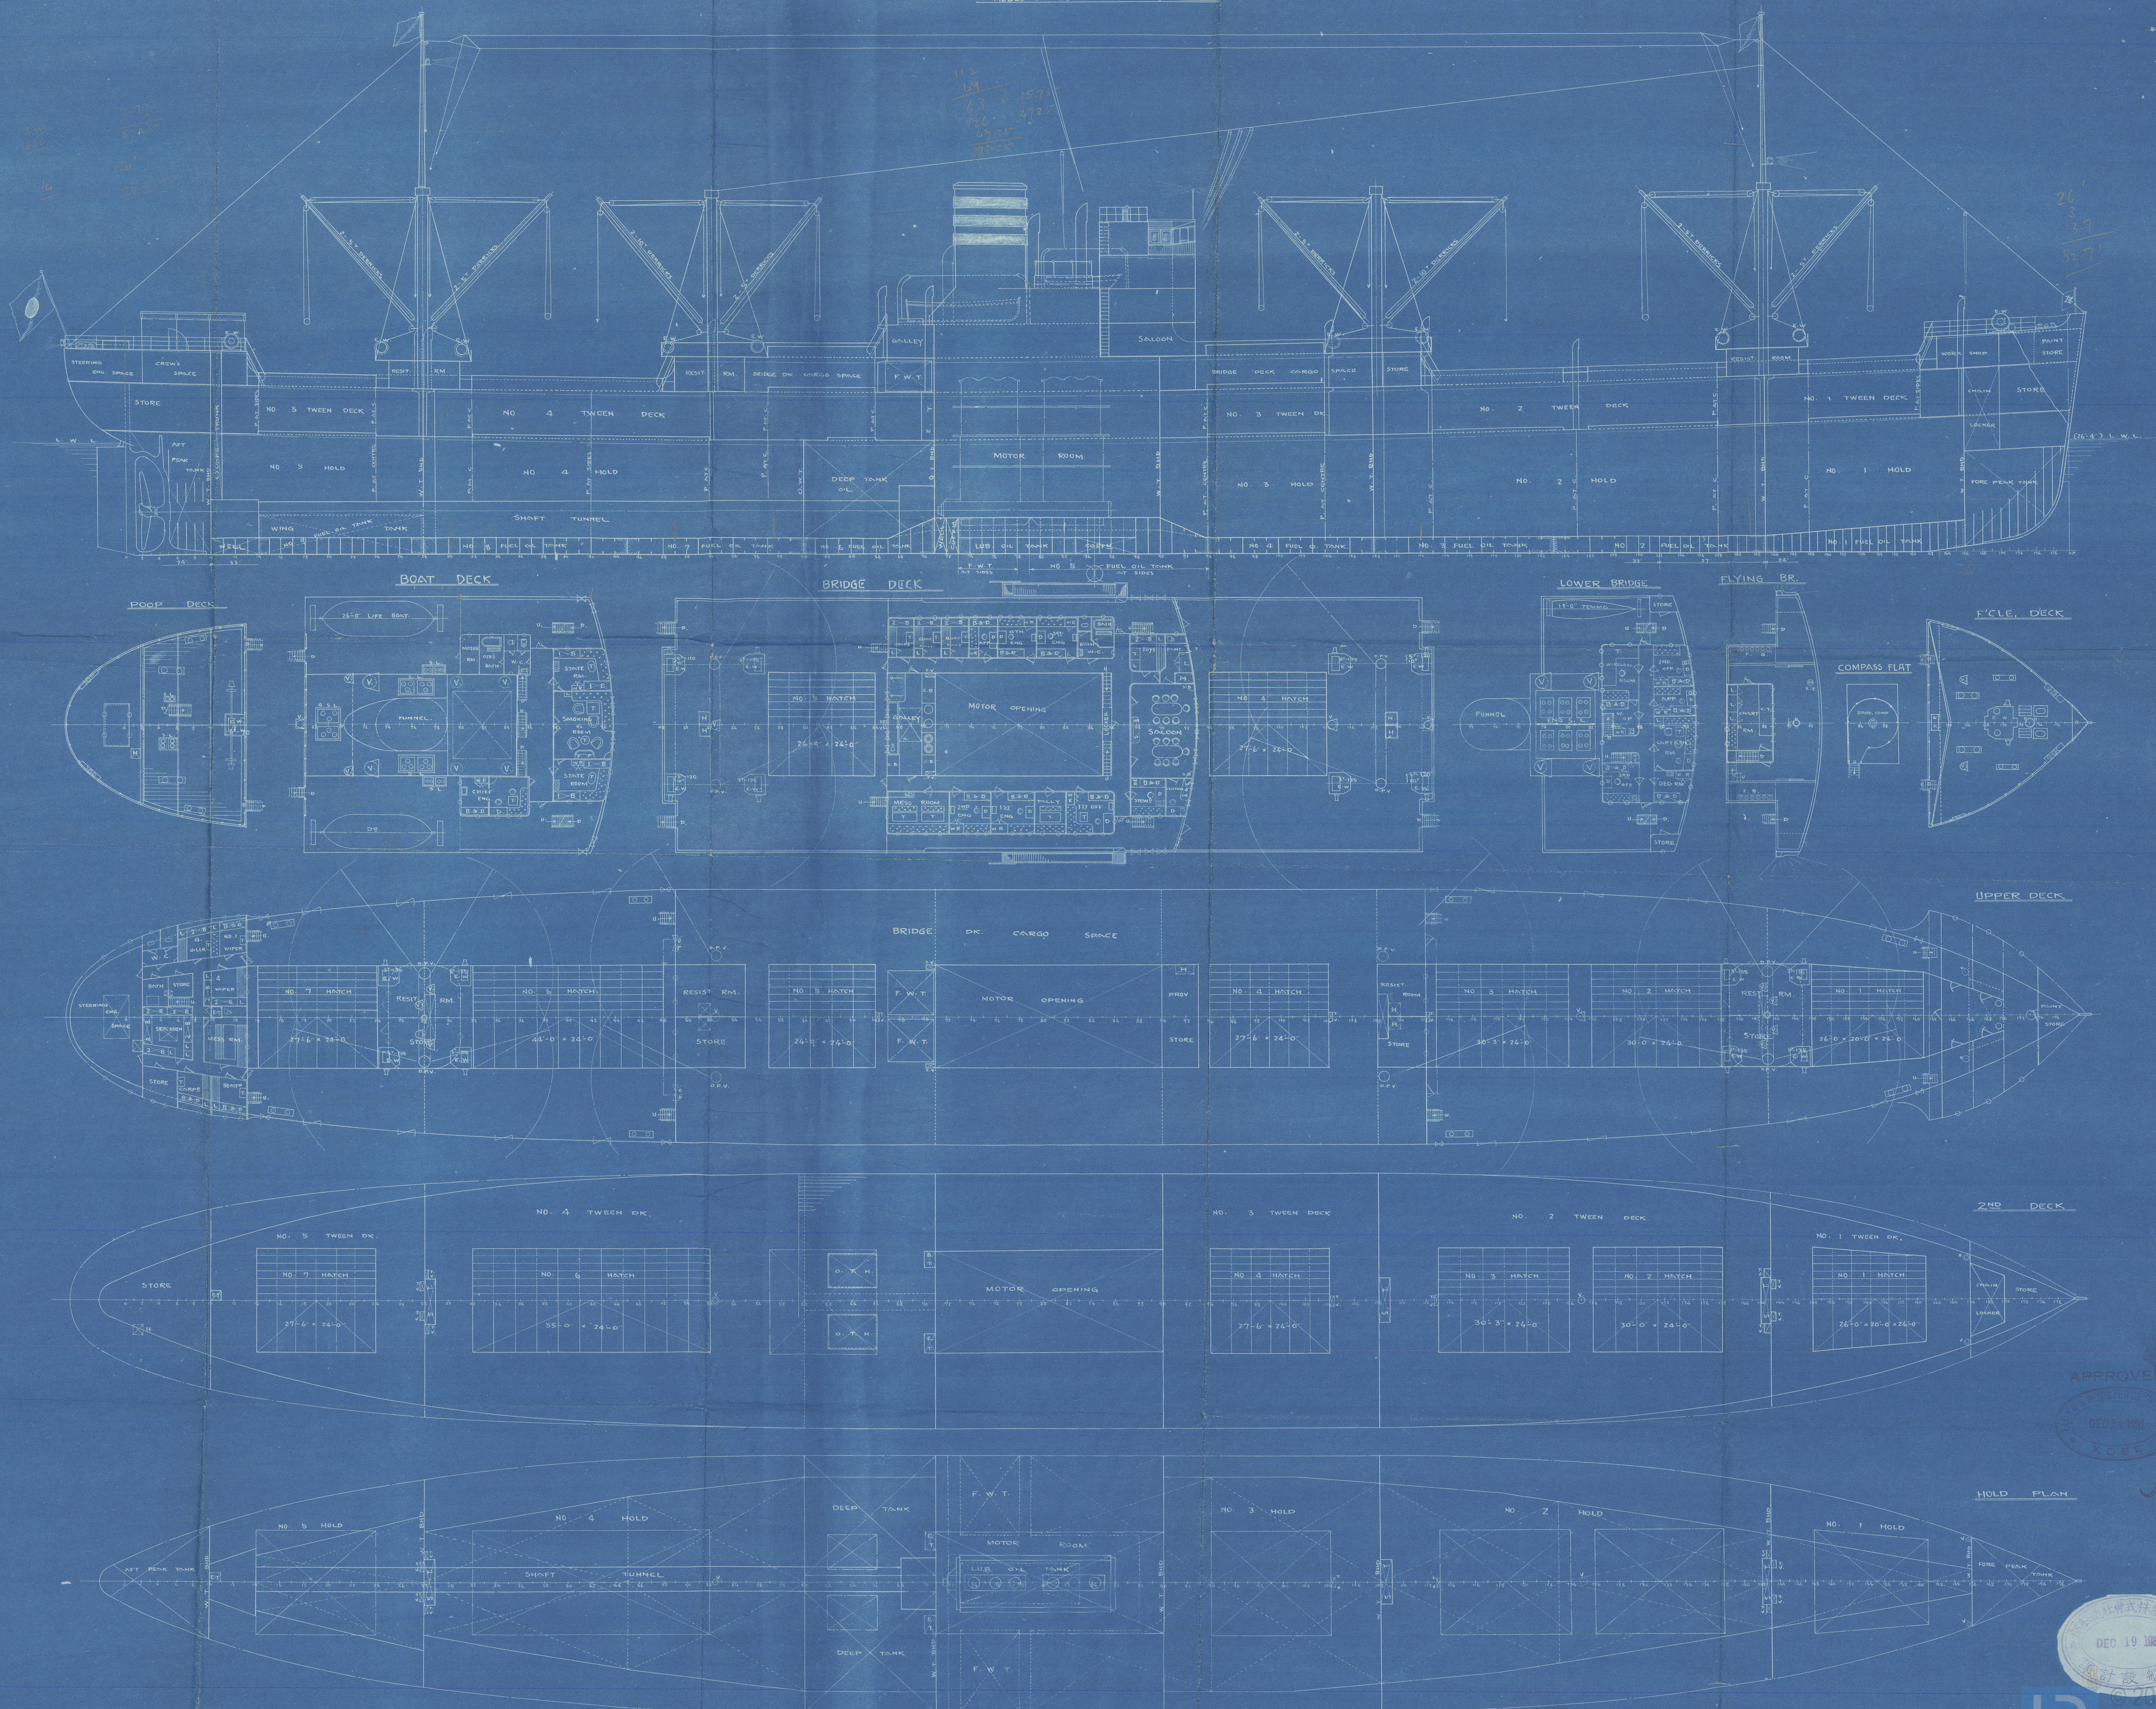

APPROVED
DEC 19 1901
K.B.E.

DEC 19 1901
LLOYD'S REGISTER

"AZUMASAN MARU"

"AMAGISAN MARU"

~~XXXXXXXXXX~~

General Arrangt.

GEN. BOX NO 84

006666-006679-0232

hndm



© 2021

Lloyd's Register
Foundation